


2B		10,11	0+858.8 RT.	1+080.0 RT.	0.17 HA±	ALL R. T. & I.
3	POSLUSZNY, ROBERT F. & PHYLLIS D.	10,11	REV. 0+950.7 LT.	1+080.0 LT.	0.10HA±	ALL R. T. & I.
			REV. 0+962.0 LT.	1+041.0 LT.		CONST. (T) 0.01HA±
			REV. 0+966.7 LT.	REV. 0+997.5 LT.		DITCH (P) 88.2SM±
			REV. 1+003.0 LT.	REV. 1+037.5 LT.		SLOPE (P) 96.3SM±
4	GREEN MOUNTAIN POWER CORP.					
5	CHAMPLAIN VALLEY TELECOM					

0200009 200 1805 HP

ACCT. TFrench
 \\vaot_cadd\fillingcabinet\$\93c065\Right0fWay\rc065d.dgn
 DATE PLOTTED 29-MAR-2001
 rc065dl.i

DR. (P)- DRAINAGE RIGHT
 DIT. (P)- DITCHING RIGHT
 CH. (P)- CHANNEL RT.
 DRIVE (T)- DRIVE RIGHT
 CUL. (P)- CULVERT RIGHT
 [W]- WATER SOURCES

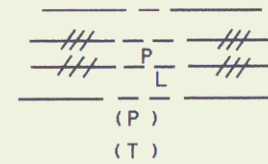

PRESENT R.O.W.
 TAKING WITHOUT ACCESS
 TAKING WITHOUT ACCESS ALON
 TAKING WITH ACCESS
 PERMANENT EASEMENT
 TEMPORARY EASEMENT