



PLAN  
SCALE: 1:100

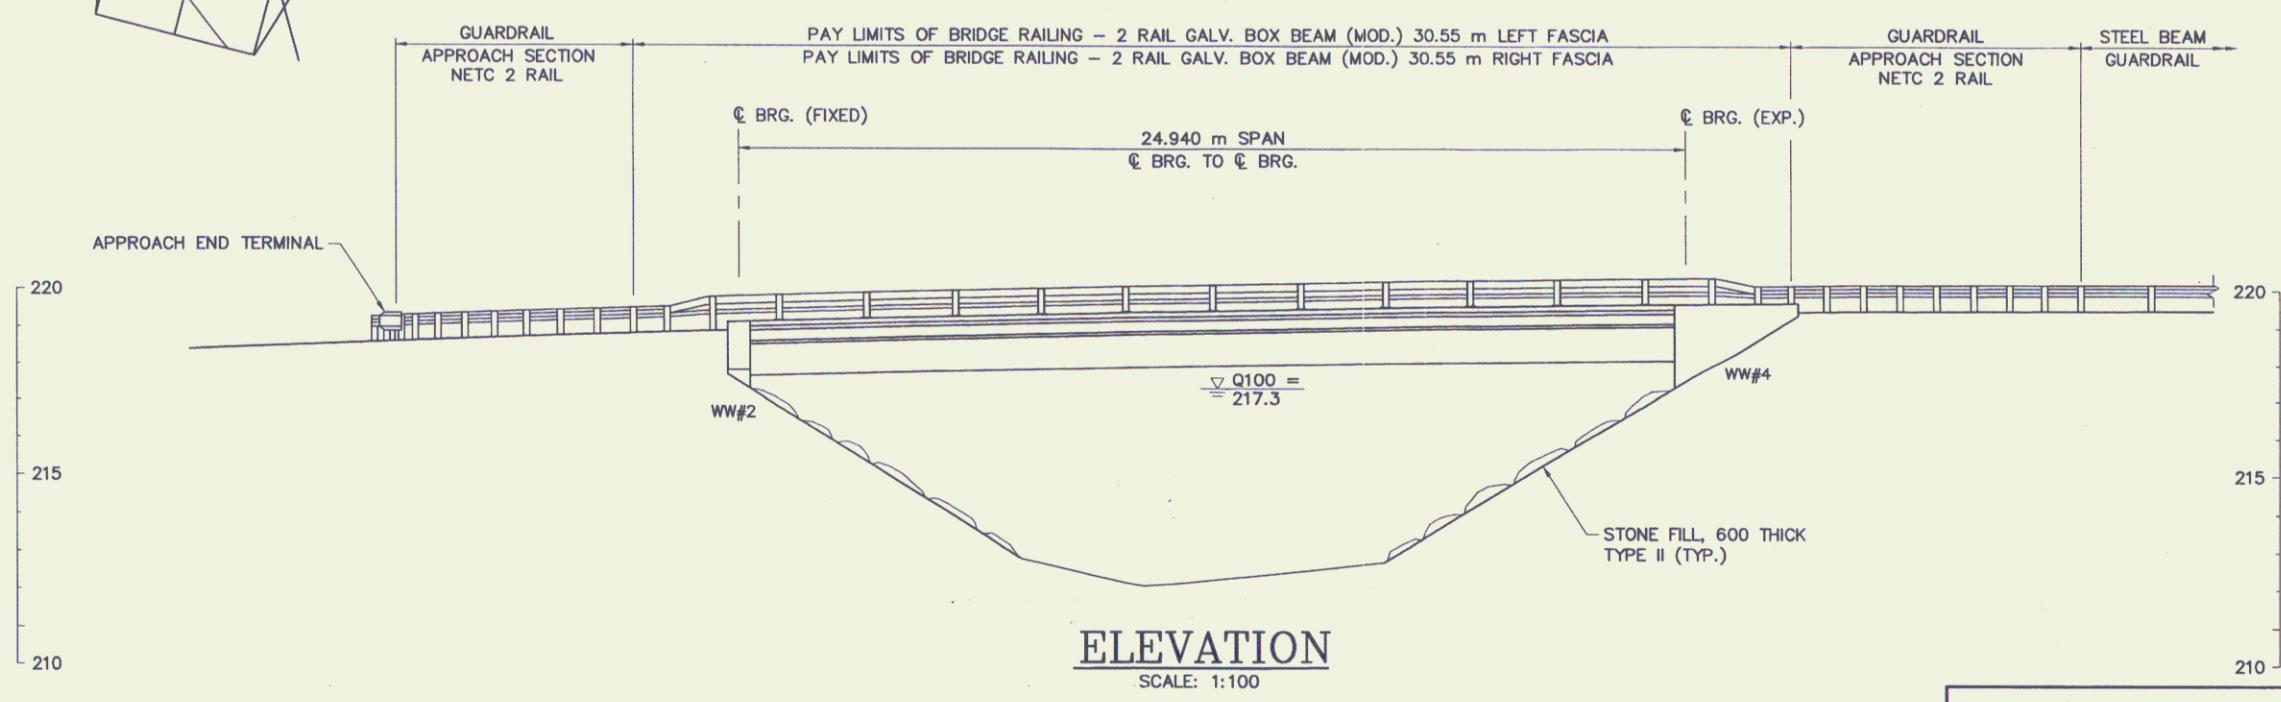

ELEVATION  
SCALE: 1:100

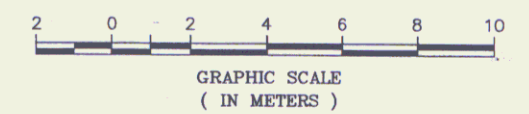

NOTE:  
1. SEE STANDARD SHEETS BR1-97M AND BR2-97M FOR BRIDGE AND APPROACH RAIL DETAILS.

<b>STATE OF VERMONT AGENCY OF TRANSPORTATION</b>			
Town Of	LYNDON	Bridge No.	2
Highway No.	VT 114	Log Sta.	
		Surv. Sta.	
VT 114 OVER PASSUMPSIC RIVER			
<b>PLAN AND ELEVATION</b>			
Designed By	S.M. GUNN	Drawn By	R.F. CLARK
Checked By		Bridge Design Supervisor	
PROJECT	LYNDON	PROJECT NO.	BHF 0269(10)
I.G.C. Info.			
ROW SHEET 9 OF 15 SHEETS			

VANASSE HANGEN BRUSTLIN, INC.