


STATE OF VERMONT
AGENCY OF TRANSPORTATION



R. O. W. PLANS

CITY OF WINOOSKI
COUNTY OF CHITTENDEN
SAFETY IMPROVEMENTS TO INTERSTATE 89 NB EXIT 15 OFF RAMP "B"
AT VT ROUTE 15 (PRINCIPAL ARTERIAL)

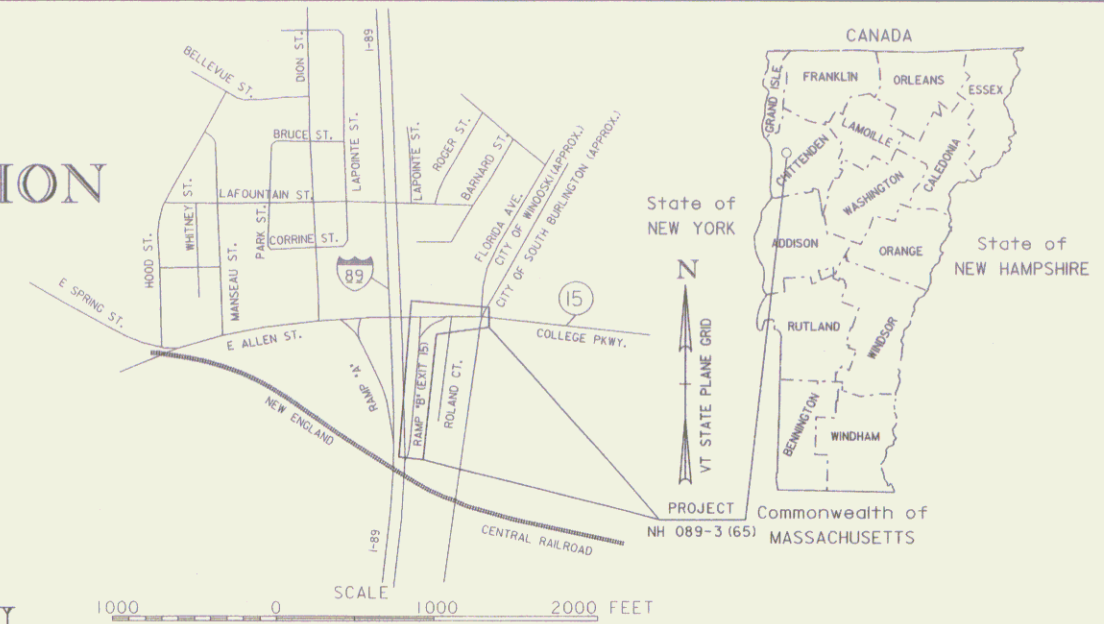

BEGINNING ON THE I-89 NORTHBOUND EXIT 15 OFF-RAMP, RAMP "B", APPROXIMATELY 595 FEET (0.113 MILE) SOUTH OF VERMONT ROUTE 15 AND EXTENDING NORTHERLY ALONG RAMP "B" FOR A DISTANCE OF 567.66 FT (0.108 MILE) AND 177.21 FEET (0.034 MILE) ALONG THE SLIP RAMP FOR RAMP "B".
LENGTH OF PROJECT = 744.87 FT = 0.141 MILES
THIS PROJECT CONSISTS OF FULL DEPTH RECONSTRUCTION AND WIDENING OF RAMP "B", INSTALLATION OF CURB, SIDEWALK, PAVEMENT MARKINGS, COLD PLANING AND OVERLAY, DRAINAGE, NEW SIGNAGE AND THE INSTALLATION OF NEW TRAFFIC SIGNALS AT THE INTERSECTION OF RAMP "B" AND VERMONT ROUTE 15 AND AT THE INTERSECTION OF ROLAND COURT AND VERMONT ROUTE 15.
LENGTH OF R.O.W. PROJECT = 203 FEET

I-89 NORTHBOUND OFF-RAMP TRAFFIC DATA

2010 AADT	8,500
2020 AADT	8,800
2030 AADT	9,200
2030 DHV	1,155
D	100%
T	4%
V	35 MPH
2010-2030 ESAL	2,240,000
2010-2050 ESAL	5,555,000

VT-15 FROM I-89SB ON-RAMP TO NB OFF-RAMP TRAFFIC DATA

2010 AADT	24,000
2020 AADT	25,000
2030 AADT	26,200
2030 DHV	3,164
D	64%
T	3%
V	25MPH

VT-15 FROM I-89 NB OFF-RAMP TO ROLAND COURT TRAFFIC DATA


2010 AADT	27,000
2020 AADT	28,000
2030 AADT	29,400
2030 DHV	3,422
D	53%
T	3%
V	25MPH

BITUMINOUS CONCRETE PAVEMENT SUPER PAVE MIXTURE DESIGN CRITERIA	
DESIGN LIFE ESAL (DESIGN LANE)	2,240,000
DESIGN NUMBER OF GYRATIONS	65
PERFORMANCE GRADED ASPHALT BINDER	SEE SECTION 490 GENERAL SPECIAL PROVISIONS

CONVENTIONAL SYMBOLS

COUNTY LINE	
TOWN LINE	
LIMITS OF ACCESS	
POINT OF ACCESS	
FENCE LINE	
STONE WALL	
TRAVELED WAY	
RAILROAD	
SURVEY LINE	
CULVERT	
POWER POLE	
TELEPHONE POLE	
TREES	
CONTROL OF ACCESS	
PROPERTY LINE	
R.O.W. TAKING LINE	
SLOPE RIGHTS	
TOP OF CUT	
TOE OF SLOPE	

SURVEYED BY: L. ORVIS P.C./G. HITCHCOCK
SURVEYED DATE: 04-03-2008
DATUM
VERTICAL NAVD_88
HORIZONTAL NAD_83/1996

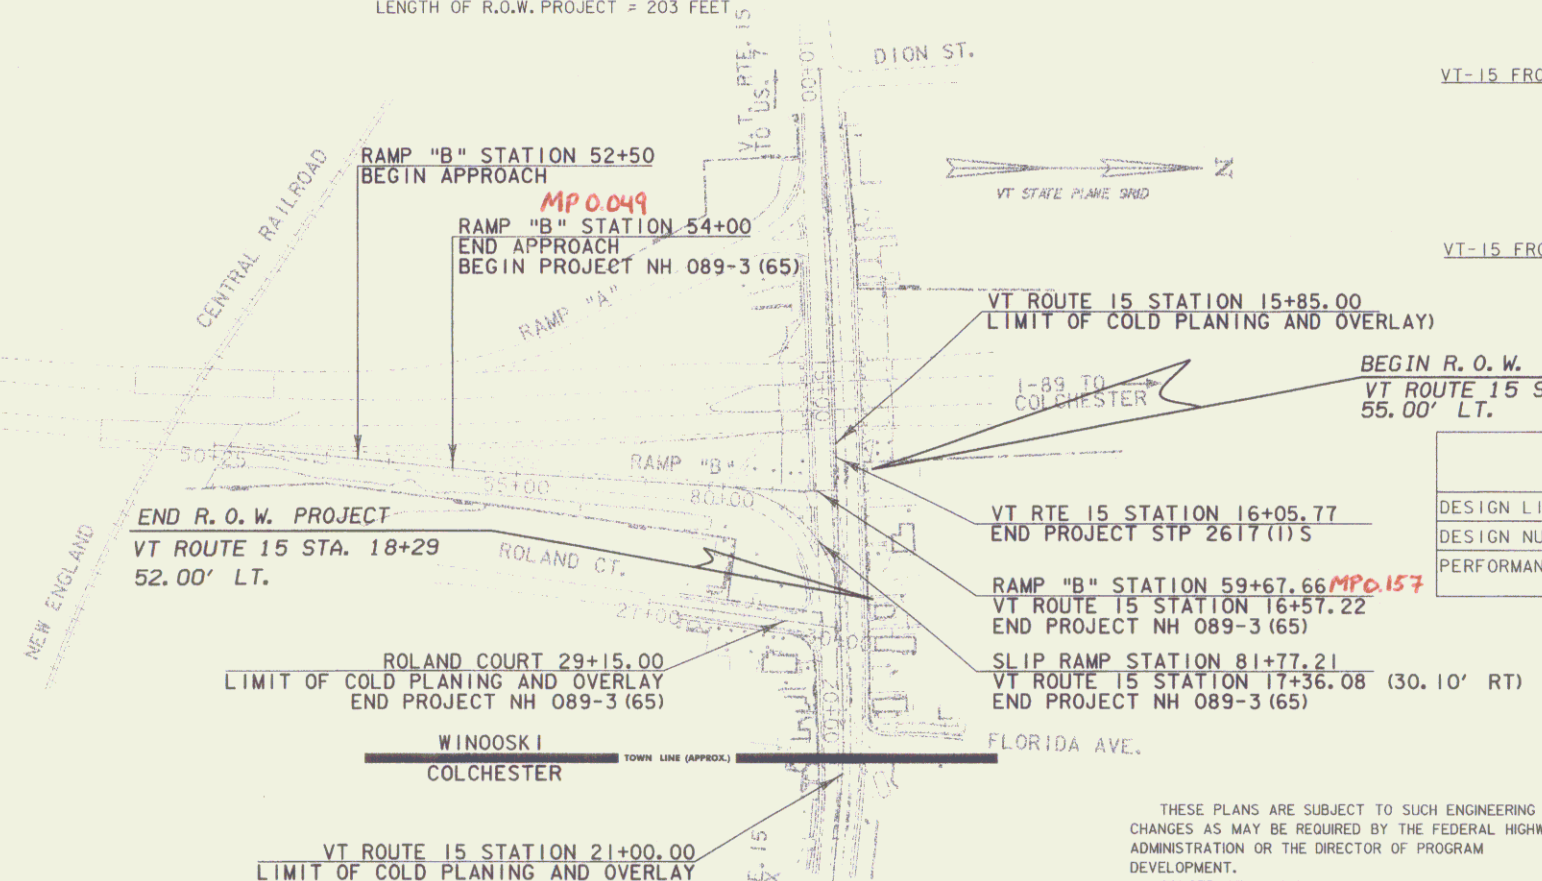

THESE PLANS ARE SUBJECT TO SUCH ENGINEERING CHANGES AS MAY BE REQUIRED BY THE FEDERAL HIGHWAY ADMINISTRATION OR THE DIRECTOR OF PROGRAM DEVELOPMENT.
CONSTRUCTION IS TO BE CARRIED ON IN ACCORDANCE WITH THESE PLANS AND THE STANDARD SPECIFICATIONS FOR CONSTRUCTION DATED 2006, AS APPROVED BY THE FEDERAL HIGHWAY ADMINISTRATION ON JUNE 15, 2006 FOR USE ON THIS PROJECT, INCLUDING ALL SUBSEQUENT REVISIONS AND SUCH REVISED SPECIFICATIONS AND SPECIAL PROVISIONS AS ARE INCORPORATED IN THESE PLANS.

APPROVED: *Robert J. Schmitt* DATE: 1/4/10
Director of Program Development

APPROVED: *Robert J. Schmitt* DATE: 1/4/2010
Chief of Right of Way

WINOOSKI
NH 089-3 (65)
R.O.W. SHEET 1 OF 5 SHEETS

Route I-89 R-B
Pin # 94A198