


PROJECT LOCATION:
ON VT. ROUTE 12, APPROXIMATELY 0.40 MILES SOUTH OF THE JUNCTION
OF VT. ROUTE 12 AND VT. ROUTE 107

PROJECT DATA:
LENGTH OF BRIDGE: 120.18 FT.
LENGTH OF ROADWAY: 569.82 FT.
LENGTH OF PROJECT: 690.00 FT.
LENGTH OF ROW PROJECT: 815.56 FT.

PROJECT DESCRIPTION:
THE PROJECT CONSISTS OF REPLACING THE EXISTING STRUCTURE WITH A
NEW SIMPLE SPAN BRIDGE, ROADWAY APPROACHES AND CHANNEL WORK.

STATE OF VERMONT
AGENCY OF TRANSPORTATION

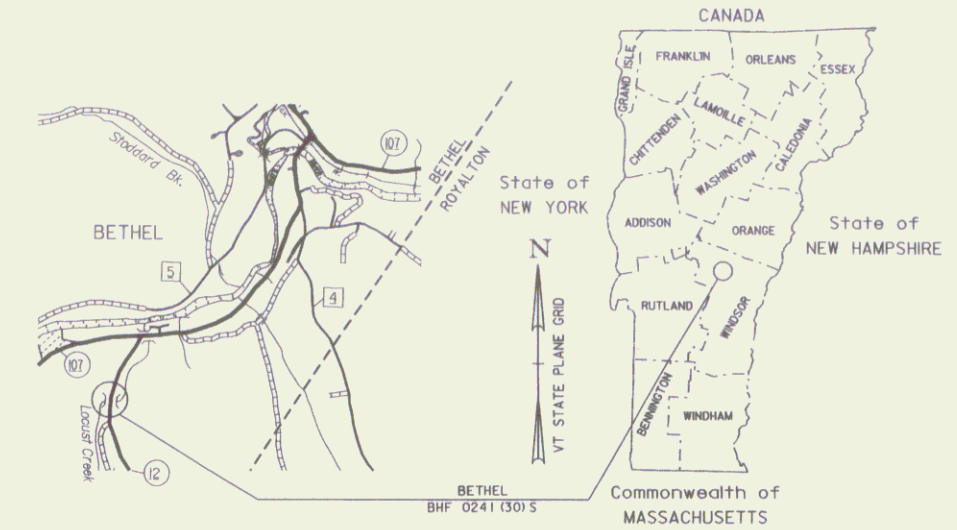


R.O.W. PLANS

BEGIN ROW PROJECT
BHF 0241 (30) S
STA. 101+05.39
49.72' LT.

PROPOSED IMPROVEMENT
BRIDGE PROJECT
TOWN OF BETHEL
COUNTY OF WINDSOR
ROUTE NO. : **VT 12**, MAJOR COLLECTOR, BRIDGE 30

END ROW PROJECT
BHF 0241 (30) S
STA. 109+20.95
39.40' LT.

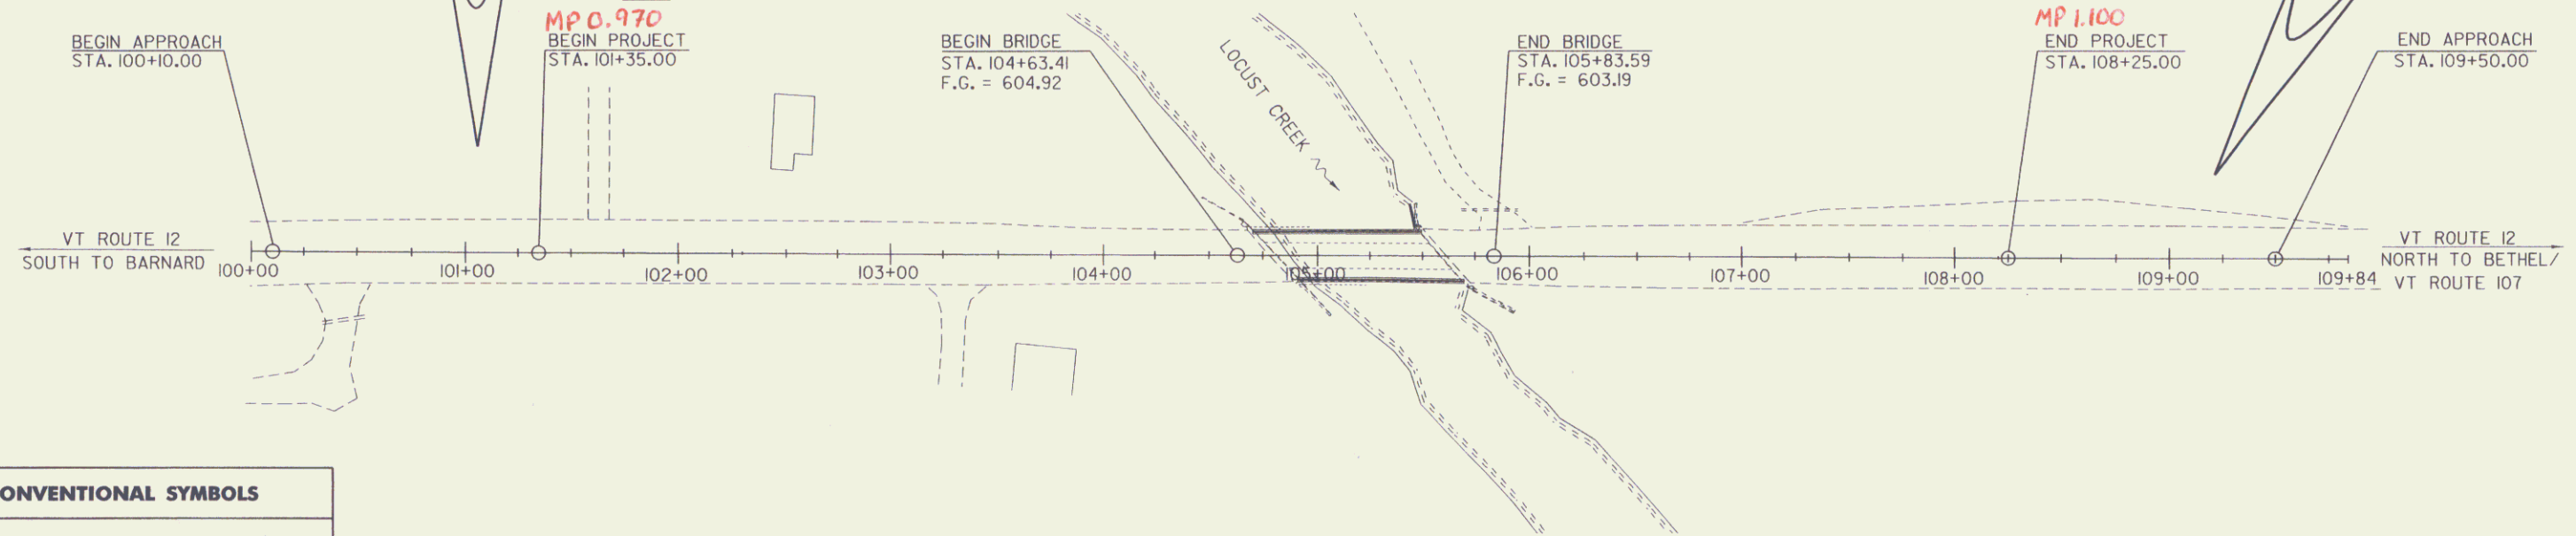

CONVENTIONAL SYMBOLS

COUNTY LINE	
TOWN LINE	
LIMITS OF ACCESS	
POINT OF ACCESS	
FENCE LINE	
STONE WALL	
TRAVELED WAY	
RAILROAD	
SURVEY LINE	
CULVERT	
POWER POLE	
TELEPHONE POLE	
TREES	
CONTROL OF ACCESS	
PROPERTY LINE	
R.O.W. TAKING LINE	
SLOPE RIGHTS	
TOP OF CUT	
TOE OF SLOPE	

ALL DRIVES AS INDICATED ON PLANS
ARE SUBJECT TO PERMITS PURSUANT
TO TITLE 19 V.S.A. 1111

LINES SHOWN ON THIS PLAN AS EXISTING
PROPERTY LINES P/L ARE BELIEVED TO
BE ACCURATE BUT SHOULD NOT BE RELIED
UPON FOR PURPOSES UNRELATED TO THE
STATE OF VERMONT'S ACQUISITION OF LAND
AND RIGHTS FOR THIS PROJECT.

SURVEYED BY : R.D. GILMAN
SURVEYED DATE : NOV 1995

DATUM
VERTICAL NAVD 88
HORIZONTAL NAD 83/92

THESE PLANS ARE SUBJECT TO SUCH ENGINEERING
CHANGES AS MAY BE REQUIRED BY THE FEDERAL HIGHWAY
ADMINISTRATION OR THE DIRECTOR OF PROGRAM
DEVELOPMENT.

CONSTRUCTION IS TO BE CARRIED ON IN ACCORDANCE
WITH THESE PLANS AND THE STANDARD SPECIFICATIONS
FOR CONSTRUCTION DATED 2006, AS APPROVED BY THE
FEDERAL HIGHWAY ADMINISTRATION ON JUNE 15, 2006
FOR USE ON THIS PROJECT, INCLUDING ALL SUBSEQUENT
REVISIONS AND SUCH REVISED SPECIFICATIONS AND
SPECIAL PROVISIONS AS ARE INCORPORATED IN THESE
PLANS.

SCALE 1" = 40'-0"
40 0 40

Pn# 95C002

APPROVED DATE 12-3-09
Director of Program Development

APPROVED DATE 12/15/09
Chief of Right of Way

BETHEL
BHF 0241 (30) S
ROW SHEET **1** OF 18 SHEETS