

RIGHT - OF - WAY DETAIL SHEET


TABLE OF PROPERTY ACQUISITION

PARCEL NO.	PROPERTY OWNER	SHEET NO.	BEGINNING STATION	ENDING STATION	TAKE AREA±	REMAINDER AREA±	RIGHT			RECORDING DATA				REMARKS
							TYPE	(T)(P)	AREA ±	TITLE	DATE	TOWN / CITY	BOOK	
1A	COTA, HENRY C. & SHIRLEY W.	5	VT15 281+07 LT. VT15 281+26 LT. TH710 10+73 LT.	VT15 281+49.64 LT. VT15 281+24 LT.	450 SF		SLOPE LANDSCAPE SLOPE	(T) (T) (T)	48 SF 39 SF	WD	07/13/06	ESSEX	692 616-617	TRIM 10" MAPLE AS NEEDED
1B		5	VT15 278+97.32 LT.	VT15 281+87.84 LT.	0.23A		ALL R.T. & I.							VT RTE. 15 & TH710 HWY. EASE: 9890 SF±
2A	RUSSELL, JOHN A. & LYNN A.	5	TH710 10+75.00 RT. TH710 10+60 RT. VT128 0+91 LT. VT128 0+95 LT. VT128 0+77 LT. TH710 10+71 RT. VT 128 0+91 LT.	VT128 1+00.00 LT. TH710 10+71 RT. VT128 1+50 LT. VT128 0+64 LT.	1280 SF		INSTALL SLOPE INSTALL DRIVE SLOPE INSTALL	(T) (T) (T) (T) (T) (T)	107 SF 193 SF 690 SF	WD	06/09/06	ESSEX	688 617-618	CONCRETE CURB / CONCRETE CURB ✓ 24" WIDE MM 0001 CONCRETE CURB ✓
2B		5	TH710 10+75.00 RT.	VT128 2+05.95 RT.	0.15A		ALL R.T. & I.							VT RTE. 128 & TH710 HWY. EASE: 6430 SF±
3A	KATHERINE S. REYNOLDS, TRUSTEE OF THE KATHERINE S. REYNOLDS FAMILY TRUST AND THE RAYMOND H. REYNOLDS FAMILY TRUST	5	VT15 281+19.80 RT. VT15 281+23 RT.	VT15 281+61.65 RT. VT15 281+62 RT.	110 SF		SLOPE	(T)	90 SF			ESSEX		PAVED
3B		5	VT15 279+13.02 LT.	VT15 281+58.87 RT.	0.17A		ALL R.T. & I.							VT RTE. 15 HWY. EASE: 7500 SF±
4A	TOWN OF ESSEX	5	VT15 281+58.87 RT. VT15 281+61.65 RT. VT15 282+54 RT. VT15 283+16 RT.	VT15 283+86.21 RT. VT15 283.23.6 RT. VT15 283+61 RT.	950 SF		SLOPE INSTALL & MAINTAIN DRIVE	(T) (P) (T)	0.10A	QCD	04/10/06	ESSEX	683 461-462	SLOPE AND PAVE: 4,260 SF± PIPES AND DRAIN INLET 26" WIDE MM 0534
4B		5	VT15 281+49.80 LT.	VT15 283+86.21 LT.	0.36A		ALL R.T. & I.							VT RTE. 15 & 128 HWY. EASE: 15,680 SF±
4C		5	TH710 10+75.00 LT.	TH710 10+28.26 RT.	1650 SF		ALL R.T. & I.							TH710 HWY. EASE
5	GREEN MOUNTAIN POWER CORPORATION													UTILITY
6	VERMONT GAS SYSTEMS, INC.													UTILITY
7	ADELPHIA CABLE COMMUNICATIONS													UTILITY
8	VERIZON NEW ENGLAND, INC.													UTILITY
	MAINTENANCE AGREEMENT ZONE	5	TH 710 10+18 CL	TH710 10+75 CL										LENGTH =57'

TABLE OF REVISIONS

REVISION NO.	SHEET NO.	DESCRIPTION	DATE
1	4	PARCEL NO. 2 RUSSELL, ADD ENDING STATION OF TH 710 10+71 RT., 107 S.F.± FOR INSTALL (T). PER C.O. 9452 MADE BY JB APPROVED BY RD	05/15/06

PLOT DATE 07/24/06

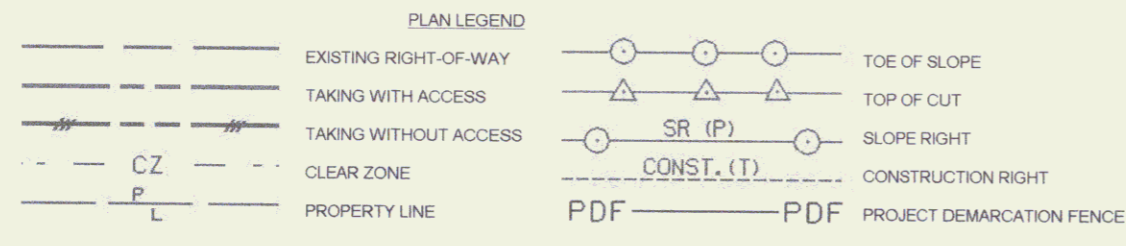

- (P) -PERMANENT
- (T) -TEMPORARY
- DR -DRAINAGE RIGHT
- DIT -DITCHING RIGHT
- CH -CHANNEL RIGHT
- DRIVE -DRIVE RIGHT
- CUL -CULVERT RIGHT
- C&T -CLEARING & TRIMMING RIGHT
- SR -SLOPE RIGHT
- UE -UTILITY EASEMENT

APPROVED: ROGER P. DUMAS DATE: 03-18-05
CHIEF, PLANS & TITLES

PROJECT NAME:	ESSEX
PROJECT NUMBER:	STPG SGNL(17)
FILE NAME:	96b182det.xls
PROJECT LEADER:	B. NYQUIST
DESIGNED BY:	B. MCAVOY
R.O.W. SHEET 4 OF 5 SHEETS	
PLOT DATE:	
DRAWN BY:	G. FUNK
CHECKED BY:	E. PIERCE
SHEET 8 OF 29	