


ALIGNMENT PLAN

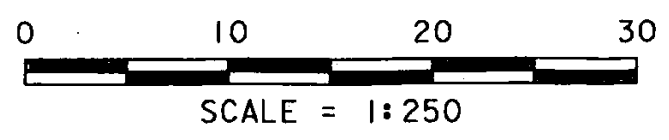

PROJECT NAME:	BRATTLEBORO	PLOT DATE:	11-JAN-2005
PROJECT NUMBER:	BRF 2000 (2)S	DRAWN BY:	
FILE NAME:	96J228\Structures\sj228d11.j	CHECKED BY:	
PROJECT MANAGER:	R.R. WHITCOMB	DESIGNED BY:	
		ROW SHEET	10B OF 15 SHEETS