

# RIGHT - OF - WAY DETAIL SHEET




TABLE OF PROPERTY ACQUISITION

PARCEL NO.	PROPERTY OWNER	SHEET NO.	BEGINNING STATION	ENDING STATION	TAKE	REMAINDER	RIGHT			RECORDING DATA				REMARKS					
					AREA ±	AREA ±	TYPE	(T)/(P)	AREA ±	TITLE	DATE	TOWN / CITY	BOOK		PAGE				
1	LAPIERRE, PAULINE	10	2+505.054 RT	2+550.858 RT	136 SM					WD	7/9/2013	COLCHESTER	744	419-420	1,464 SF±				
			2+496.8 RT	2+505.5 RT		CONST	(T)	14 SM											
			2+526.0 RT	2+541.7 RT		CONST	(T)	19 SM											
			2+534.0 RT	2+551.2 RT		RECONSTRUCT	(T)	126 SM											
			2+549.702 RT	2+550.839 RT			DRIVE	(T)											
							REMOVE & REPLACE	(T)											
2A	JOLLEY ASSOCIATES	10	2+505.064 LT	2+558.295 LT	146 SM					WDIF	8/29/2013	COLCHESTER	748	741-743	1,572 SF±				
			2+505.1 LT	2+531.9 LT		CONST	(T)	94 SM											
			2+519.2 LT	2+528.1 LT		SLOPE	(P)	5 SM											
			TH1 40+034.1 LT	TH1 40+046.2 LT		CONST	(T)	33 SM											
			TH1 40+038.5 LT	TH1 40+040.2 LT		SLOPE	(T)	1 SM											
			TH1 40+057.1 LT	TH1 40+058.4 LT		INSTALL	(T)	1 SM											
2B		10	2+558.943 LT	2+574.418 LT	136 SM			ALL R.T. & I.								US RTE 7 HWY EASE.; 1,464 SF±			
3A	JOLLEY ASSOCIATES	10	2+550.833 RT	2+584.601 RT	45 SM			ALL R.T. & I.		WDIF	8/29/2013	COLCHESTER	748	716-718	484 SF±				
			2+525.6 RT			ALL R.T. & I.													
			2+539.1 RT			DRIVE	(T)												
			2+549.702 RT	2+550.858 RT		REMOVE & REPLACE	(T)												
			2+550.839 RT	2+587.7 RT		RECONSTRUCT	(T)	136 SM											
			2+550.9 RT																
			2+557.3 RT	2+585.2 RT		INSTALL & MAINT	(P)	5 SM											
			2+561.1 RT	2+570.9 RT		UTILITY	(P)	22 SM											
			2+572.2 RT	2+581.7 RT		INSTALL & MAINT	(P)												
			2+573.0 RT	VT127 50+006.1 RT		REMOVE & RESET DRIVE	(T)	100 SM											
	VT127 50+008.4 RT	REMOVE SLOPE	(T)	78 SM															
	VT127 50+008.9 RT	CONST	(T)	36 SM															
	VT127 50+012.0 RT																		

TABLE OF REVISIONS

REVISION NO.	SHEET NO.	DESCRIPTION	DATE
1	7, 12	PARCEL 14, AMERICAN LEGION - ADD EASEMENT TO DETAIL SHEET 'RECONSTRUCT (T)' FOR PARKING AREA. COMPLETED BY: MT C.O. 9789 APPROVED BY: HP	2/13/2013
2	2, 3, 4, 10, 11	PARCEL 5, MUSON EARTHMOVING - NAME CHANGED TO SBRC PROPERTIES, LLC. COMPLETED BY: MT C.O. 9791 APPROVED BY: HP	2/21/2013
3	3, 10	PARCEL 3, JOLLEY ASSOC. - PHONE BOOTH HAS BEEN REMOVED. REVISE TO "REMOVE (T)" FOR REMAINING CONCRETE PAD. COMPLETED BY: MT C.O. 9797 APPROVED BY: HP	4/1/2013
4	11	PARCEL 7, WHEELOCK & STEBBINS - ADD EXISTING GAS LINE. COMPLETED BY: MT C.O. 9798 APPROVED BY: HP	4/1/2013
5	11, 15	PARCEL 8, WESCO - DELETE NOTES "TO BE REMOVED BY PROPERTY OWNER" FOR LIGHT POLES AND ROAD SIGN. COMPLETED BY: MT C.O. 9799 APPROVED BY: HP	4/1/2013
6	11	PARCEL 9, VERVILLE - ADD EXISTING GAS LINE. COMPLETED BY: MT C.O. 9800 APPROVED BY: HP	4/1/2013
7	11	PARCEL 10, MOORE - ADD EXISTING GAS LINE. COMPLETED BY: MT C.O. 9801 APPROVED BY: HP	4/1/2013
8	12	PARCEL 12, CREEK FARM - DELETE NOTE "SEE ROW PLANS" COMPLETED BY: MT C.O. 9802 APPROVED BY: HP	4/1/2013
9	12	PARCEL 14, AMERICAN LEGION - DELETE ARROWS INDICATING THAT THE "STREET LIGHTS" SHOULD BE REMOVED BY PROPERTY OWNER. THEY ARE BEING ALLOWED TO REMAIN IN THE R.O.W. COMPLETED BY: MT C.O. 9803 APPROVED BY: HP	4/1/2013
10	16	PARCEL 16, CLAUSSEN - DELETE NOTES TO REMOVE DIRECTIONAL SIGNS AT DRIVEWAY 22+230.5 LT COMPLETED BY: MT C.O. 9804 APPROVED BY: HP	4/1/2013
11	5	PARCEL 7, WHEELOCK & STEBBINS - REVISE AREA OF ALL R.T. & I. HWY EASE FROM 1.20 HA/2.97 AC TO 0.12 HA/0.30 AC. COMPLETED BY: MT C.O. 9806 APPROVED BY: HP	4/15/2013
12	10	PARCEL 1, LAPIERRE - REVISE ADDRESS TO 3424 ROOSEVELT HWY ON LAYOUT SHEET. COMPLETED BY: MT C.O. 9807 APPROVED BY: HP	4/19/2013
13	15	PARCEL 3, JOLLEY ASSOC. - REVISE ADDRESS TO 3436 ROOSEVELT HWY ON LAYOUT SHEET. COMPLETED BY: MT C.O. 9808 APPROVED BY: HP	4/19/2013
14	11, 15	PARCEL 6, 116 MAIN STREET LLC - REVISE ADDRESS TO 3548 ROOSEVELT HWY ON LAYOUT SHEETS. COMPLETED BY: MT C.O. 9809 APPROVED BY: HP	4/19/2013
15	12, 15	PARCEL 13, NEW HORIZON - REVISE ADDRESS TO 42-84 PIERRE CT. ON LAYOUT SHEETS. COMPLETED BY: MT C.O. 9810 APPROVED BY: HP	4/19/2013
16	4, 10, 33, 49	PARCEL 4, TOWN OF COLCHESTER - DELETE PROPOSED UNDERDRAIN ON BAY ROAD. COMPLETED BY: MT C.O. 9814 APPROVED BY: HP	6/21/2013
17	4, 10, 11	PARCEL 5, SBRC PROPERTIES - ADD PARCEL 5A; EXTENDED PROPOSED DITCH TO BANK. COMPLETED BY: MT C.O. 9834 APPROVED BY: RC	10/24/2013
18	7, 12, 15	PARCEL 13, NEW HORIZON - DELETE SHARED DRIVE ACCESS EASEMENT. REVISE DRIVE DESIGN. COMPLETED BY: MT C.O. 9842 APPROVED BY: RC	11/1/2013
19	7, 12	PARCEL 14, AMERICAN LEGION - DELETE ACCESS OVER PARCEL 13, RECONFIGURE PARKING AREA, REVISE DRIVE ACCESS DESIGN TO 39' WIDE. COMPLETED BY: MT C.O. 9843 APPROVED BY: RC	11/1/2013

PLAN LEGEND

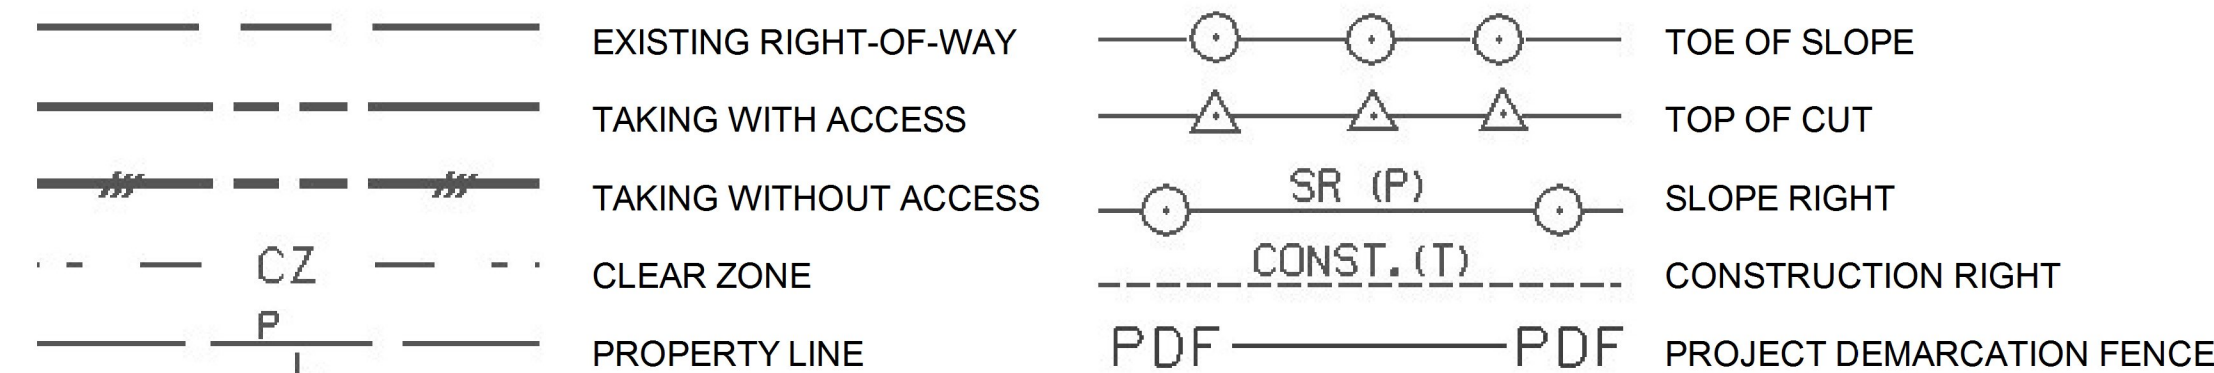

- EC -EROSION CONTROL
- (P) -PERMANENT
- (T) -TEMPORARY
- DR. -DRAINAGE RIGHT
- DIT. -DITCHING RIGHT
- CH. -CHANNEL RIGHT
- DRIVE -DRIVE RIGHT
- CUL. -CULVERT RIGHT
- BND -BOUND (PROPERTY MARKER)
- SR -SLOPE RIGHT
- UE -UTILITY EASEMENT

APPROVED: HARRY PETROVS DATE: 09-05-12  
CHIEF, PLANS & TITLES

PROJECT NAME: **COLCHESTER**  
 PROJECT NUMBER: **STP 5600(9)S**  
 FILE NAME: **r97d206detail.xls** PLOT DATE: **01-NOV-2013**  
 PROJECT LEADER: **J. SCHULTZ** DRAWN BY: **M. TROTTIER**  
 DESIGNED BY: **D. BRYANT** CHECKED BY: **E. PIERCE**  
 R.O.W. DETAIL SHEET #1 SHEET **3** OF **74**