


REHABING DICB OR MH CLASS II
32+071.973 LT (CONVERT DITO MH)

NEW DRAINAGE

- 35 32+071.973 LT ~ 32+071.973 LT
NEW 450 mm x 1.089 m OPTION AA PIPE
MATCH EXISTING INVERTS
- 45 32+071.973 LT ~ 32+071.973 LT
NEW 450 mm x 3.112 m OPTION AA PIPE
MATCH EXISTING INVERTS

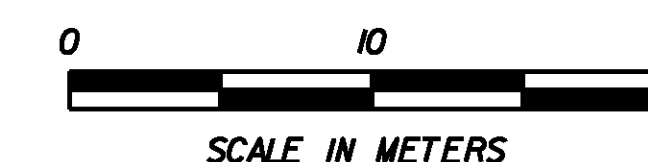

NOTES

- 1) SEE CONSTRUCTION PLANS FOR ADDITIONAL PROPOSED FACILITIES.
- 2) SEE UTILITY PLANS FOR LOCATIONS OF PROPOSED UTILITY RELOCATIONS.

DATUM
VERTICAL NAVD 88
HORIZONTAL NAD 83/96

PROJECT NAME: Colchester
PROJECT NUMBER: STP 5600(9)S

FILE NAME: r97d206DRN8.dgn	PLOT DATE: 21-FEB-2013
PROJECT LEADER: D Bryant	DRAWN BY: T Kelley
DESIGNED BY: D Bryant	CHECKED BY: D Burhans
DRAINAGE PLAN SHEET 8 OF 8	SHEET 40 OF 74