


MATCH LINE TO ROW SHEET 26 OF 37

MATCH LINE 4+714

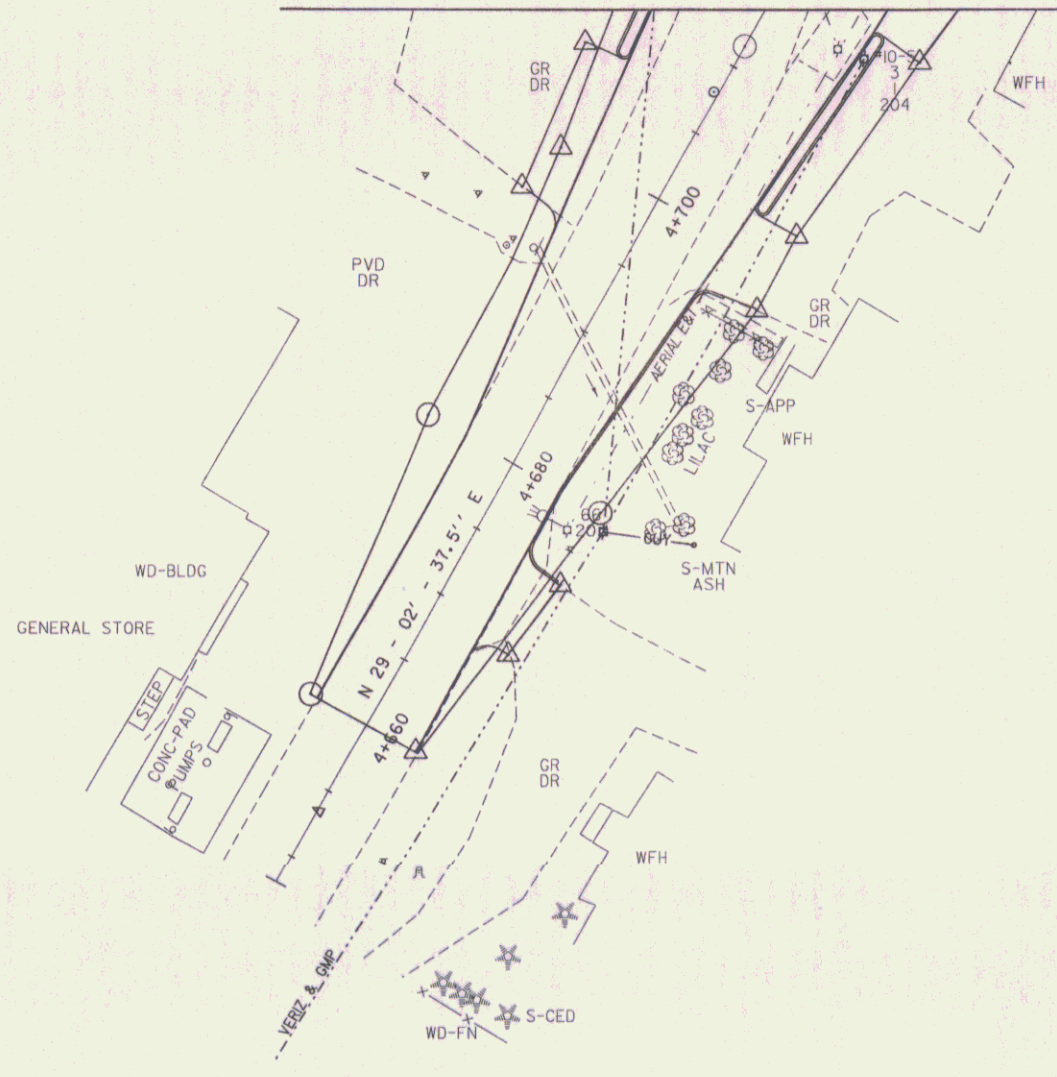

DRAINAGE NOTES - EXISTING
 30 4+689.5 CL - 380mm GMP - Retain

UNDERDRAIN
 4+700.0 RT - 4+800.0 RT
 New 150mm x 94m Underdrain
approximate location of septic line to tank on Montague's

REMOVE FENCE
 4+695 RT


approximate location of septic line to tank on Montague's

CONSTRUCT DRIVES
 4+672 RT (6.1M PAVED)
 4+699 RT (5.8M PAVED)
 4+702 LT (10.5M PAVED)

CONSTRUCT DRIVE APRON
 4+660 LT - 4+692 LT (PAVED)

monitoring system of State for Biron, across Lamb's on Hasland, LLC

DATUM	
VERTICAL	NAVD 88
HORIZONTAL	NAD 83(1992)

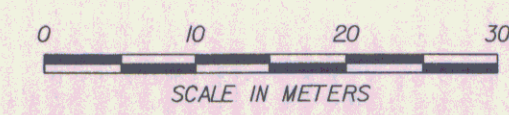

DRAINAGE PLAN LAYOUT 1

PROJECT:	EAST MONTEPELIER	PROJECT NO.:	STPG 028-3(35)S
DESIGN FILE NAME:	/sqda/98b028/db028...bdr_nul_top...dgn	PLOT DATE:	01-JUL-2008
IPARM FILE NAME:	db028d11	SURVEY DATE:	8/98
SURVEYED BY:	Jls	DRAWN BY:	Jfg
SQUAD LEADER:	Jls	ROW SHEET:	25 OF 37