

R.O.W. PLANS

**BEGIN ROW PROJECT
STP-ER IRN0(014)
STA. 120+75.0 RT**

**N/F
YOUNG, ANNETTE F.**


249.71'± HELD
PER 1984 SURVEY ENTITLED:
"SURVEY & SUBDIVISION PLAT OF
PROPERTY IN EAST MONTPELIER,
VERMONT FOR DORIS TUMULTY"
BY AMERICAN SURVEY CO.
MAP # 41HANGER #31
EAST MONTPELIER, TOWN RECORDS

**2
WEST, RICHARD A.
& CATHERINE M.**

**1
COPELAND, JOHN J.
& SUE L.**

**N/F
GEORGE, WILLIAM H.
& JULIE B.**

**END ROW PROJECT
STP-ER IRN0(014)
STA. 123+36 RT**

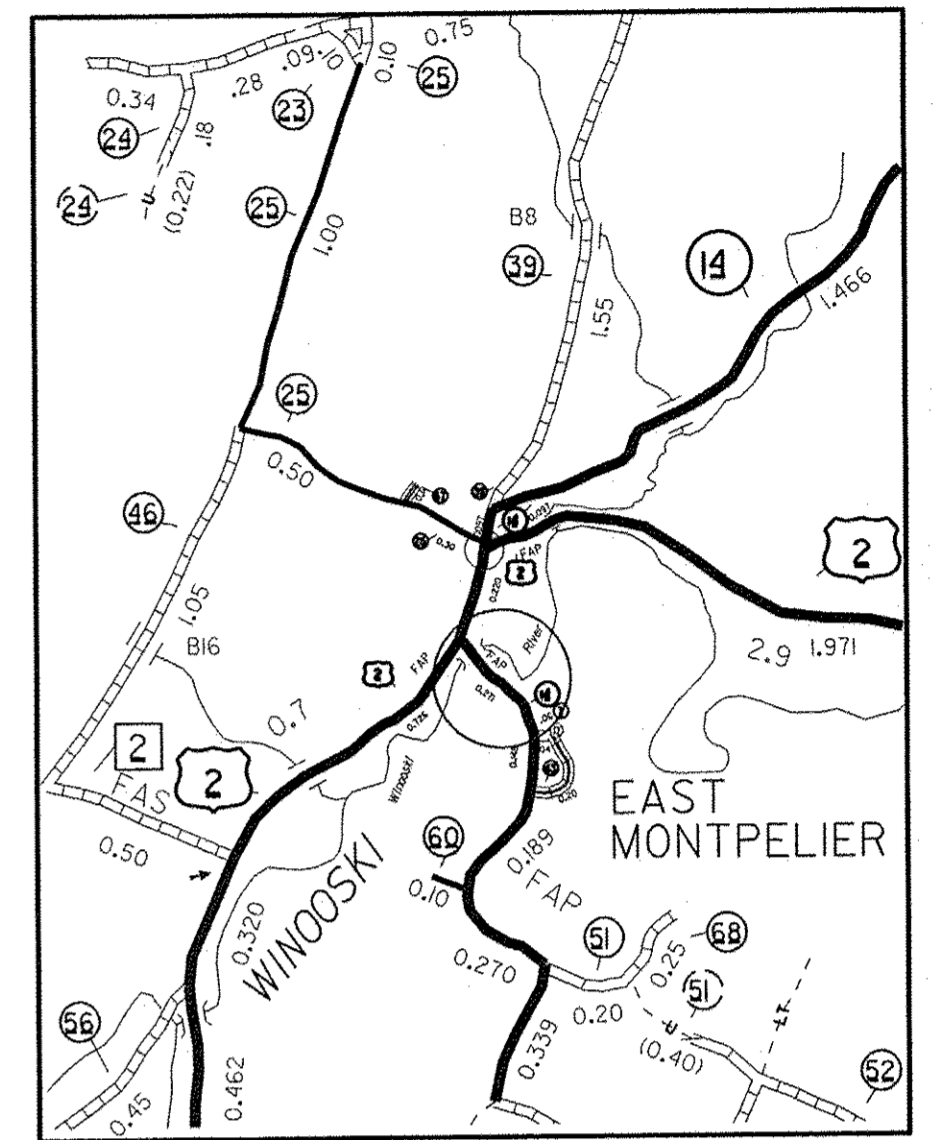

LOCATION MAP (NOT TO SCALE)

LENGTH OF ROW PROJECT: 261'

STATE OF VERMONT AGENCY OF TRANSPORTATION														
RIGHT - OF - WAY DETAIL SHEET														
TABLE OF PROPERTY ACQUISITION														
PARCEL NO.	PROPERTY OWNER	SHEET NO.	BEGINNING STATION	ENDING STATION	TAKE AREA±	REMAINDER AREA±	RIGHT			RECORDING DATA				REMARKS
							TYPE	(T)/(P)	AREA ±	TITLE	DATE	TOWN/CITY	BOOK	
1	COPELAND, JOHN J. & SUE L.	1	121+29 RT	123+02 RT			SLOPE	(P)	9,378 SF			EAST MONTPELIER		STONE FILL: 22 A ± INCL. TEMPORARY ACCESS ROAD FENCE PAVED APRON
			122+07 RT	123+12 RT			CONST.	(T)	1,433 SF					
			121+94 RT	122+68 RT			REMOVE & RESET DRIVE	(T)						
2	WEST, RICHARD A. & CATHERINE M.	1	120+75 RT	121+29 RT			SLOPE	(P)	5,476 SF			EAST MONTPELIER		STONE FILL: 12 A ±

TABLE OF REVISIONS

REVISION NO.	SHEET NO.	DESCRIPTION	DATE
1	1	PARCEL 1 COPELAND - CHANGE BEGIN STATION 122+94 RT TO 121+94 RT COMPLETED BY: MT C.O. 9754 APPROVED BY: HP	12/01/11

LINES SHOWN ON THIS PLAN AS EXISTING PROPERTY LINES P/L ARE BELIEVED TO BE ACCURATE BUT SHOULD NOT BE RELIED UPON FOR PURPOSES UNRELATED TO THE STATE OF VERMONT'S ACQUISITION OF LAND AND RIGHTS FOR THIS PROJECT.

FOR R.O.W. USE ONLY

PROJECT NAME: EAST MONTPELIER
PROJECT NUMBER: STP-ER IRN0(014)
FILE NAME: r98b252S_row.dgn
PROJECT LEADER: G. McCOOL
DESIGNED BY: M. LONGSTREET
ROW SHEET 1 of 1
PLOT DATE: 01-DEC-2011
DRAWN BY: B. FERLZAO
CHECKED BY: H. PETROVS
SHEET 1 OF 1

SCALE 1" = 20'-0"
20 0 20