

# RIGHT - OF - WAY DETAIL SHEET

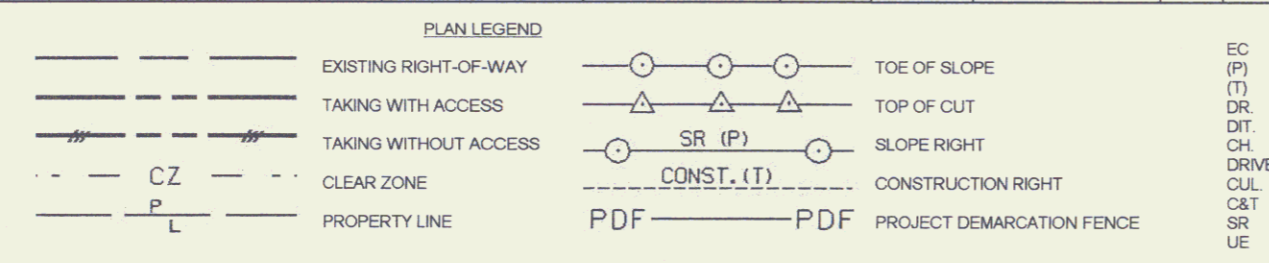


TABLE OF PROPERTY ACQUISITION

PARCEL NO.	PROPERTY OWNER	SHEET NO.	BEGINNING STATION	ENDING STATION	TAKE AREA ±	REMAINDER AREA ±	RIGHT			RECORDING DATA				REMARKS	
							TYPE	(T)(P)	AREA ±	TITLE	DATE	TOWN / CITY	BOOK		PAGE
1	COTE, BARBARA G.	18	1+112.00 RT.				INSTALL & MAINTAIN	(P)		WDOE	9/22/2008	EAST MONTPELIER	103	378-379	GUY WIRE & ANCHOR
2A	COTE, MICHAEL B. & ANITA	18, 19	1+266.58 RT.	1+269.92 RT.	2.57 SM					WD	9/29/2008	EAST MONTPELIER	103	432-434	27 S.F. ±
2B		18, 19	1+178.21 RT.	1+264.15 RT.			CONST.	(T)	258.0 SM						INCLUDES EROSION CONTROL & PDF 2,777 SF ± GUY WIRE & ANCHOR TWO WAY VEHICULAR, 0.32 A ± 9 S.F. ± IRON PIN 1636 S.F. ± IRON PIN IRON PIN IRON PIN IRON PIN 1101 S.F. ±
2C		18, 19	1+175.00 CL	1+289.39 RT.	0.12 HA		ALL R.T. & I.								HWY EASE: U.S. RTE. 2: 0.30 A ±
3A	COTE, DONALD G.	19, 20	1+305.76 RT. 1+181.50 RT. 1+279.76 RT. 1+294.26 RT. 1+294.47 RT. 1+300.00 RT. 1+335.00 RT. 1+309.55 RT. 1+374.00 RT. 1+423.00 RT.	1+309.58 RT. 1+377.10 RT. 1+369.19 RT. 1+306.01 RT. 1+335.00 RT. 1+394.70 RT.	2.2 SM		DETOUR CONST. CHANNEL SLOPE REMOVE & RESET REMOVE DRIVE INSTALL INSTALL	(T) (T) (P) (P) (T) (T) (T) (T)	0.18 HA 399.6 SM 78.6 SM 157 SM 200 SM	WD	9/22/2008	EAST MONTPELIER	103	380-382	24 S.F. ± MONITOR WELL TWO WAY VEHICULAR, 0.44 A ± INCLUDES EROSION CONTROL & PDF, 4,301 S.F. ± 846 S.F. ± 1,690 S.F. ± 2,153 S.F. ± IRON PIN DRIVE 4.5M (15') GRAVEL, IN COMMON WITH PARECL 11 MM 0419 PDF & E.C. PDF & E.C.
3B		19, 20	1+289.39 CL	1+414.75 RT.	0.09 HA		ALL R.T. & I.								HWY. EASE: US 2: 0.23A ±
4A	RUNNALLS, DONALD S. & ROSEMARIE A.	18, 19	1+270.41 LT.	1+274.16 LT.	2.2 SM					WD	11/26/2008	EAST MONTPELIER	104	186-188	24 S.F. ±
4B		18, 19	1+186.36 CL	1+293.10 LT.	0.08 HA		ALL R. T. & I.								HWY EASE: U.S. RTE 2: 20 ACRE ±

TABLE OF REVISIONS

REVISION NO.	SHEET NO.	DESCRIPTION	DATE
1	16, 19, 20	PARCEL 3 COTE. DEPICT COTE'S 60' ROW OWNED BY FAIRMONT FARMS. ADJUST TAKING OF HWY EASEMENT CHANGE ENDING STATION OF ALL R.T. & I. FROM 1+435.58 RT. TO 1+414.75 RT. CHANGE AREA FROM 0.11 HA, 0.27 A TO 0.09 HA, 0.23 A. PER C.O. 9528. MADE BY: BF APPROVED BY: HP	6/16/2008
2	17, 20	PARCEL 11 FAIRMONT FARMS. CREATE NEW PARCEL. THIS PARCEL WILL CONSIST OF DRIVE (T) AT STA. 1+423.00 RT. - 4.5 M (15') GRAVEL. IN COMMON WITH COTE. INSTALL (T) AT STA. 1+413.17 RT. - 1+417.81 RT. - PDF & EC. INSTALL (T) AT STA. 1+424.93 RT. - 1+431.87 RT. - PDF & EC. PER C.O. 9529. MADE BY: BF APPROVED BY: HP	6/16/2008
		ELECTRONIC FILES TO STRUCTURES	1/15/2009



PLOT DATE: 4/6/2009

APPROVED: HARRY PETROVS DATE: 02-13-08  
CHIEF, PLANS & TITLES

PROJECT NAME: EAST MONTPELIER	PLOT DATE: 4/6/2009
PROJECT NUMBER: BRF 028-3(36)	DRAWN BY: MR
FILE NAME: 98b254.xls	CHECKED BY: FM
PROJECT LEADER: K. Higgins	SHEET 51 OF 68
DESIGNED BY: J. LaCroix	
R.O.W. SHEET 16 OF 20	

16