

INDEX OF SHEETS

SHEET NO.	DESCRIPTION
1.	Title Page
2.	Typical Sections
3.	Quantity Sheet
4.	Iron Detail and Drainage Sheet
5.	Earthwork Sheet
6-6a.	E.O.N. Detail Sheet
7-11.	Plan and Profile Sheets
12.	Intersection Detail
13.	200'-5-65 at 87+00
14.	200'-5-65 at 99+50
15.	BLANK
16.	A-60 Solid Rock Excavation 1/17/63 R
17.	B-1 Banking Tables 7/17/67 R
18.	B-5 Slope Rounding 3/10/65
19.	B-6 Muck Excavation 3/10/65
20.	B-10 Fill on a Slope 3/10/65
21.	B-11 Slope Stabilization 3/10/65
22.	C-1 Granite Slope Edging 3/10/65 R
23.	D-2 Headwalls 4/24/69 R
24.	D-3 Junt Marking 3/10/67 R
25.	D-4 Flushing Basin 12/4/68 R
26.	D-6 Drop Inlet for Ditches 12/23/66
27.	D-8 Drop Inlet 3/10/65
28.	D-11 D.I. Gates 3/10/65
29.	E-32 Road Construction Approach Signs 1/16/67
30.	E-36 One-Project Signs 5/13/67 R
31.	E-39 Bestment Project Signs 1/24/68
32.	G-1 Steel Beam Guard Rail 10/18/68 R
33.	G-4 Marker Posts, Pipe Guard Rail 12/30/65 R
34.	G-11 Anchors for Steel Beam Guard Rail 10/8/68 R
35.	J-1 Project Markers 3/10/65
36-41.	Blank
42-53.	US 2 Cross Sections
54-55.	VT 63 Cross Sections


STATE OF VERMONT
DEPARTMENT OF HIGHWAYS
PROPOSED IMPROVEMENT

TOWN OF ALBURG
COUNTY OF GRAND ISLE
Sub doc U.S. ROUTE NO. 2
BURLINGTON-ROUSES POINT N.Y. ROAD

BEGINNING AT A POINT 0.085 MILE SOUTHERLY OF THE ALBURG VILLAGE LINE AND EXTENDING NORTHERLY 0.663 MILE.
LENGTH OF ROADWAY 3500 FEET = 0.663 MILE.
LENGTH OF PROJECT 3500 FEET = 0.663 MILE.

DESIGN DESIGNATION

ADT 1966	1920
ADT 1986	3080
DIV 1986	600
D	51
T	8
V	50 MPH

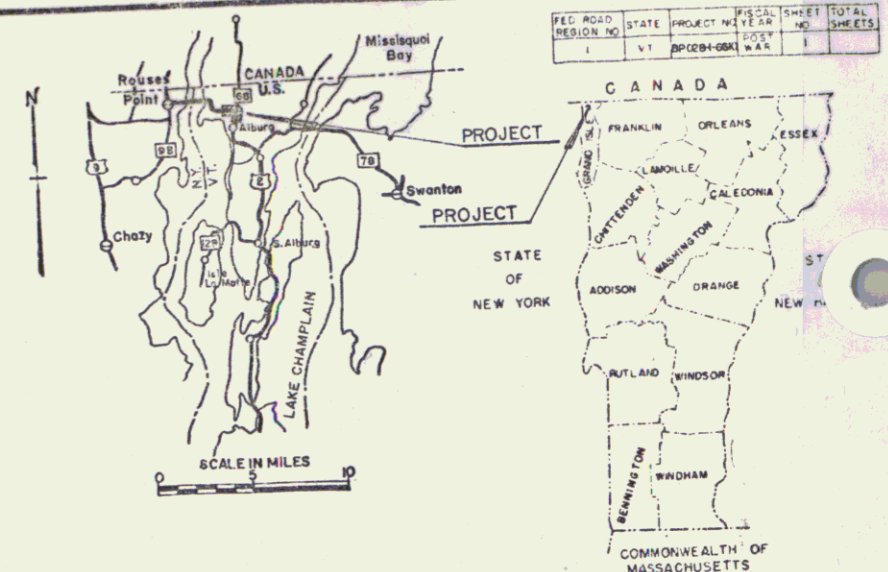

(To Be Returned to R.O.M. Division)
MP 3.46



PROJECT NAME & NUMBER	TYPE	PAVEMENT AREA
ALBURG BP 028-1-6610	BIT. CON.	9600 SY.

RECORD PLANS

MATERIALS

SUB-BASE OF FLEDBE ROCK: E. BOUGEOIS PIT, ALBURG, VT.
SUB-BASE OF SAND: DUCHAIN PIT, ALBURG, VT.
CEMENT: ANDERSON PLANT, SWANTON, VT.
R.C.P.: S.T. GRISWOLD & CO., WILLISTON, VT.
A.C.C.G.N.P.: NEW ENGLAND METAL CULV. CO., WHITE RIVER JCT, VT.
CABLE FOR GUARD RAIL: S.T. GRISWOLD & CO., WILLISTON, VT.
REINFORCING STEEL: VT. STRUCTURAL STEEL CO., BURLINGTON, VT.
CUTBACK ASPHALT: ALLSTATE ASPHALT INC., SUNDERLAND, MASS.
BIT. CON. PAVE.: L.M. PIKE PLANT, SWANTON, VT.
CRUSHED ST. PLANT MIX BASED COURSE: L.M. PIKE PLANT

CONTRACTOR: LAFERIE CONST. CO. CONTRACT DATED: 25 MAR. 70.
RESIDENT ENG'R.: A. LAVIGNE CONTRACT STARTED: 23 APR. 70.
RECORD PLANS: R. WASHBURN CONTRACT COMPLETED: 9 NOV. 70.
CONTRACT ACCEPTED: 10 NOV. 70.

CONVENTIONAL SIGNS

R.O.W.
COUNTY LINE	-----
TOWN LINE	-----
FENCE LINE	-----
STONE WALL	-----
UNFENCED PROPERTY	-----
GUARD RAIL	-----
TRAVELED WAY	-----
RAILROAD	-----
RETAINING WALL	-----
CENTER LINE	-----
SURVEY LINE	-----
CULVERT	-----
DROP INLET	-----
JOINT OCCUPANCY	-----
TELEPHONE POLE	-----
TREES	-----
HEDGE	-----

PROJECT: ALBURG
NUMBER: BP 028-1-6610
TYPE: BITUMINOUS CONCRETE PAVEMENT

CONTRACTOR: LAFERIE CONST. CO.
LOCATION: BEGINNING AT A POINT 0.076 MILE SOUTHERLY OF THE ALBURG VILLAGE LINE AND EXTENDING NORTHERLY 0.634 MILE

APPROVED: [Signature] DATE: 10/20/66
APPROVED: [Signature] DATE: 11/23/70
APPROVED: [Signature] DATE: 10/24/66
APPROVED: [Signature] DATE: 11/23/70

NOTES: ANY FURTHER INFORMATION CONCERNING FIELD CHANGES, AMOUNTS OR OTHER DETAILS RELATIVE TO THIS PROJECT MAY BE FOUND IN EITHER THE FIELD BOOKS OR THE ESTIMATE FILE.

04/01/70

MP 2.83

DEPARTMENT OF TRANSPORTATION
BUREAU OF PUBLIC ROADS

APPROVED: [Signature] DIVISION ENGINEER
PROJECT: BP No. 028-1