


POOR ORIGINAL COPY

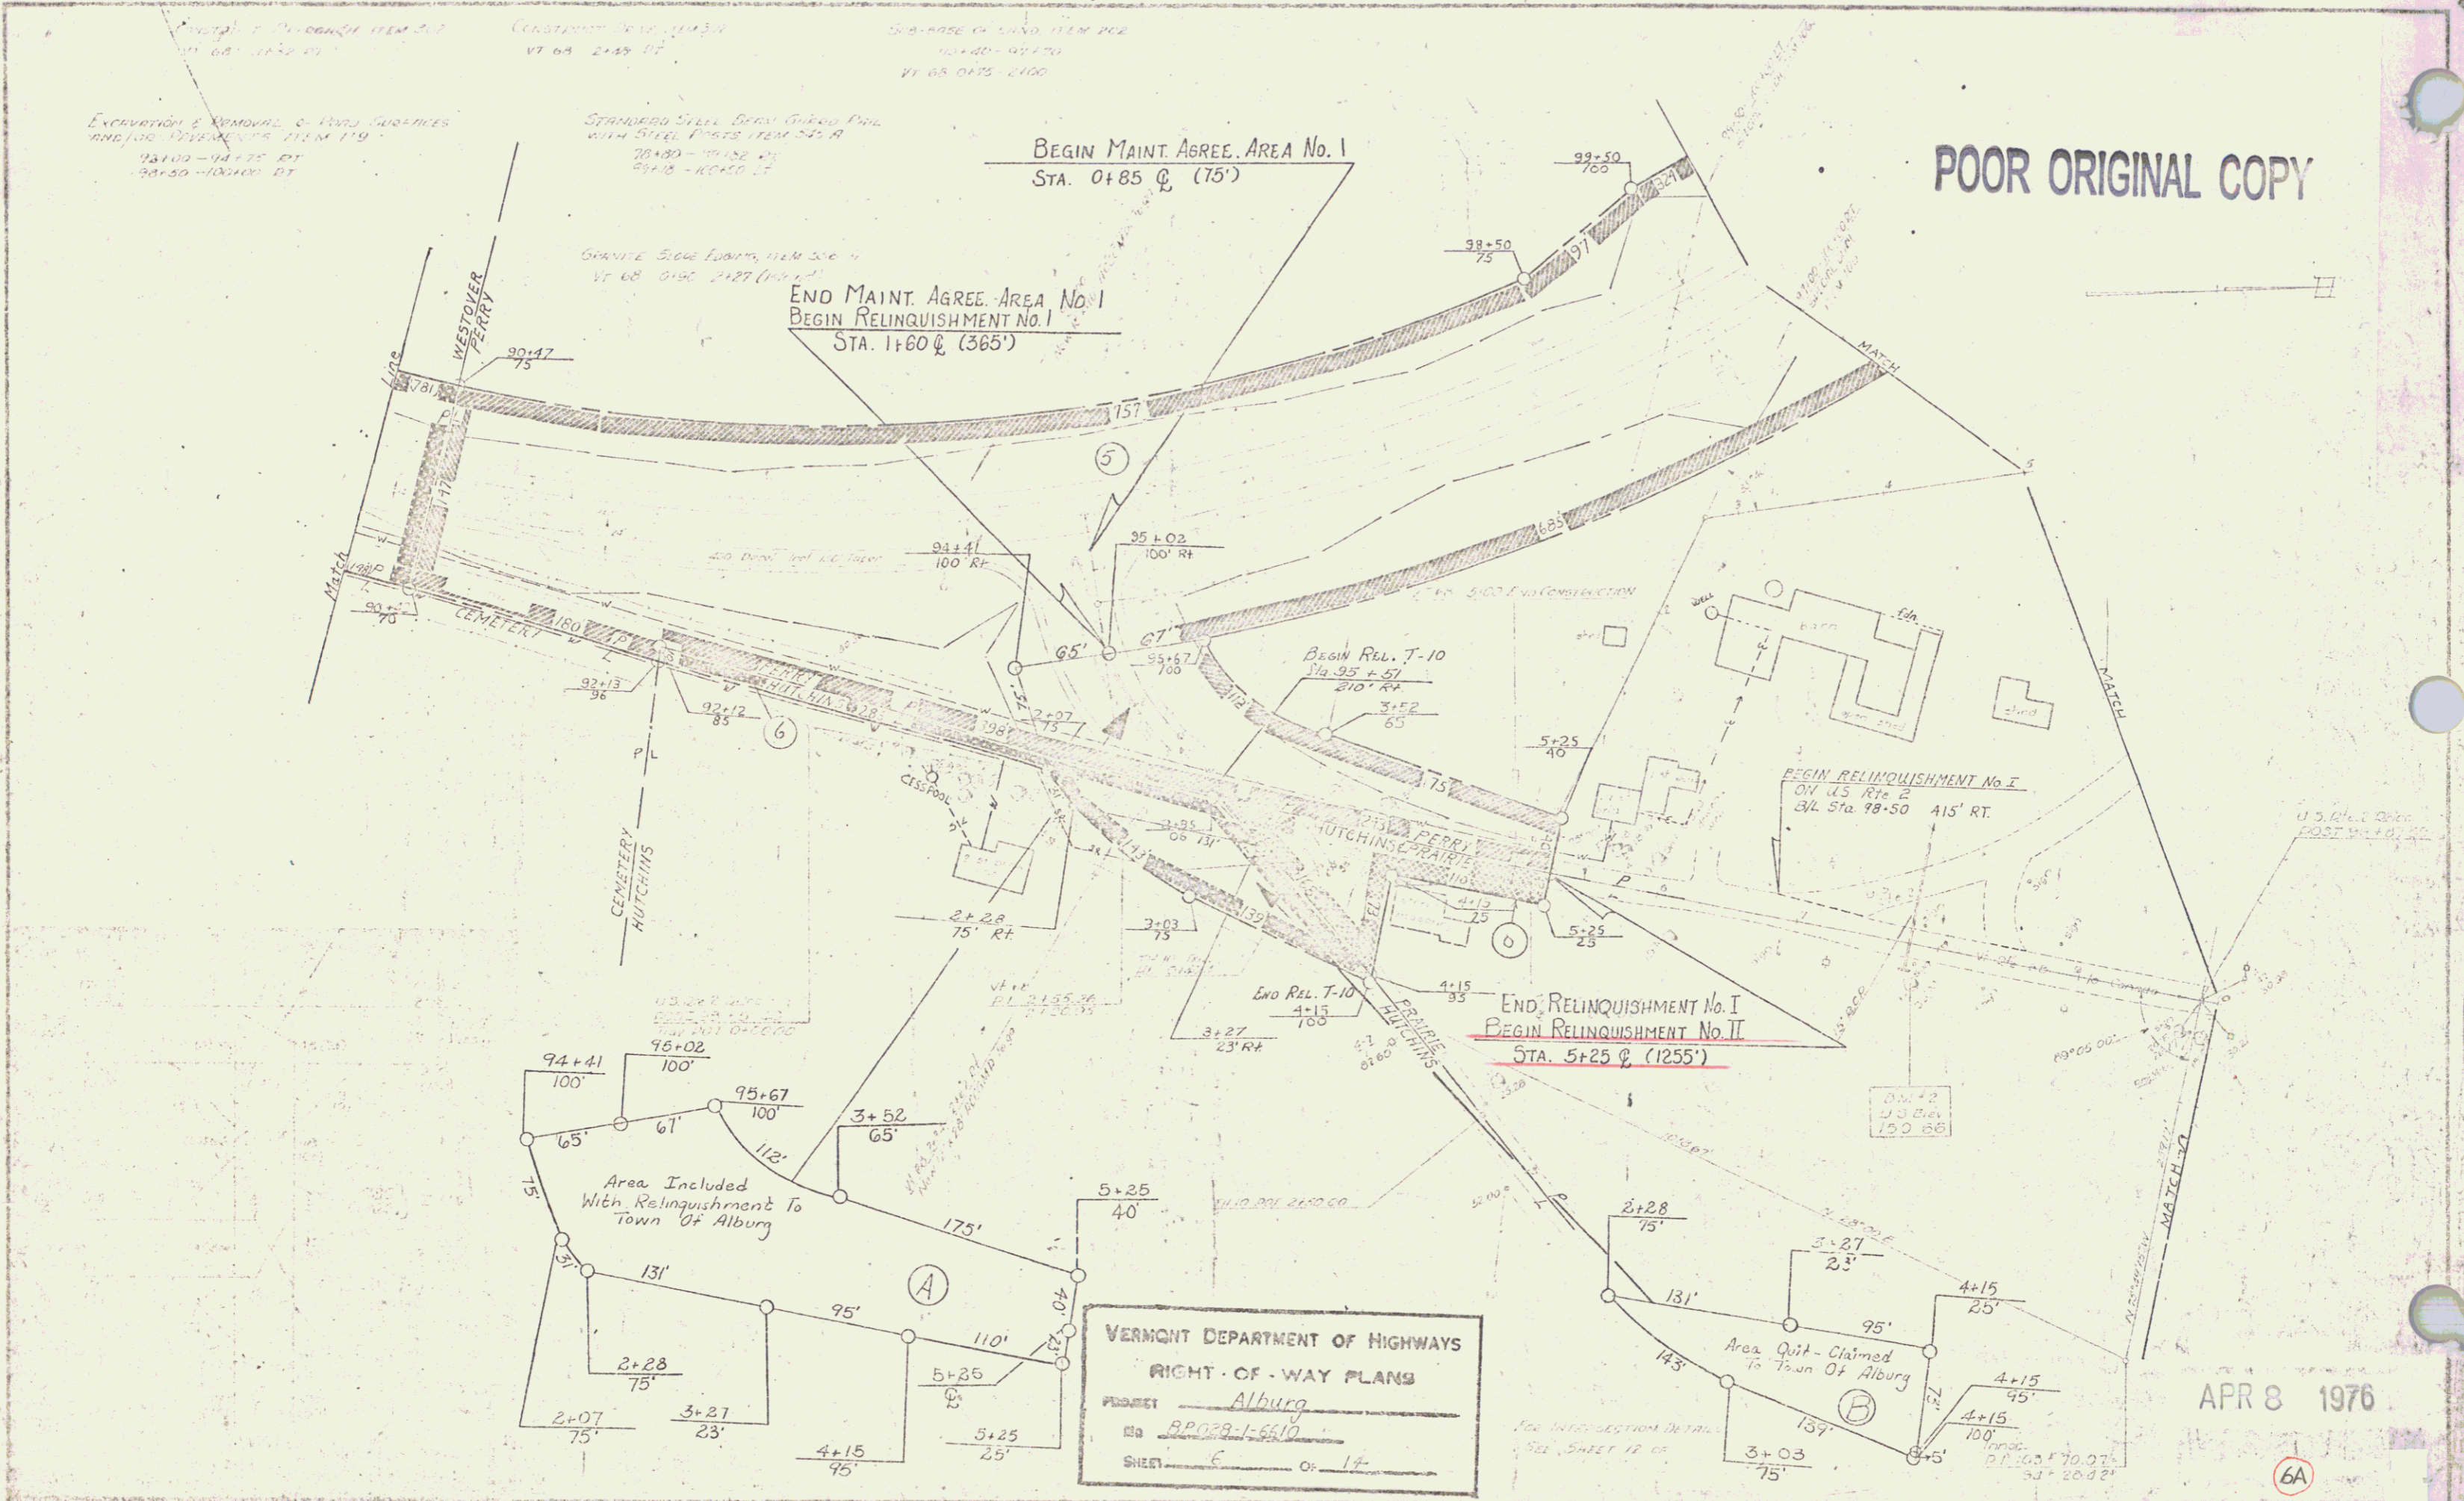

Excavation & Removal of Road Surfaces and/or Pavements Item 119 28100-4475 RT 28150-10200 RT

Constant 100' from 113.5' VT 68 2147 RT

20' Rise of Sand from 112' 10240-42170 41 65 0175 2160

Standard Steel Beam Girder Pile with Steel Piles Item 545 A 70+30 - 70+50 RT 2915 - 4050 RT

Granite Edge Easement Item 306 H VT 68 0150 2127 (100' RT)

BEGIN MAINT. AGREE. AREA No. 1 STA. 0+85 @ (75')

END MAINT. AGREE. AREA No. 1 BEGIN RELINQUISHMENT No. I STA. 1+60 @ (365')

BEGIN RELINQUISHMENT No. I ON U.S. RT. 2 STA. 98+50 415' RT.

END RELINQUISHMENT No. I BEGIN RELINQUISHMENT No. II STA. 5+25 @ (1255')

Area Included With Relinquishment To Town Of Alburg

Area Quit-Claimed To Town Of Alburg

VERMONT DEPARTMENT OF HIGHWAYS
 RIGHT-OF-WAY PLANS
 PROJECT Alburg
 Sta. RPO28-1-5610
 SHEET E OF 17

APR 8 1976

6A