

INDEX OF SHEETS

SHEET NO. 1	TITLE PAGE
2	TYPICAL CROSS-SECTION OF IMPROVEMENT
3	PAVING AND WEARING TABLES
4	PLAN AND PROFILE SHEETS
5	STANDARD STRUCTURE SHEET 5-23 PIPE CULVERTS
6	5-30 GUARD RAIL
7	BARRICADES, SIGNS AND LIGHTS 5B-11
8	SPECIAL CULVERT CROSS SECTION SHEETS
9	CROSS SECTIONS

STANDARD SHEET 5-20 SUBMITTED TO THE CHIEF ENGINEER ON MAY 16, 1933.  
STANDARD SHEET 5-30 SUBMITTED TO THE CHIEF ENGINEER ON AUG 14, 1933.

(To Be Returned To R.O.W. Division)

Town of US2  
PERPETUAL  
NON FILE  
RIGHT-OF-WAY DIVISION

Rte U.S. #2

STATE OF VERMONT  
STATE HIGHWAY DEPARTMENT

PLAN AND PROFILE OF PROPOSED  
STATE HIGHWAY

NATIONAL RECOVERY HIGHWAY AND MUNICIPAL PROJECT



TOWN OF ALBURG

BURLINGTON-MONTREAL ROAD

FROM A POINT 400 FT. SOUTH FROM ALBURG VILLAGE LIMITS, NORTHERLY 1.901 MILES TO THE INTERSECTION OF US-2 AND ROUTE 104

LENGTH OF N.R.H. PROJECT - 2591.9 FT. = 0.490 MILES  
LENGTH OF N.R.M. PROJECT - 7450.4 FT. = 1.411 MILES

NO.	DATE	BY	REVISION
1	1933		

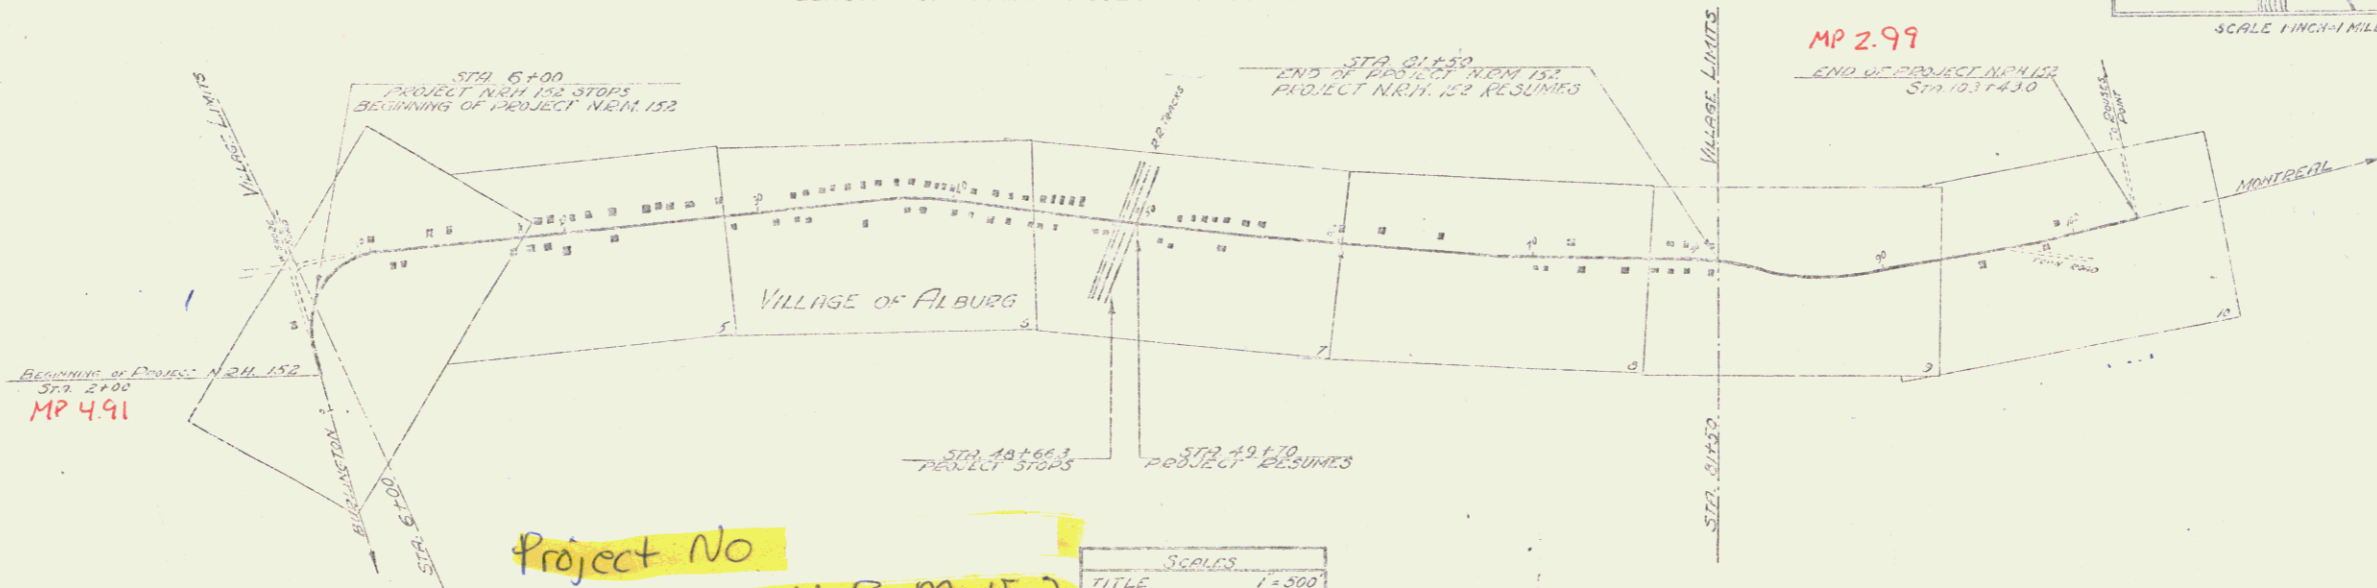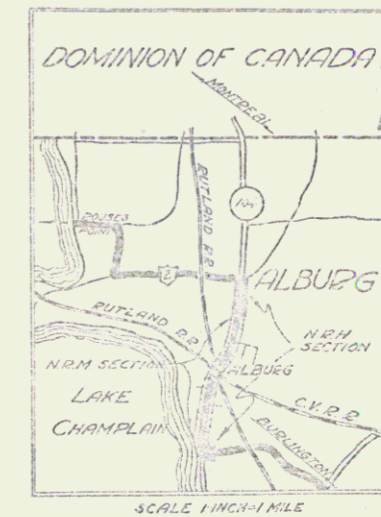

POINT	STATION	LENGTH
START	6+00	
END	10+50	4500

CONVENTIONAL SIGNS

GROUND ELEVATION..... DATUM 10' 1/2"

GRADE ELEVATION..... DATUM 10' 1/2"

CURVE DATA

DEFLECTION ANGLE	Δ
DEGREE OF CURVE	D
RADIUS OF CURVE	R
TANGENT DISTANCE	T
LENGTH OF CURVE	L
EXTERNAL DISTANCE	E
POINT OF INTERSECTION	P. I.
POINT OF CURVE	P. C.
POINT OF TANGENT	P. T.
POINT ON TANGENT	P. O. T.

Project No N.R.M 152  
Pin # 99R002

SCALES

TITLE	1" = 300'
PLAN	1" = 50'
PROFILE	1" = 10'
CROSS SECTIONS	1" = 5'

RECORD PLANS

THESE PLANS ARE SUBJECT TO SUCH REVISIONS AS MAY BE REQUIRED BY THE BOARD OF PUBLIC ROADS OR THE COMMISSIONER OF HIGHWAYS. CONSTRUCTION IS TO BE CARRIED ON IN ACCORDANCE WITH THE STANDARD ROAD AND BRIDGE SPECIFICATIONS OF 1930 WITH ALL SUBSEQUENT APPROVED REVISIONS AND SUCH SPECIFICATIONS AND SPECIAL REVISIONS AS ARE SUBMITTED WITH THE PLANS.

APPROVED: September 22, 1933  
Richard S. ...  
COMMISSIONER OF HIGHWAYS

RECOMMENDED FOR APPROVAL

RECOMMENDED FOR APPROVAL

APPROVED

APPROVED: ... SERIES 400 SHEET NO. 152 SHEET 1 OF 11

STEARNS R. JENKINS

US2