
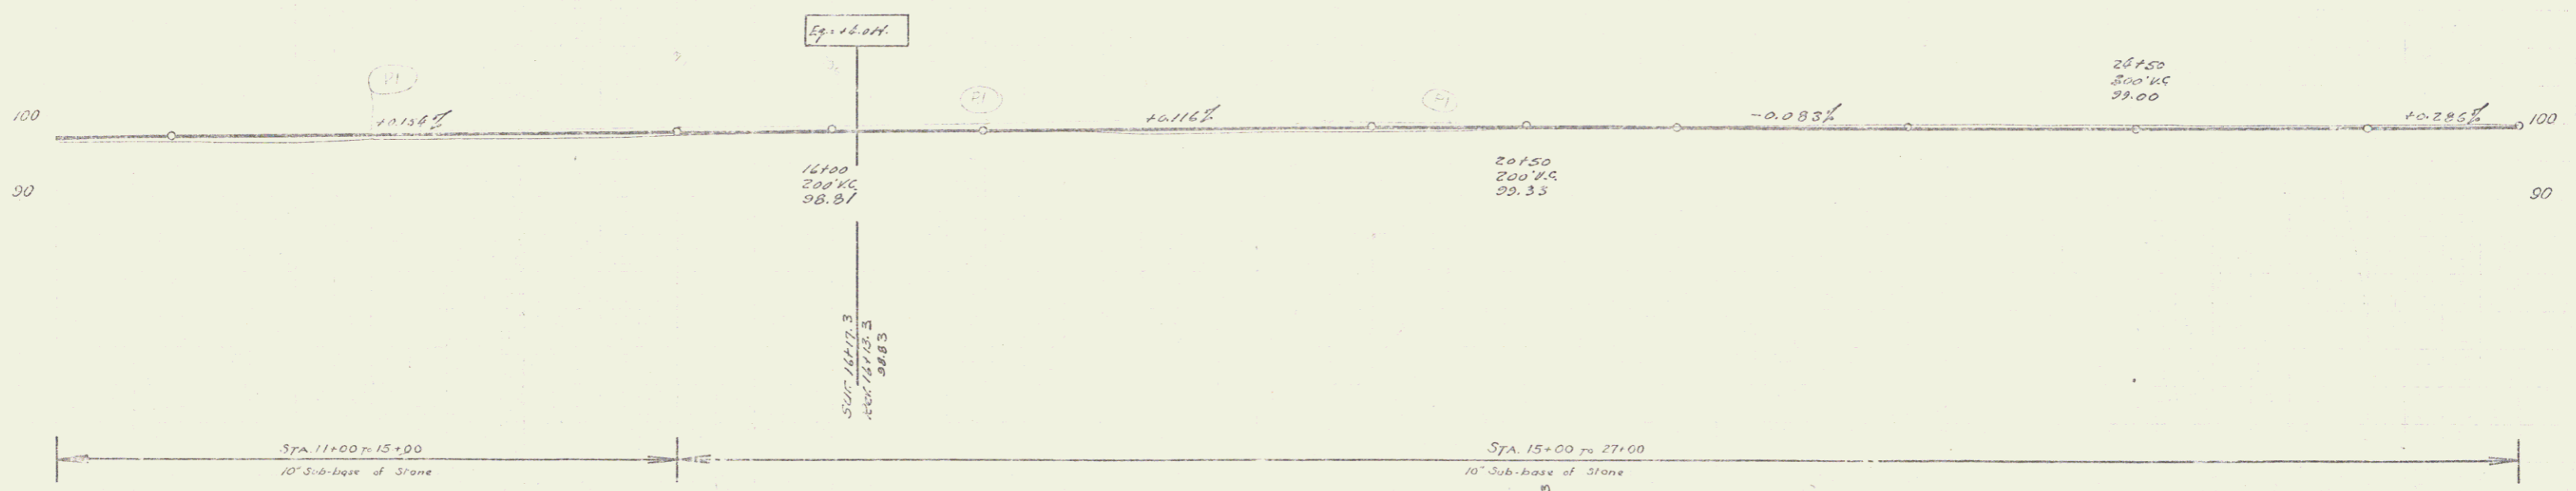


Parcel	Map of Instrument	Date of Instrument	Grantor	Grantee	Recorded	Remarks
Calvert #1	O.C.D.	11-10-33	M.J. Odell	Sta. 17	23 33	12-1-33 Sta. 19, 20, 21
" #2	O.C.D.	11-10-33	W.J. Maurice	" "	23 34	12-1-33 Sta. 22, 23, 24

NRM
152 1981 5 41

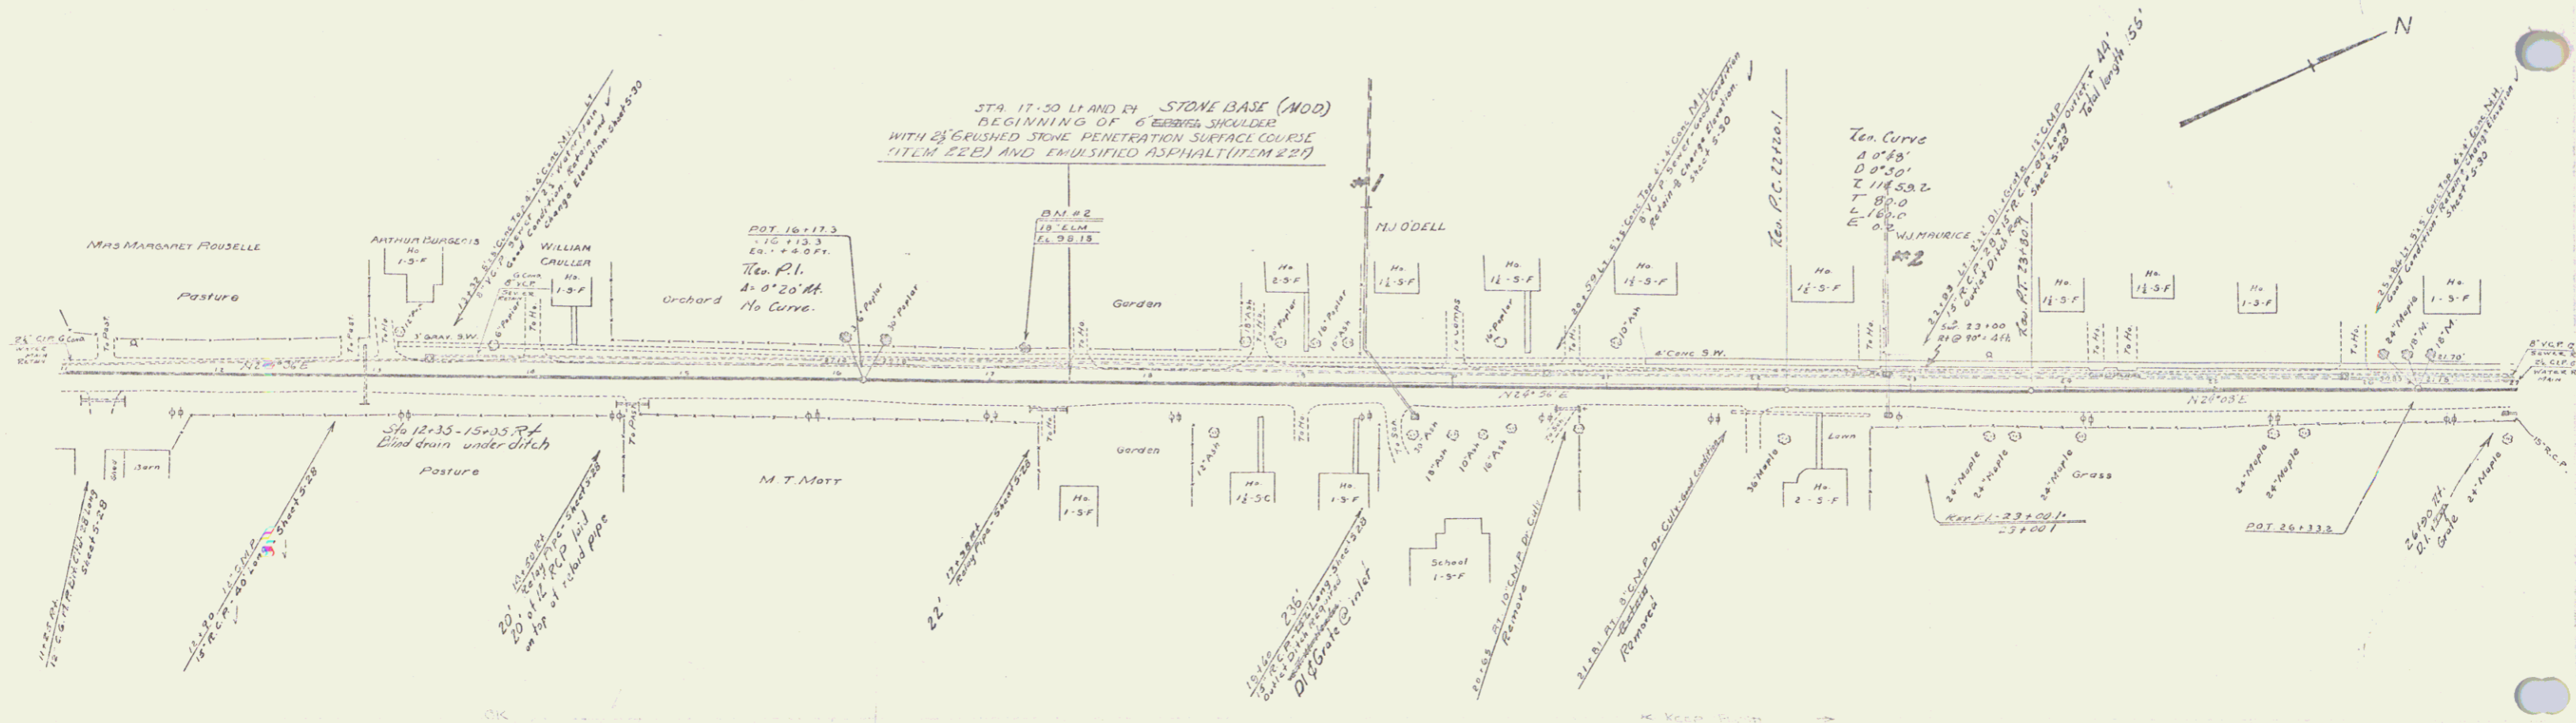

Station	Elevation
11	97.89
11.50	98.2
12	98.10
12.50	98.05
13	98.10
13.50	98.1
14	98.10
14.50	98.1
15	98.1
B.M. #2 SPIKE IN POOL OF 16' L.W. 12' LT. OF STA. 17+20 ELEV. 98.15

Sta. 25 N.M. 152
Sheet 41

3