
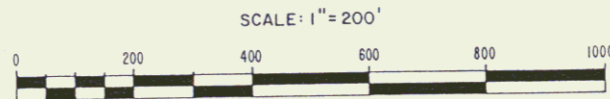


*Transferred to Agency of Env. Conservation, Forests + Parks by Exec. Order dated 6/1/83 + subsequently transferred to the Town of Alburg by ACD dated 6/1/83 + recorded in Book 49, Pages 424-427.*

- LEASED AREAS
- 1- ALBURG VOLUNTEER FIRE DEPT, INC.
  - 2- P. J. MEDOR, INC.
  - 3- TOWN OF ALBURG
  - 4- TOWN OF ALBURG
  - 5- VILLAGE OF ALBURG
  - 6- ALBURG VOLUNTEER FIRE DEPT, INC.
  - 7- TOWN OF ALBURG

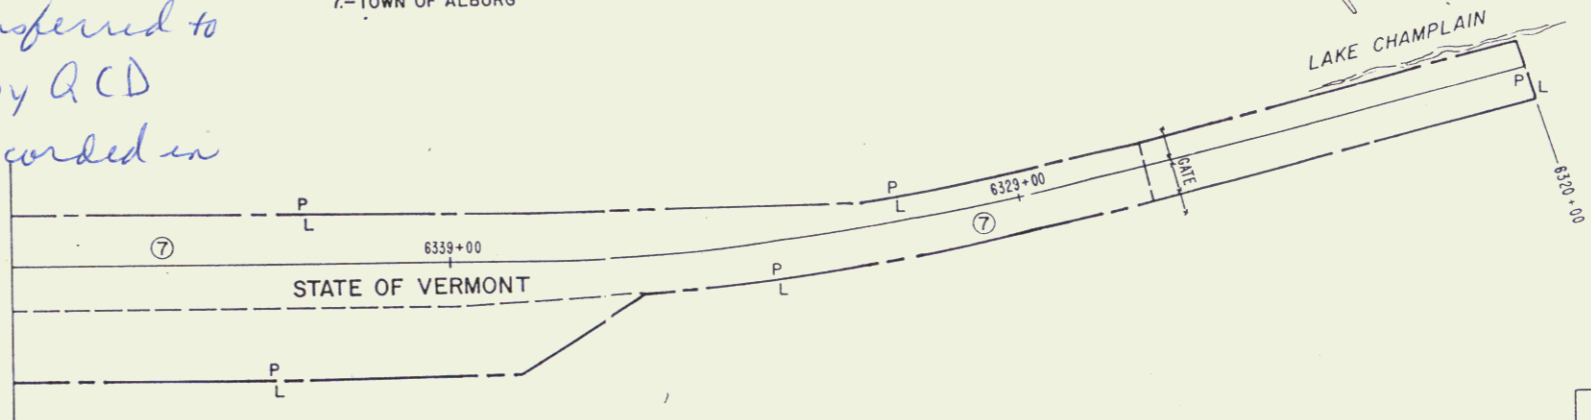

6B  
 STATE OF VERMONT  
 AGENCY OF TRANSPORTATION  
 TOWN OF ALBURG  
 STATE OF VERMONT AGENCY OF TRANSPORTATION  
 TO  
 AGENCY OF ENVIRONMENTAL CONSERVATION  
 DEPARTMENT OF FOREST & PARKS  
 6