


Lessees

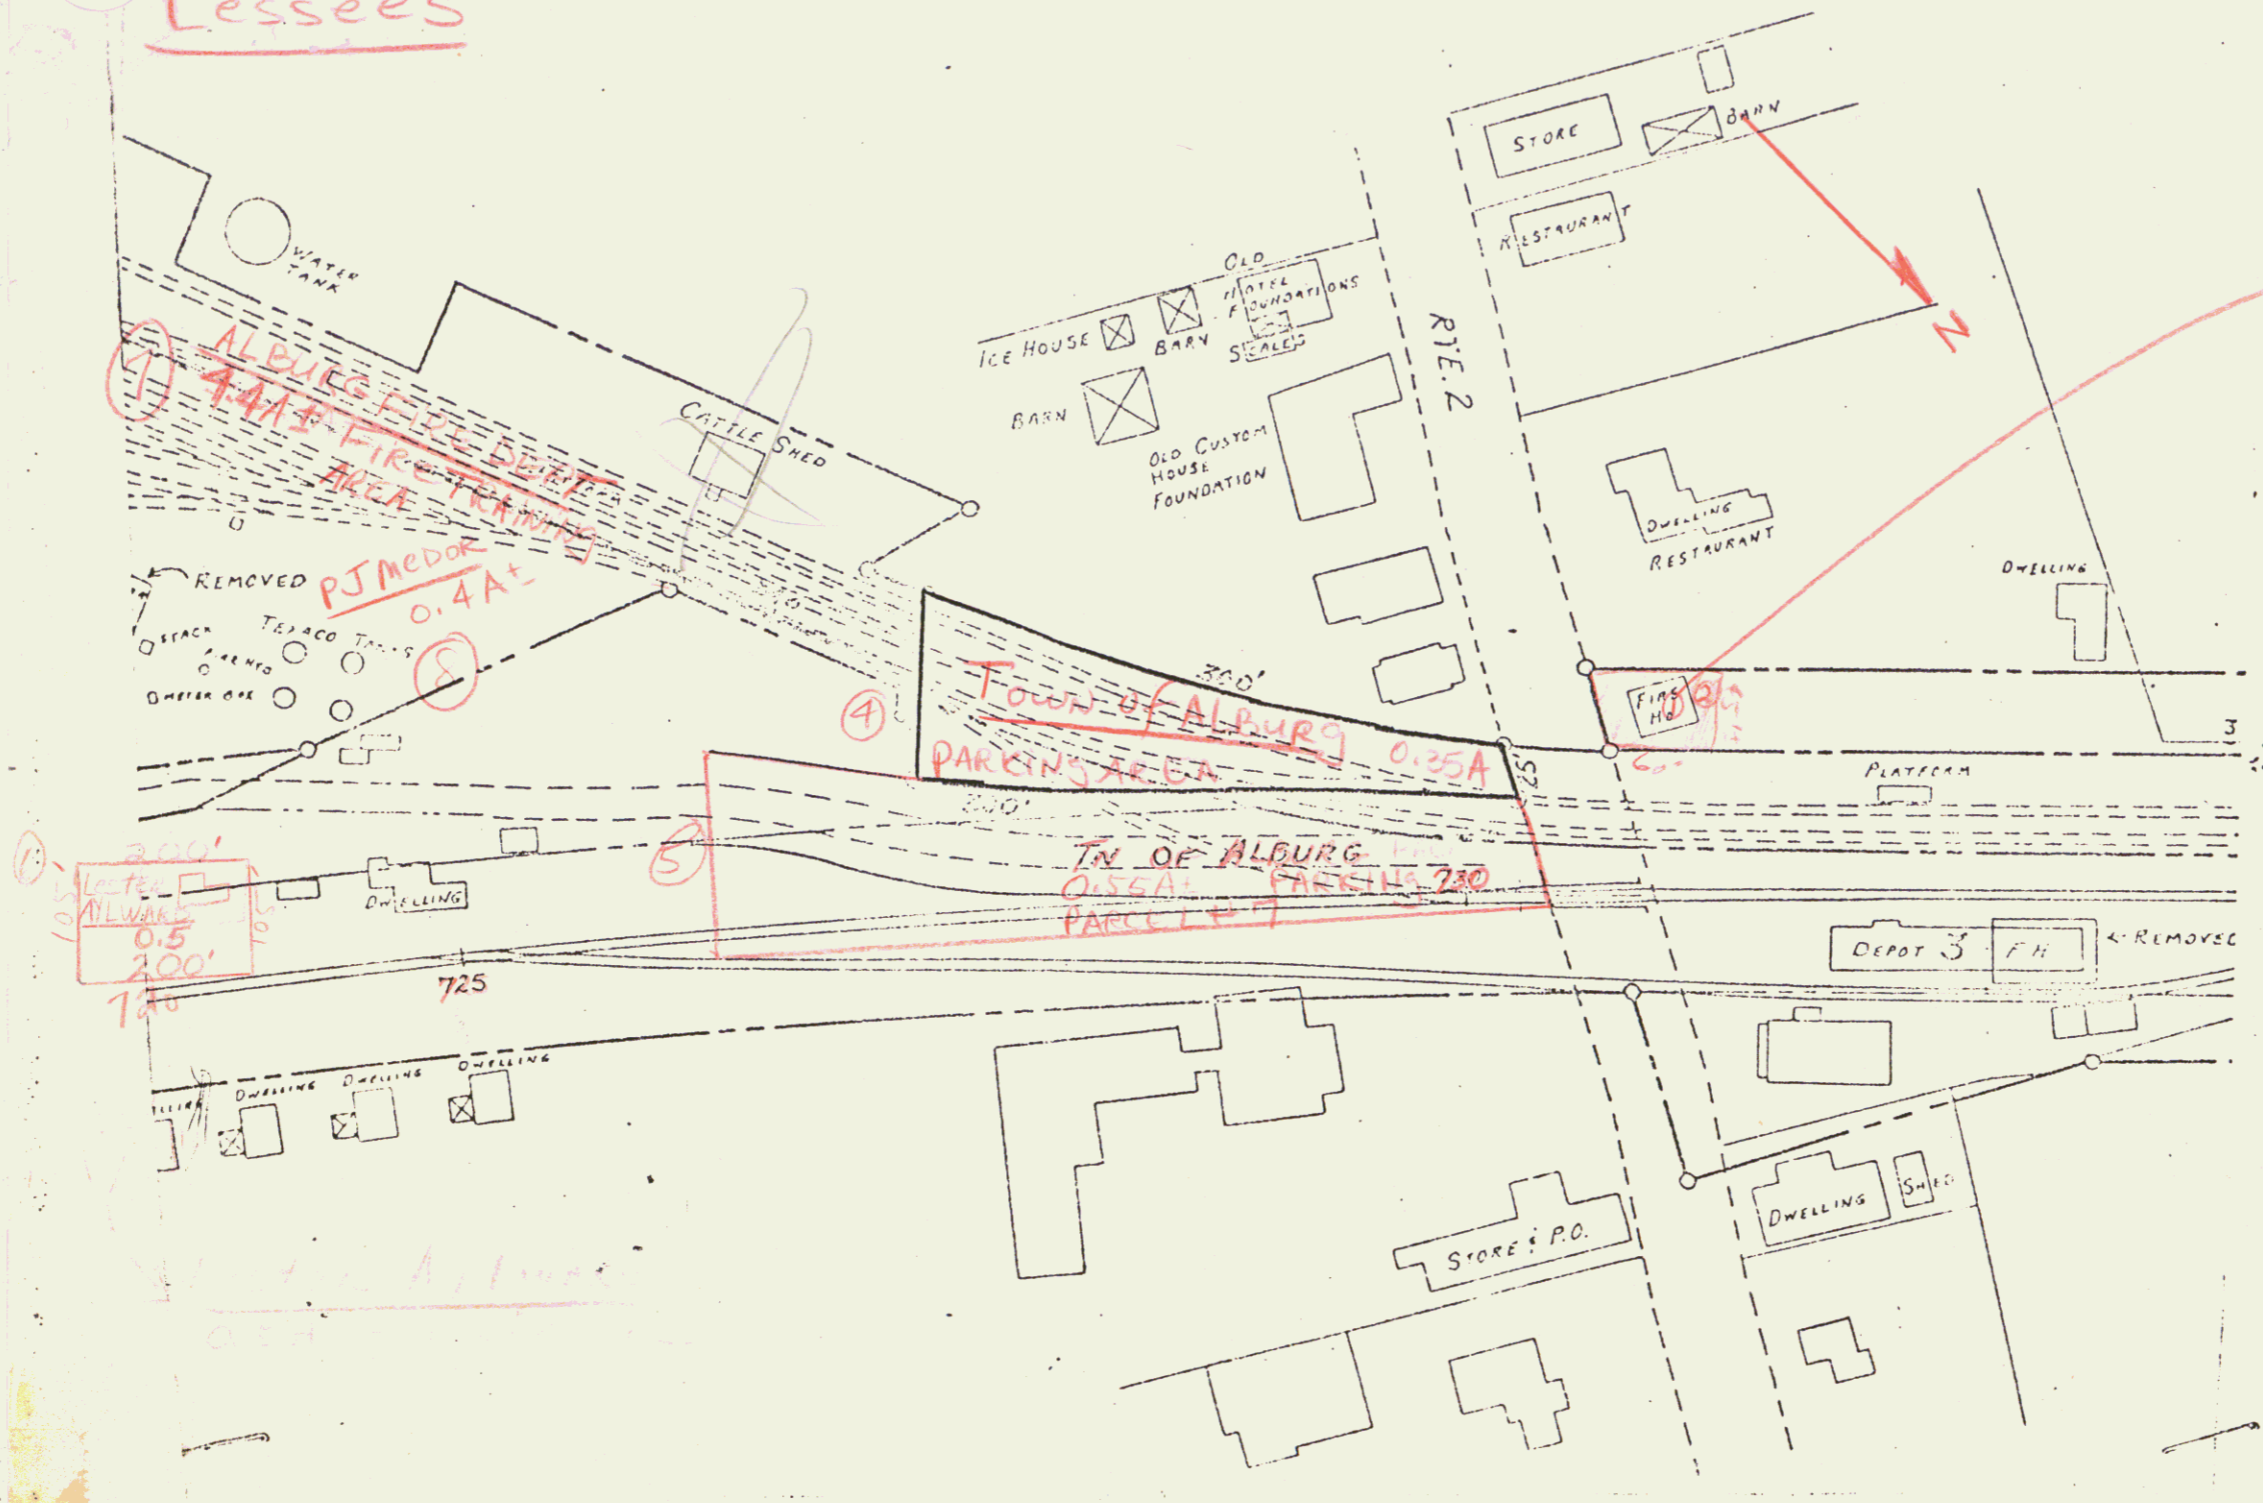

Alburg Fire Dept: 0.45A+
Village of ALBURG 0.06 fire house

Parcel # 8 12.0A
Town of Alburg for Highway Stations 745+ 765+

6C

7