
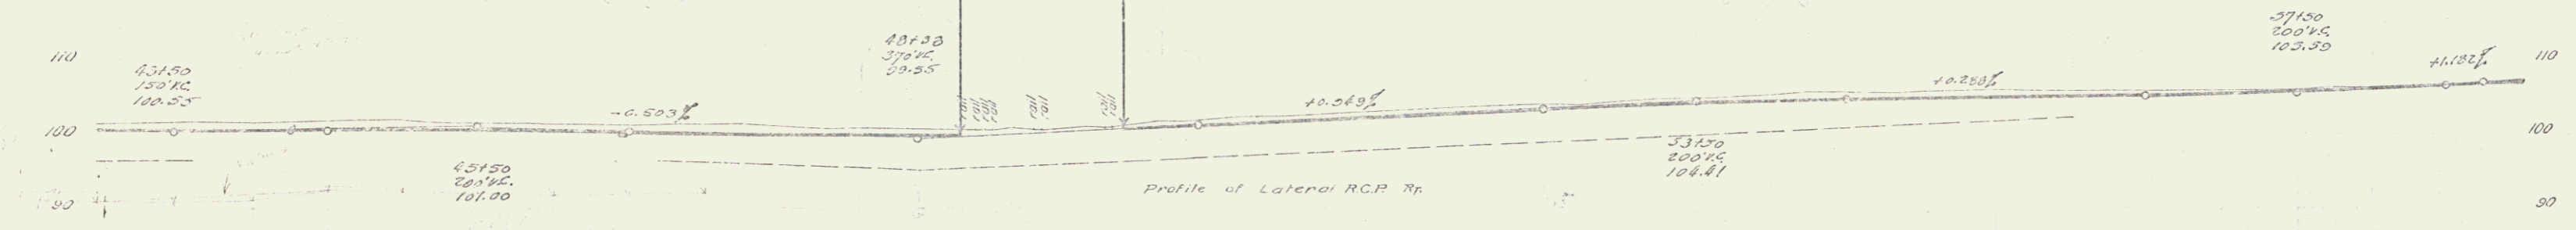


Reel	Kind of Instrument	Date of Instrument	Grantor	Grantee	Recorded	Remarks
Paper B	Adjustment	11-25-23	C. Y. Ry. Inc.	State of N.Y.	23 Jan 27-54	The RCP shows one on N.Y. RR. One under tracks.

POOR ORIGINAL COPY

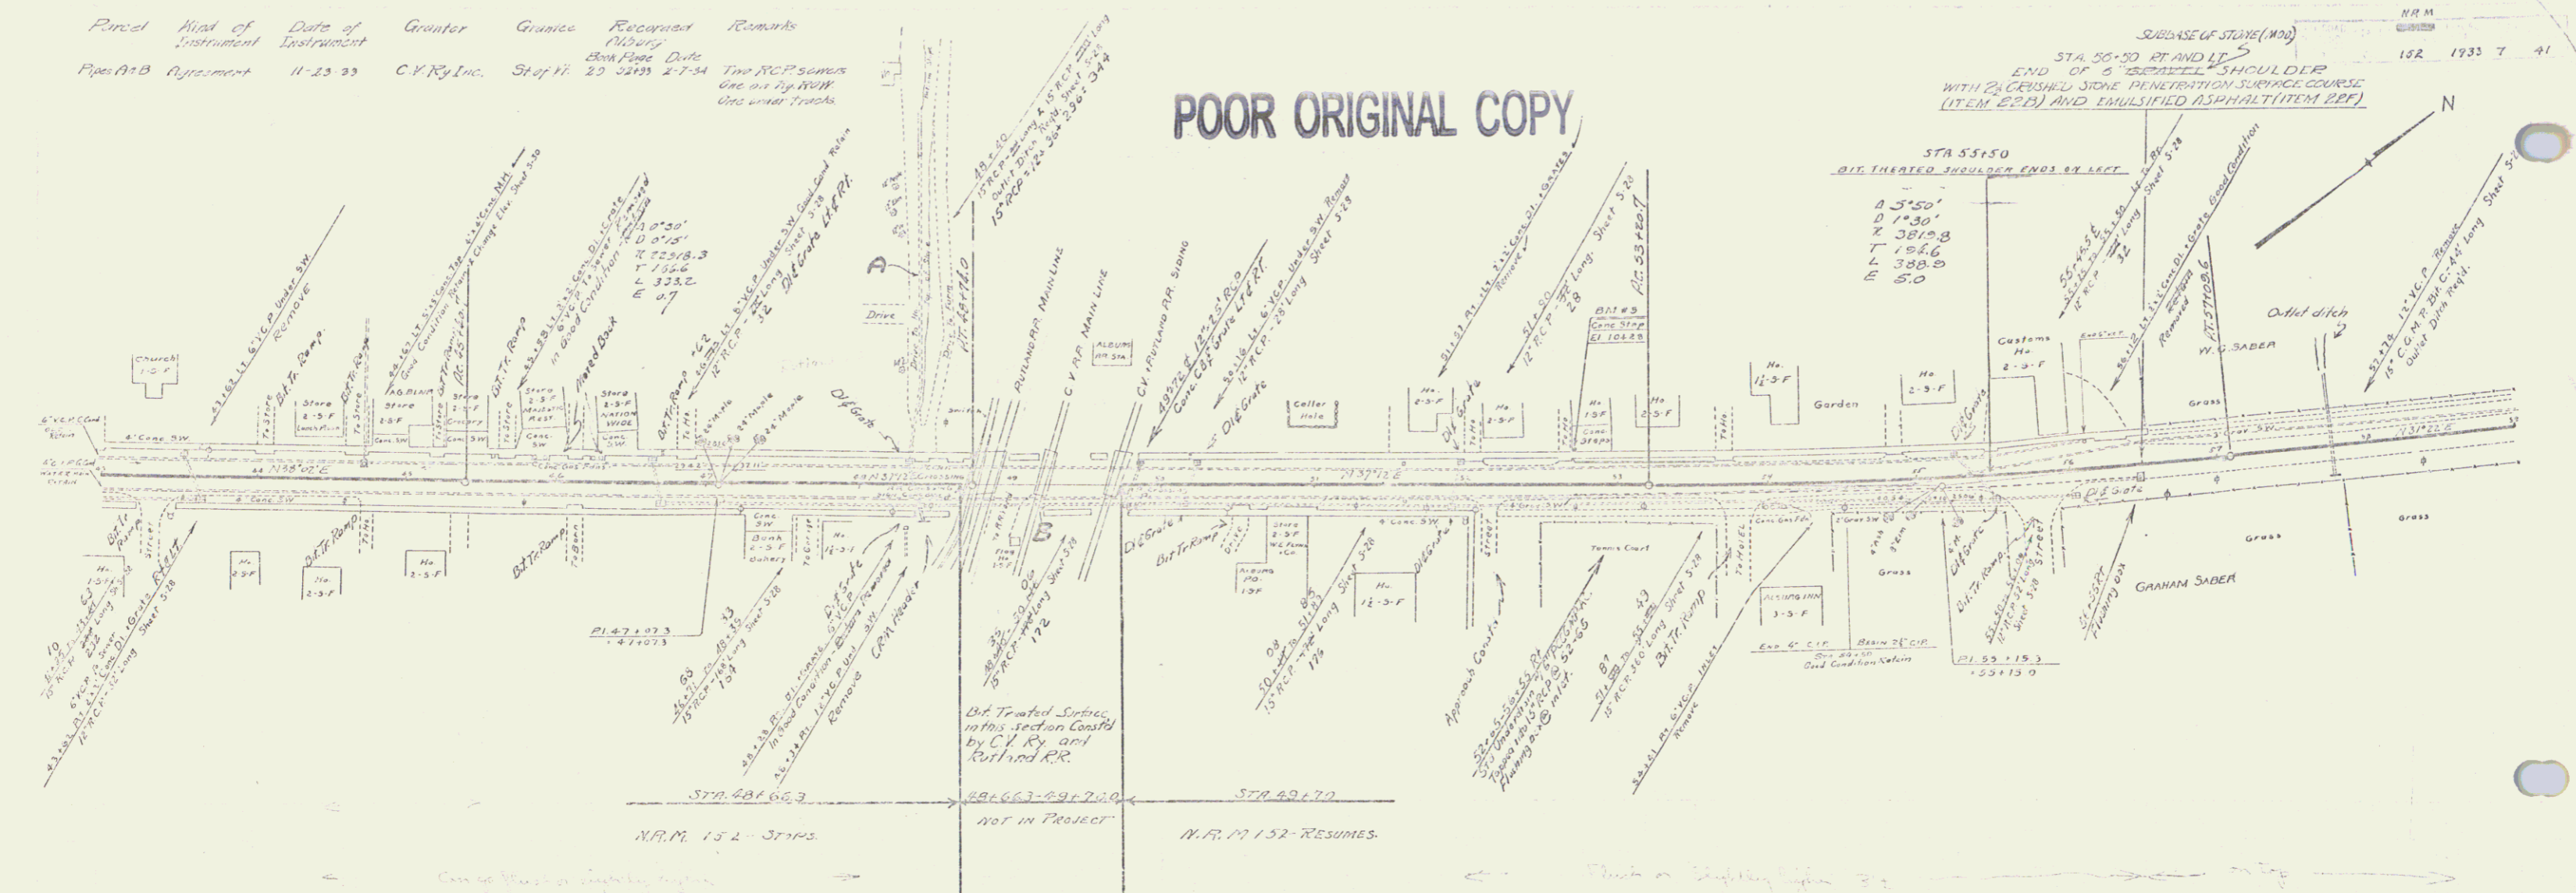

Station	Elevation	Station	Elevation	Station	Elevation
43+00	100.55	44+00	101.00	45+00	101.50
44+00	101.00	45+00	101.50	46+00	102.00
45+00	101.50	46+00	102.00	47+00	102.50
46+00	102.00	47+00	102.50	48+00	103.00
47+00	102.50	48+00	103.00	49+00	103.50
48+00	103.00	49+00	103.50	50+00	104.00
49+00	103.50	50+00	104.00	51+00	104.50
50+00	104.00	51+00	104.50	52+00	105.00
51+00	104.50	52+00	105.00	53+00	105.50
52+00	105.00	53+00	105.50	54+00	106.00
53+00	105.50	54+00	106.00	55+00	106.50
54+00	106.00	55+00	106.50	56+00	107.00
55+00	106.50	56+00	107.00	57+00	107.50
56+00	107.00	57+00	107.50	58+00	108.00
57+00	107.50	58+00	108.00	59+00	108.50

B.M. 5 SPOT ON CONC. STEP 23' 21" OF STA. 52+61 ELEV. 104.28

SHEET N.Y. RR. 152 OF 41

15