

INDEX OF SHEETS	
SHEET NO. 1	TITLE PAGE
" 2	TYPICAL CROSS-SECTION OF IMPROVEMENT
" 3	BANKING AND WIDENING TABLES
" 4	PLAN AND PROFILE STA.
" 5	STANDARD STRUCTURE SHEET 5-28 PIPE CULVERTS
" 6	" " " " 5-29 BOX " "
" 7	" " " " 5-30 GUARD RAIL
" 8	" " " " 5-31 DRAINAGE MARKERS
" 9	" " " " 5-32 BRIDGES, SIGNS & LIGHTS
" 10-129	CROSS SECTION SHEETS

STATE OF VERMONT
STATE HIGHWAY DEPARTMENT

PLAN AND PROFILE OF PROPOSED
STATE HIGHWAY

FEDERAL AID PROJECT

TOWN OF ALBURG

Rte. U.S. #2

NORTH HERO-ALBURG ROAD

Pin # 99R004



STANDARD STRUCTURE SHEETS APPROVED BY THE CHIEF ENGINEER

5-28 & 5-29 JULY 11, 1933
5-30 AUG 13, 1933
5-31 JULY 25, 1934

BEGINNING AT A POINT 0.517 MI. WEST OF RUTLAND R.R. OVERPASS & EXTENDING SOUTHERLY 6.891 MI. TO NORTH HERO BRIDGE.

LENGTH OF GOVERNMENT PARTICIPATION	34074.9 FT. = 6.453 MILES
LENGTH OF NON - GOVERNMENT PARTICIPATION	1925.0 " = 0.365 "
STATE PROJECT	384.7 " = 0.073 "
TOTAL LENGTH OF PROJECT	36384.6 " = 6.891 "

FED. AID	STATE	FED. AID	STATE	FED. AID	STATE	FED. AID	STATE
9	1	9	1	9	1	9	1

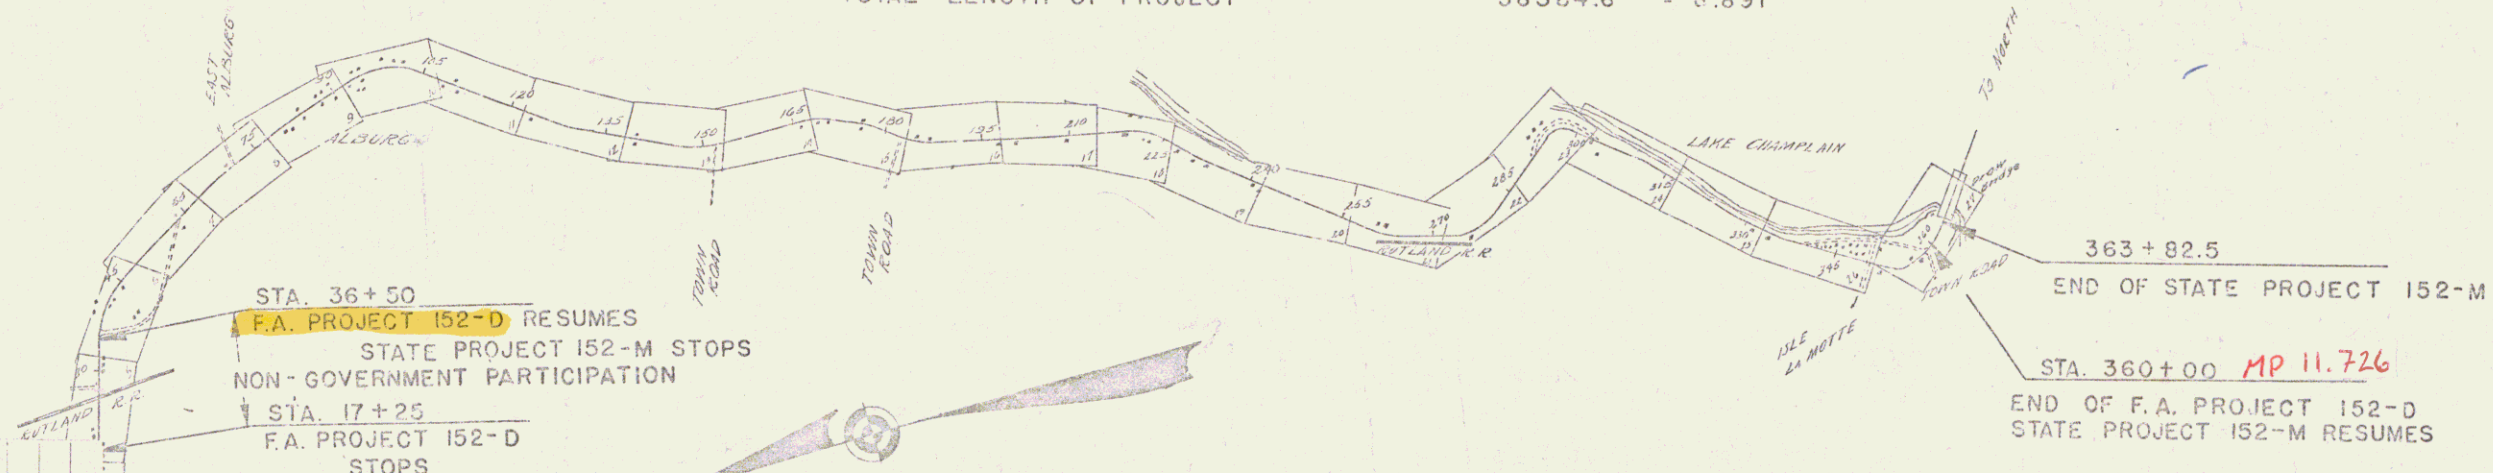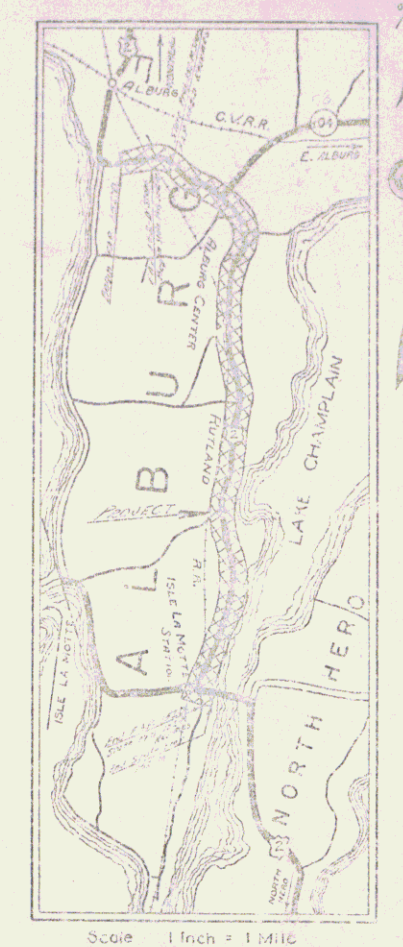

GROUND ELEVATION	DATE	LINE

CURVE DATA	
1. REFLECTION ANGLE	Δ
2. DEGREE OF CURVE	D
3. RADIUS OF CURVE	R
4. TANGENT DISTANCE	T
5. LENGTH OF CURVE	L
6. EXTERNAL DISTANCE	E
7. POINT OF INTERSECTION	P. I.
8. POINT OF CURVE	P. C.
9. POINT OF TANGENT	P. T.
10. POINT ON TANGENT	P. O. T.

SCALES	
TITLE	1" = 1500'
TYPICAL	1" = 2'
PLAN	1" = 30'
PROFILE	1" = 10'
CROSS SECTIONS	1" = 5'

RECORD PLANS

These plans are subject to such revisions as may be required by the Bureau of Public Roads or the Commissioner of Highways. Construction is to be carried on in accordance with the plans and Standard Road & Bridge Specifications as approved Dec. 29, 1936 by the Bureau of Public Roads, including all subsequent approved revisions and such revised specifications and special provisions as are submitted with the plans.

RIGHT-OF-WAY DIVISION
TOWN FILE
PERPETUAL
Town of US 2
([To Be Returned To R.O.W. Division])

APPROVED: August 27, 1937
COMMISSIONER OF HIGHWAYS

RECOMMENDED FOR APPROVAL: [Signature]
DISTRICT ENGINEER, BUREAU OF PUBLIC ROADS

APPROVED: [Signature]
DIRECTOR, BUREAU OF PUBLIC ROADS

SHEET 1 OF 129

STEARNS R. JENKINS US 2 1