


PARCEL	INSTRUMENT	DATE	GRANTOR	GRANTEE	RECORDED	REMARKS
A-B-C	Q.C.D.	9-22-37	DAVID MARTIN	SPRINT	300	DATE 12-15-37
A'	Q.C.D.	11-26-37	MRS FLORENCE MARTIN	"	277	" 12-1-37

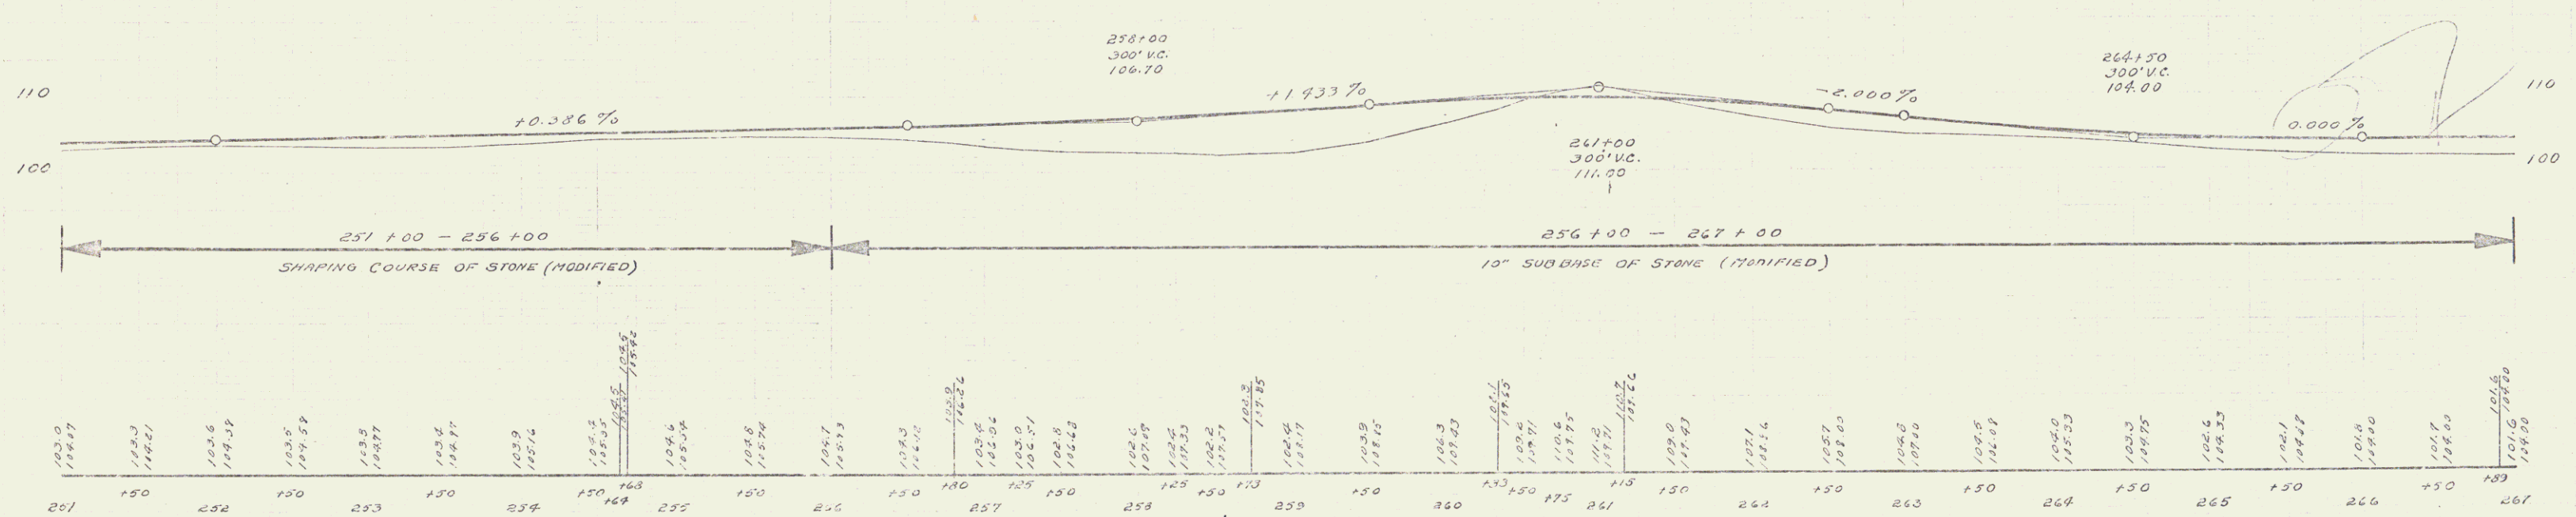

DATA FOR 18" ASP. 36" LT. 75' RADIUS. ELEV. 100.20  
 18" ASP. 36" LT. 75' RADIUS. ELEV. 100.20