



1360 2938 22 169

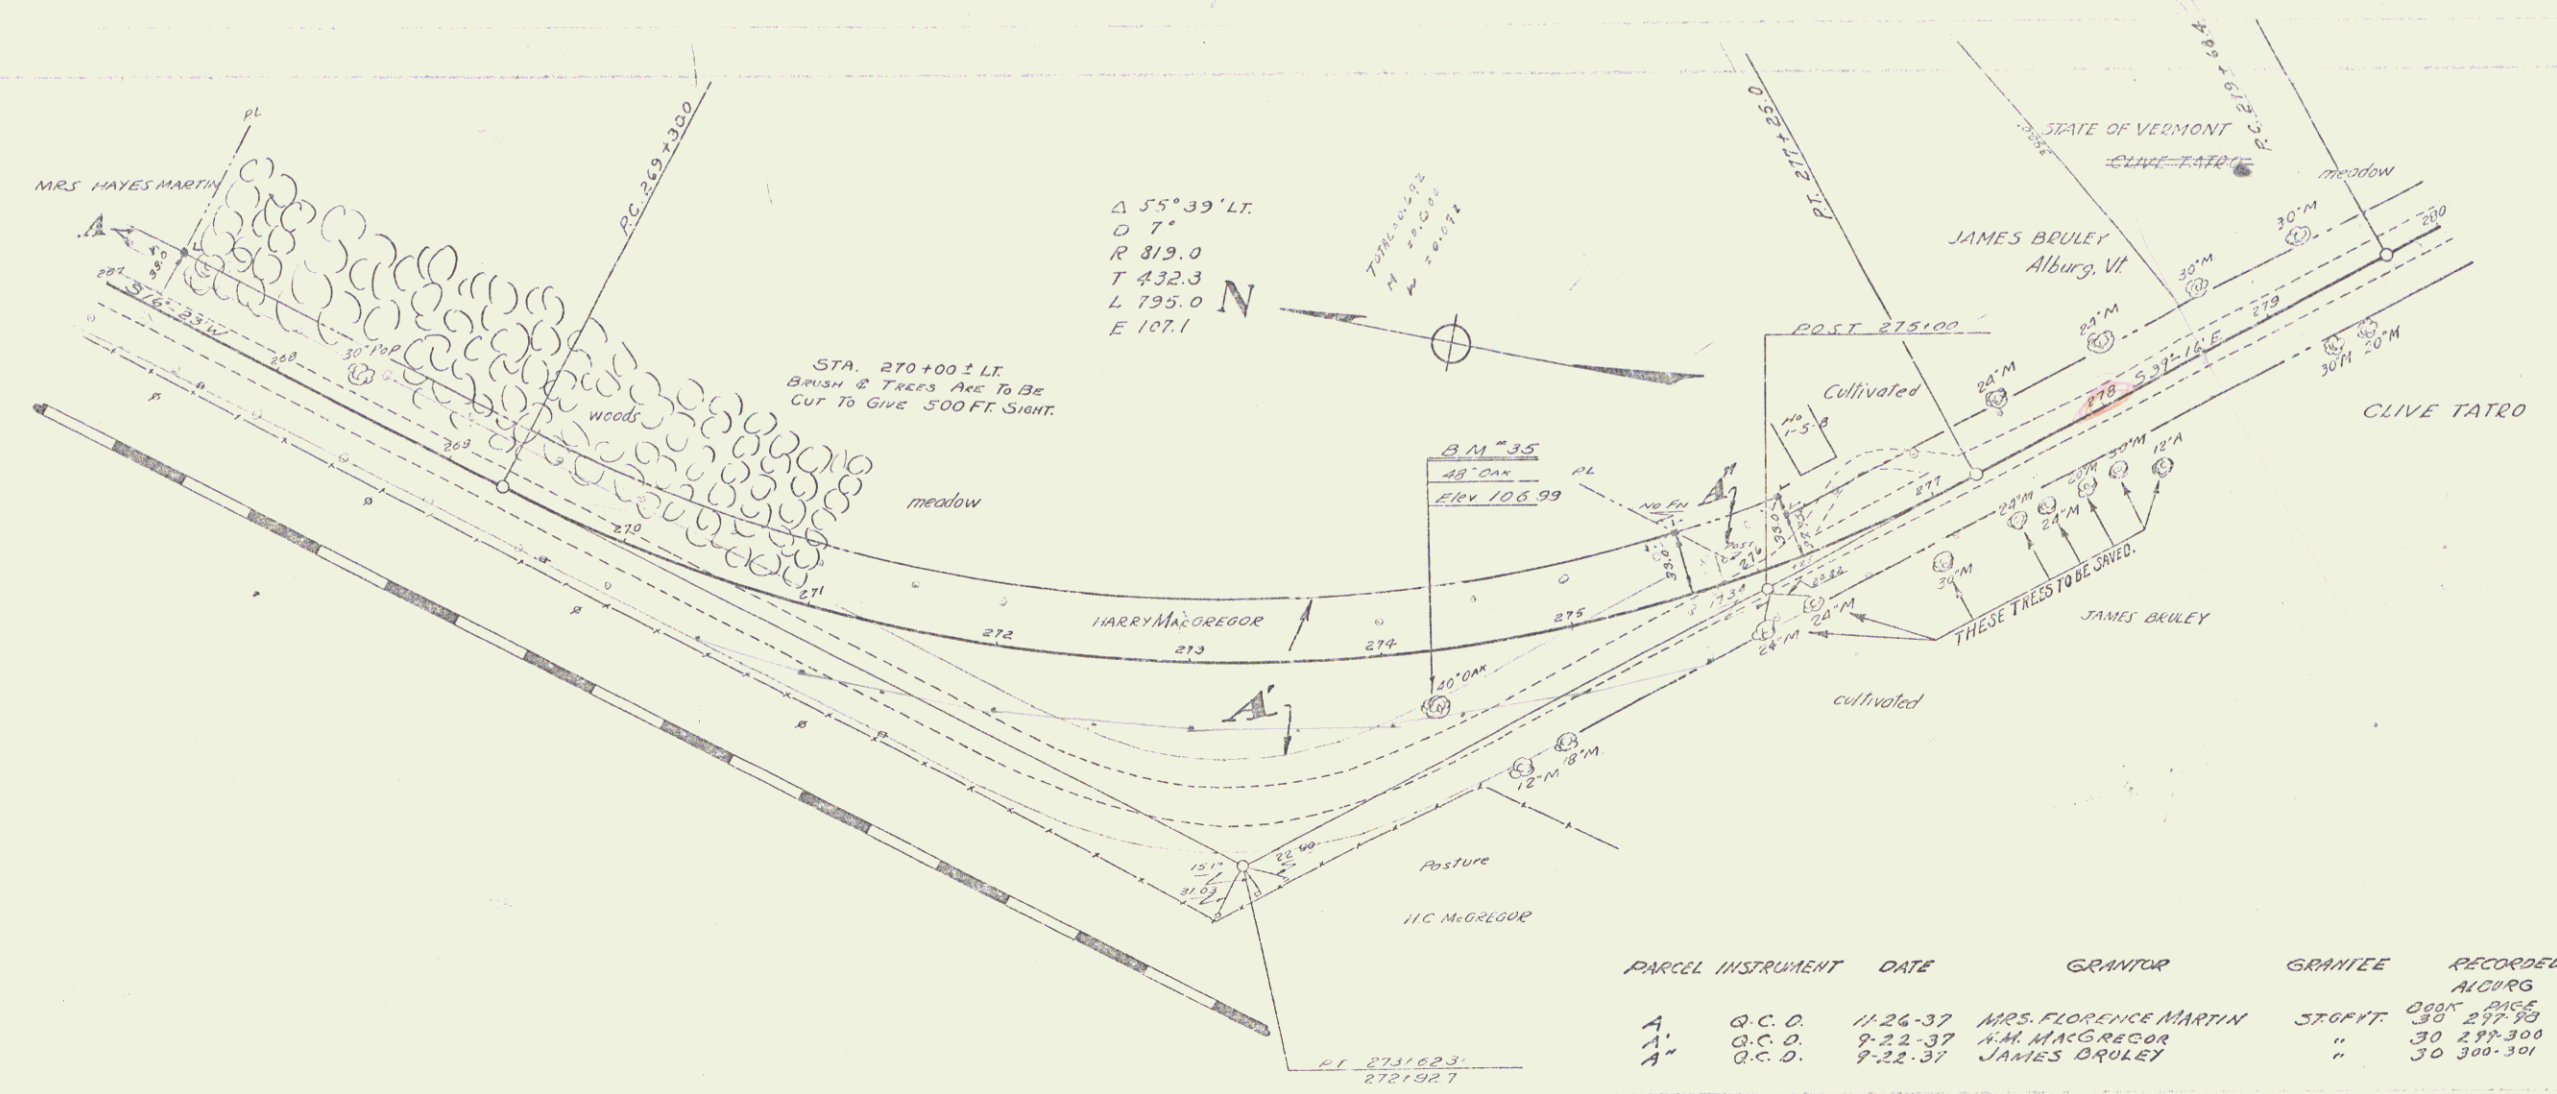

PARCEL	INSTRUMENT	DATE	GRANTOR	GRANTEE	RECORDED	REMARKS
A	G.C.D.	11-24-37	MRS. FLORENCE MARTIN	STOFFT	30 277-300	DATE 11-27-37
A	G.C.D.	9-22-37	H.H. MACGREGOR	"	30 277-300	DATE 9-25-37
A	G.C.D.	9-22-37	JAMES BROLEY	"	30 300-301	DATE 9-22-37

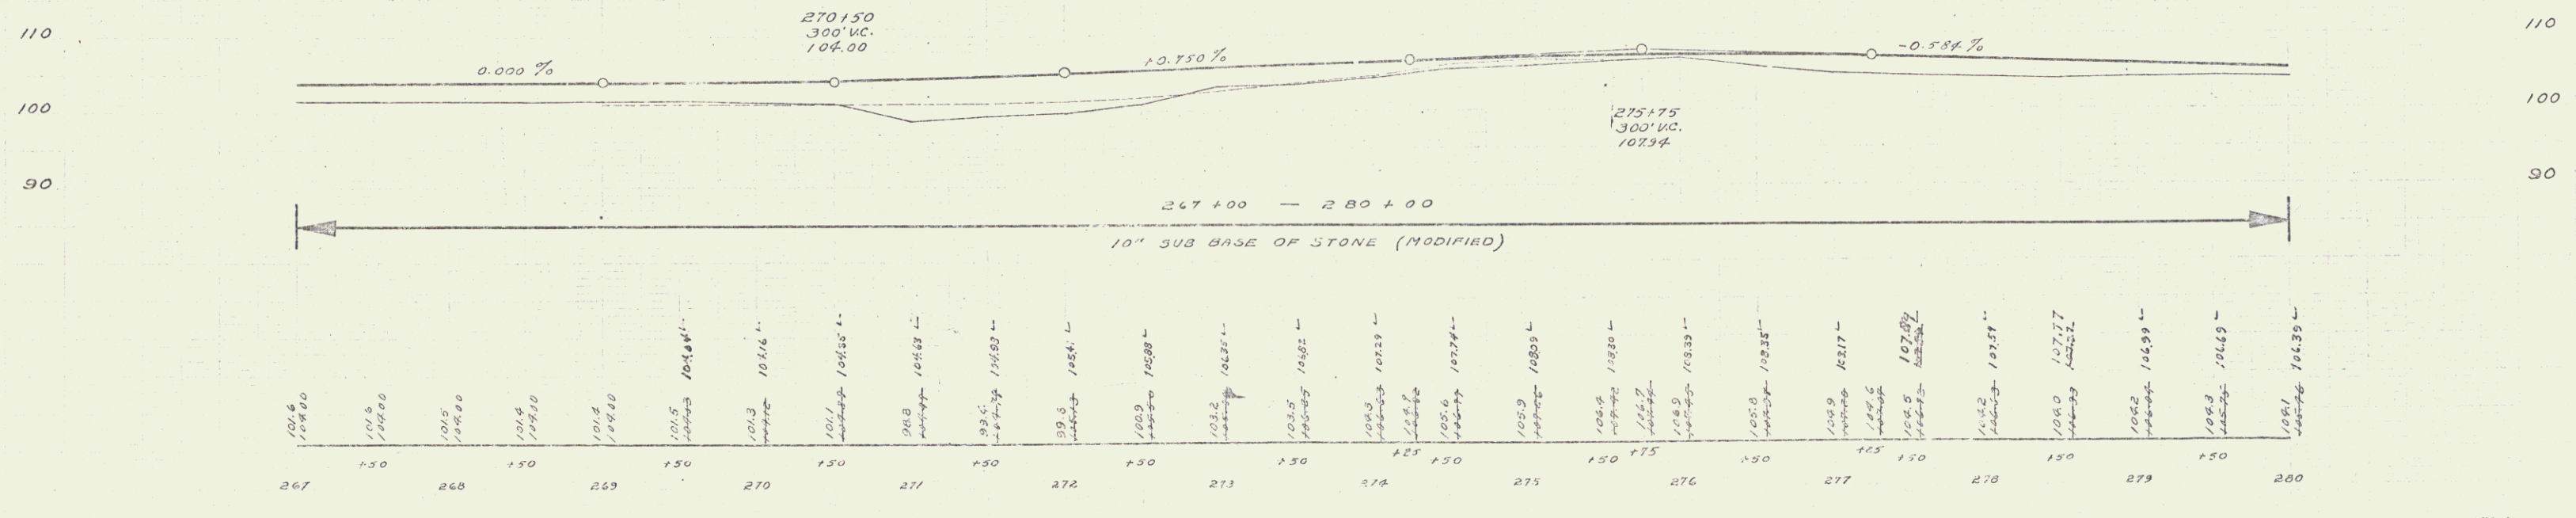

8 M. 4 35 S 1 E. 48° OAK 28" LT. 274+20 R 106.99

SERIES PAR. NO. 152-D
SHEET 21 OF 121