



PL. NO.	STATE	TED. AC.	TRICAL	SHEET	TOTAL SHEETS
1	V.	1220	1222	27	229

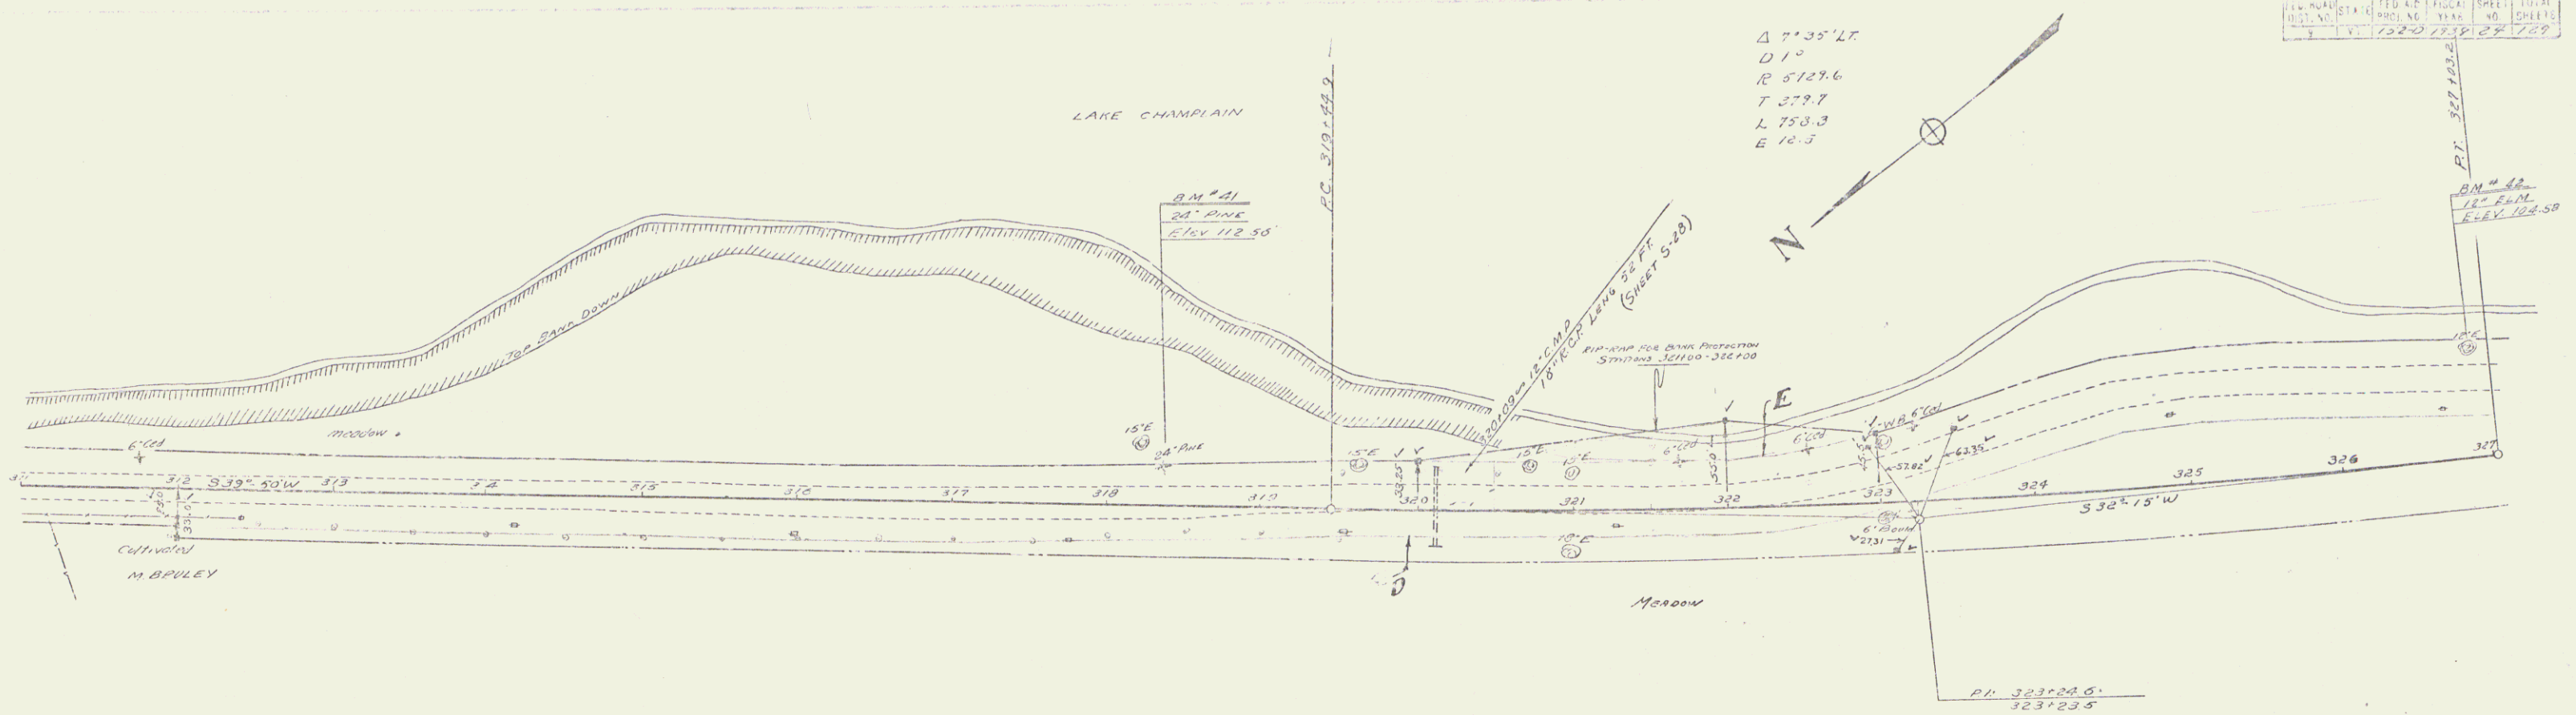

PARCEL	INSTRUMENT	DATE	GRANTOR	GRANTEE	RECORDED ALBUQS.	REMARKS
A00-DE	O.C.O.	10-14-37	FLORA, MARTIE & MARTIN BAILEY	STONY PT	BOOK PAGE DATE 30 384-213 10-20-37	
A00-DE	PAR. RELEASE	10-15-37	FED. LAND BANK	"	30 384-316 10-20-37	
A10-DE	PAR. RELEASE	10-13-37	FED. FARM MORTGAGE CORP.	"	30 308-9-10 10-20-37	

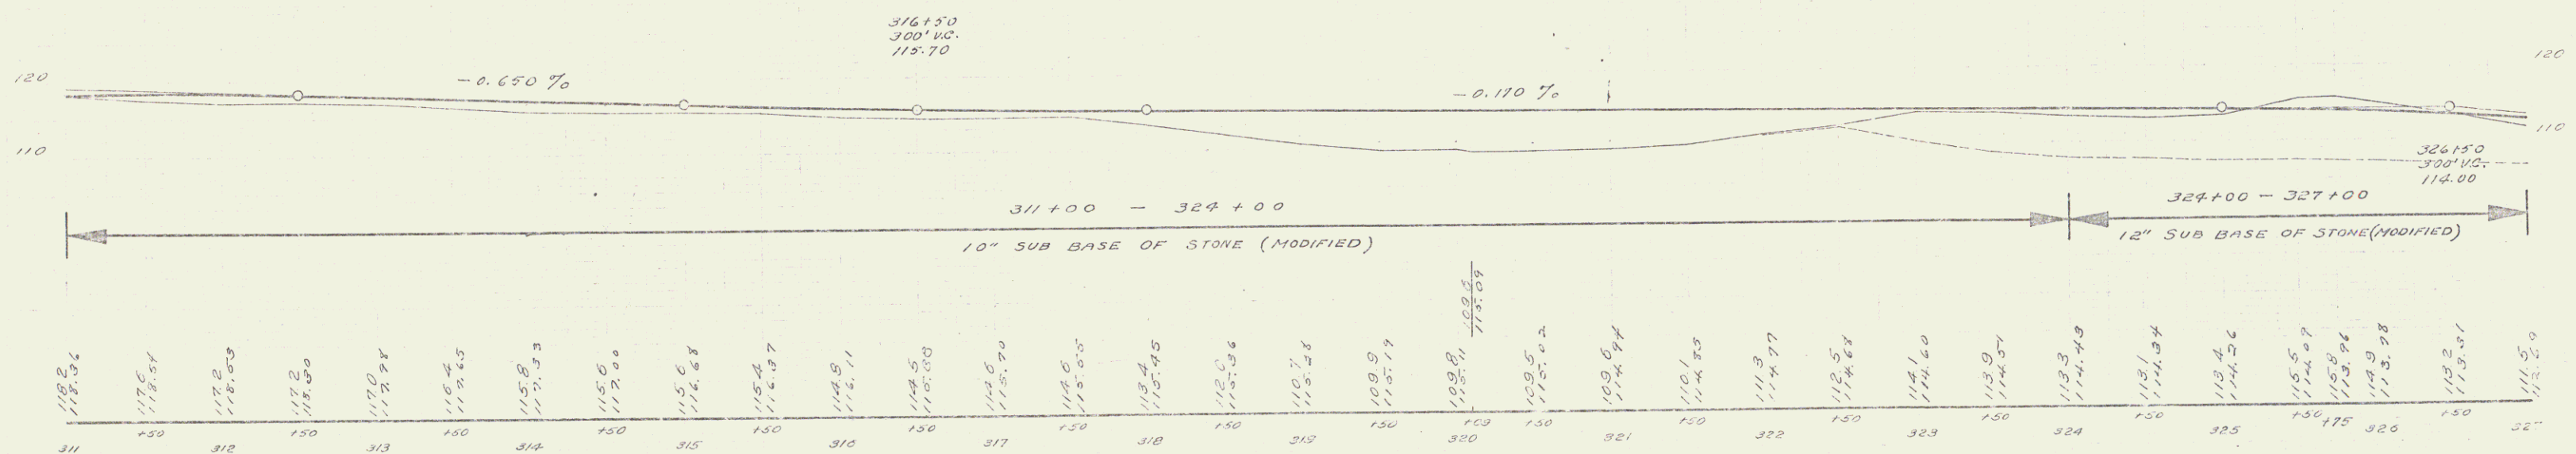

B.M. #41 31R. 24" PINE B'L. 318+37 ELEV. 112.58
 B.M. #22 31R. 12" EUM 68" LT. 326+39 ELEV. 104.53

SERIES MAP NO. 152-D
 SHEET 27 OF 229