


PARCEL 1
 INSTRUMENT W.D. A
 DATE 12-11-36 12-11-36
 GRANTOR JAMES CALLAGHAN EST. ARTHUR MARTELL
 SWANTON SAVINGS BANK & TRUST CO.
 GRANTEE ST. OF VT. ST. OF VT.
 RECORDED ALBURN ALBURN
 BOOK 30 30
 PAGE 69-70 72-73
 DATE 12-18-36 12-16-36
 REMARKS: CUL. STA. 163+00

ALL STATE ENGINEERING WORK SHALL BE DONE IN ACCORDANCE WITH THE RULES AND REGULATIONS OF THE BOARD OF ENGINEERS OF THE STATE OF VERMONT.
 187-C 7007 8 41

□ Boundary Markers

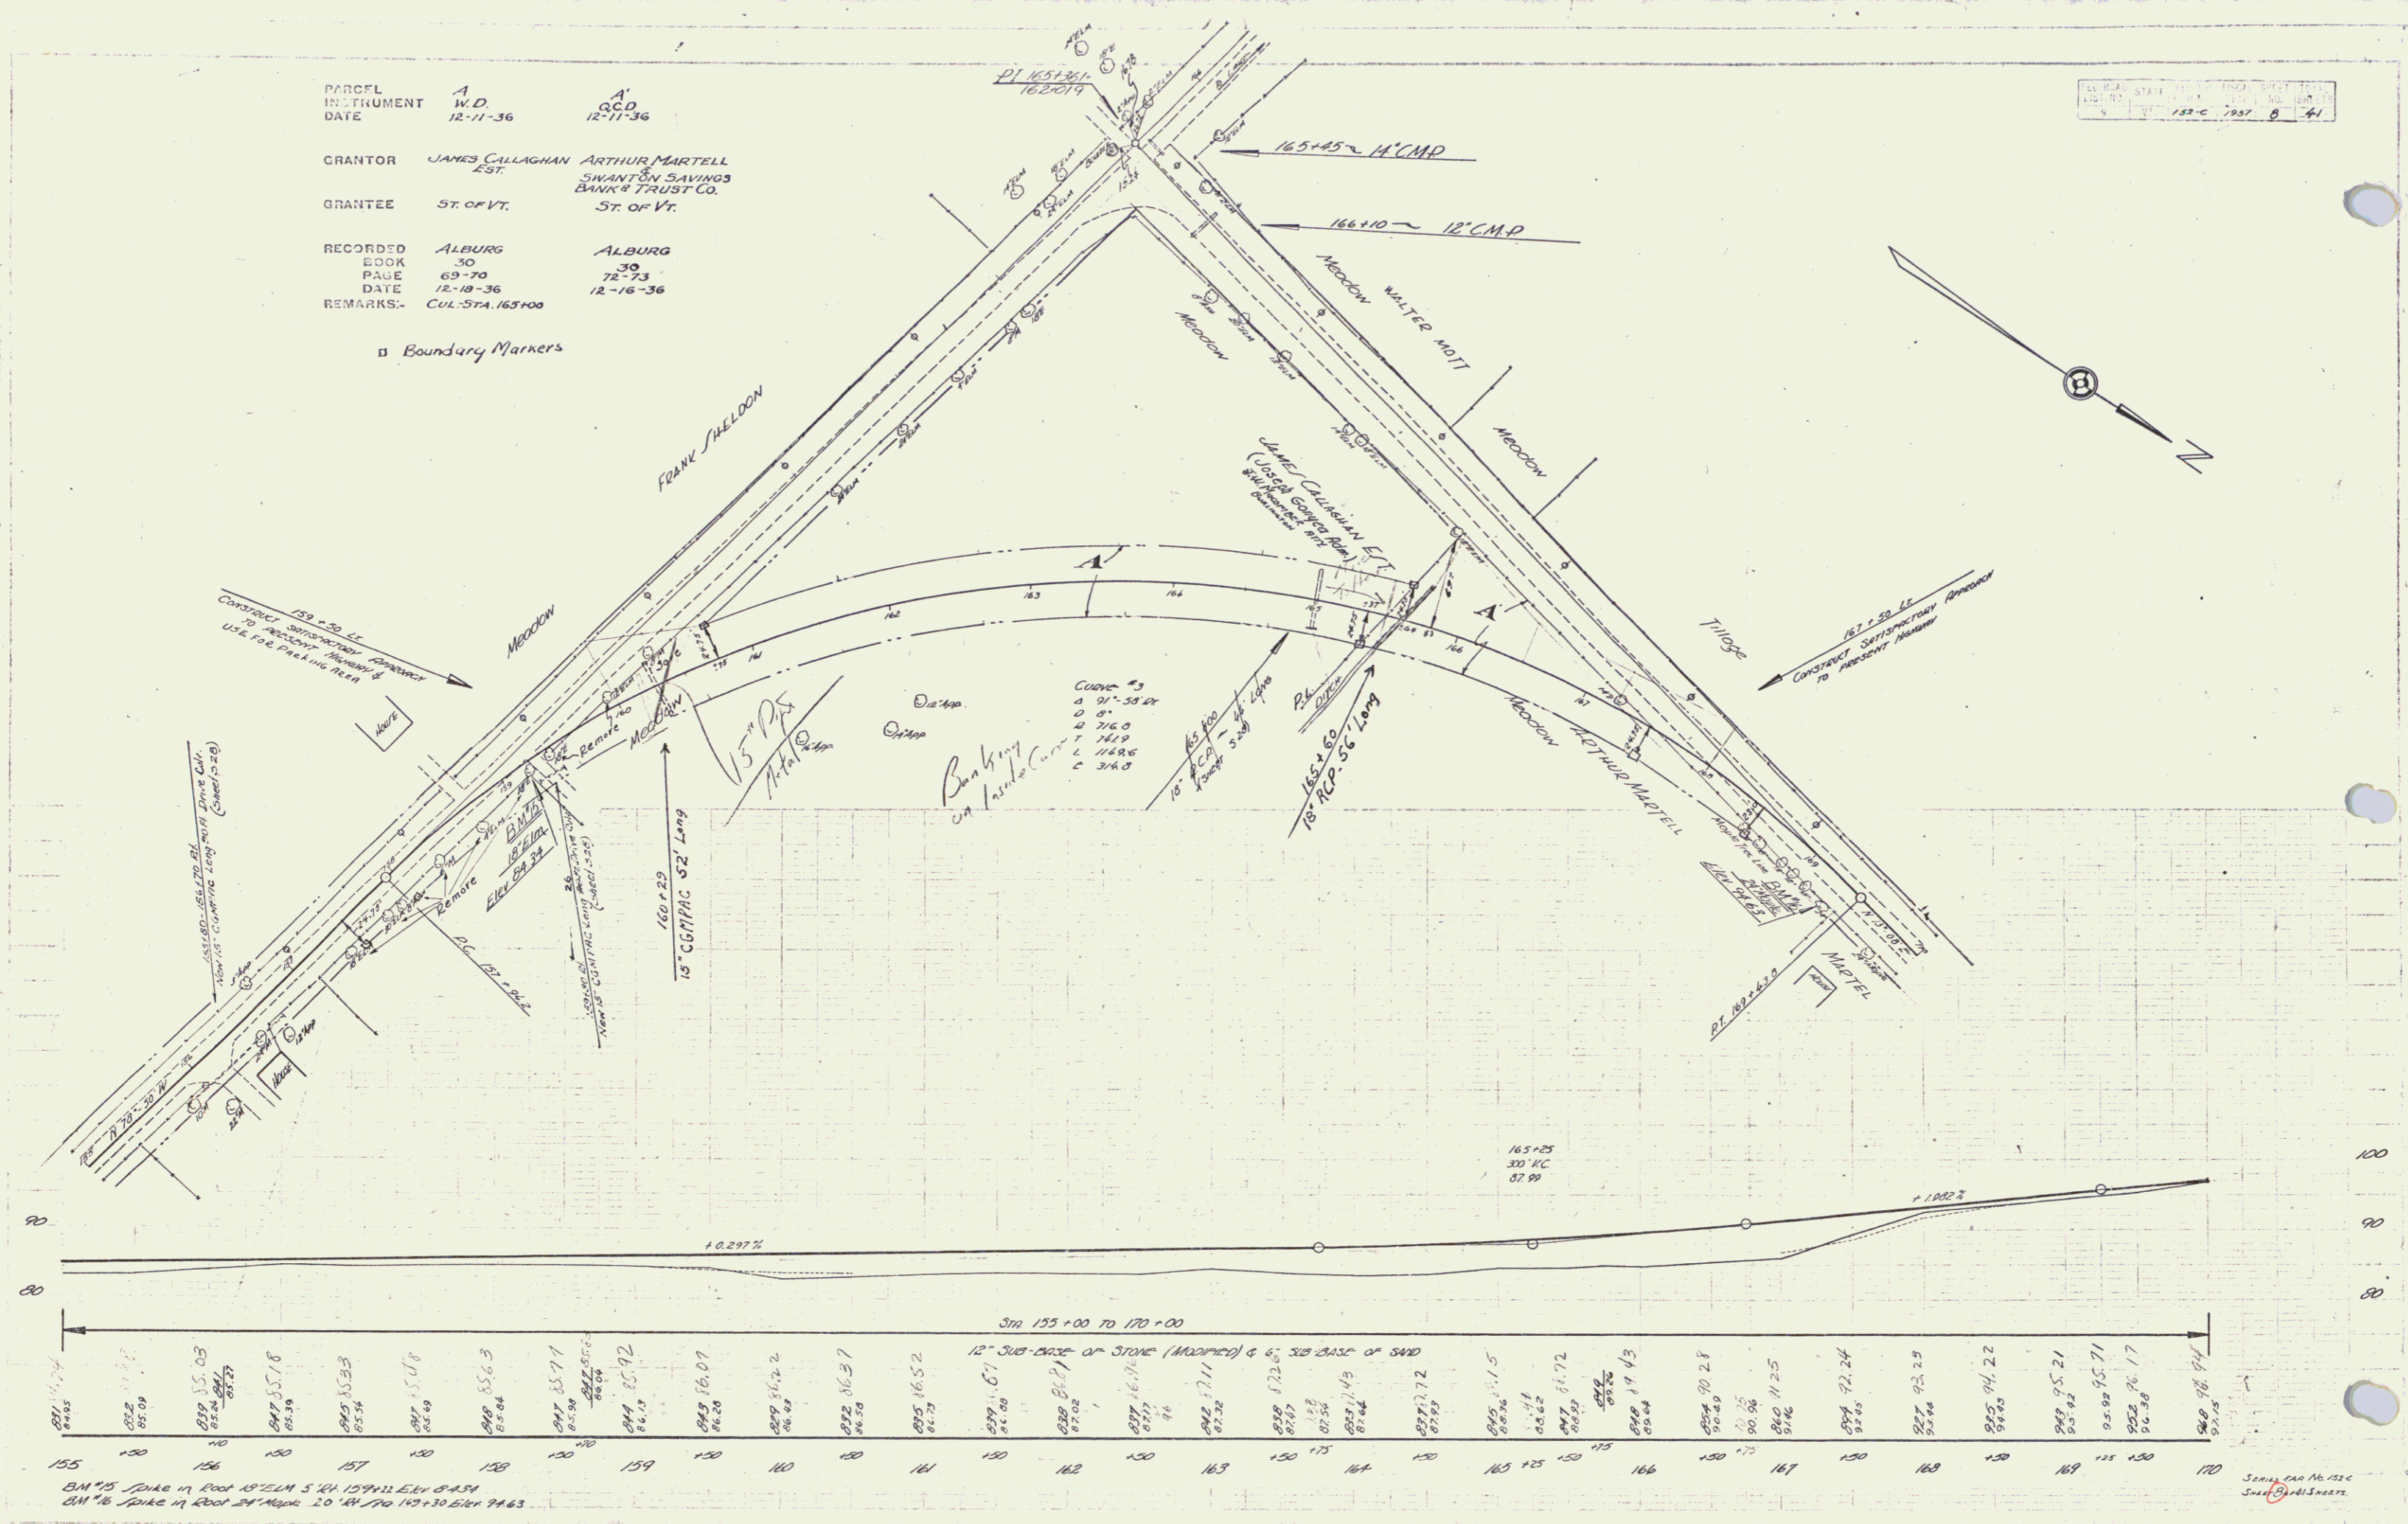

Scale 1" = 20' HORIZ. 1" = 10' VERT.
 SIGNED AND SEALED
 6