


CURVE  
 Δ 20° 32'  
 D 7'  
 R 89.0  
 T 822.3  
 L 1238.8  
 E 341.2

Sta 196 + 75 LT  
 Construct Drive Curb of Relay Pipe  
 Length 26' (Sheet 3-C)

Sta 196 + 25 RT  
 Construct Drive Curb of Relay Pipe - 26' long  
 (Sheet 3-C)

PARCEL INSTRUMENT DATE A W.D. 12-11-36  
 GRANTOR JOSEPH E. PATENAUDE  
 GRANTEE ST. OF VT.  
 RECORDED BOOK ALBURN 30  
 PAGE 70-71  
 DATE 12-18-36  
 REMARKS-

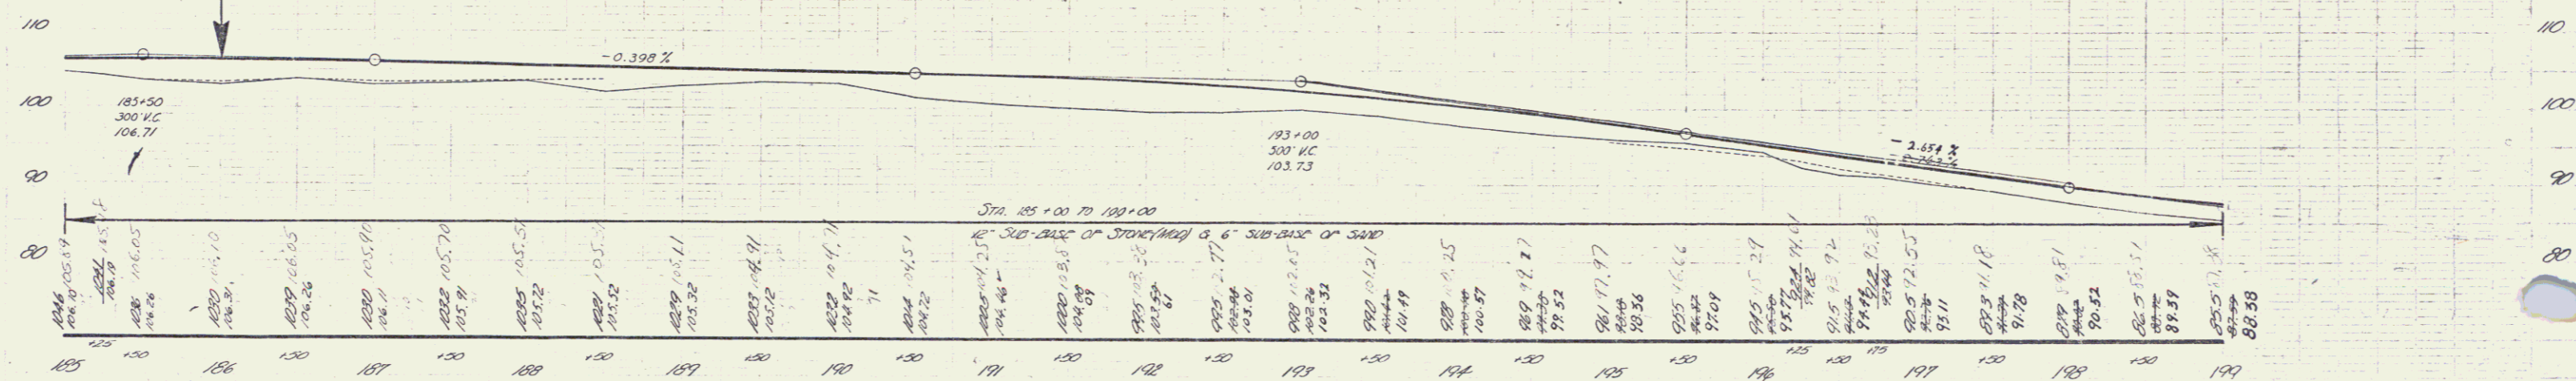

Sta. 185 + 00 TO 199 + 00  
 16" SUB-BASE OR STRONGHO 6" SUB-BASE OR 3400

185	186	187	188	189	190	191	192	193	194	195	196	197	198	199
105.89	106.05	106.10	106.26	106.35	106.41	106.42	106.45	106.48	106.51	106.53	106.55	106.57	106.59	106.61
106.71	106.71	106.71	106.71	106.71	106.71	106.71	106.71	106.71	106.71	106.71	106.71	106.71	106.71	106.71

64" #16 Spike in Road at Sta. 196.115 Elev. 104.15

Scale 1" = 40' HORIZ.  
 1" = 4' VERT.