


B.M. 79  
110 N.E.M.  
Elev. 81.49

Curve  
A 31.00 Rt  
D 114.5  
R 15.335  
T 133.5  
L 44.67  
A 7.3

PARCEL	meadow	
INSTRUMENT	A, B	A, B
DATE	12-11-36	12-11-36
GRANTOR	JOSEPH E. PATENAUDE	BLANCHE HUNTER
GRANTEE	St. of Vt.	St. of Vt.
RECORDED	ALBURY	ALBURY
BOOK	30	30
PAGE	70-71	254-255
DATE	12-18-36	12-16-36
REMARKS		

200+00 200+25  
400'-K.C. 550' V.C.  
84-93 84-99

200+100  
200' V.C.  
83-16

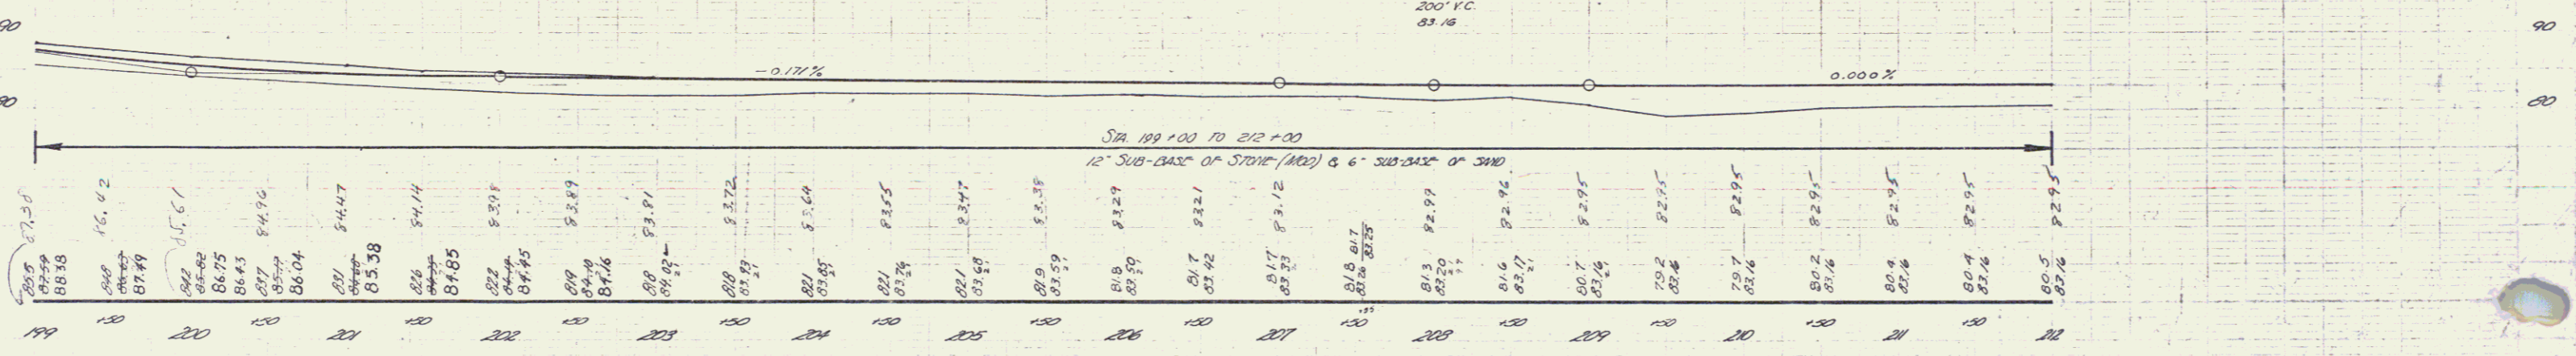

B.M. 79 (pole in Root 10' E.M. N.E.M. 710 203159 Elev. 81.49)

10