


PARCEL	A, B	A', B'
INSTRUMENT	W.D.	W.D.
DATE	12-11-36	12-11-36
GRANTOR	JOSEPH E. PATENAUDE	BLANCHE HUNTER
GRANTEE	ST. OF VT.	ST. OF VT.
RECORDED	ALBURY	ALBURY
BOOK	30	30
PAGE	70-71	254-255
DATE	12-18-36	12-16-36
REMARKS:-		

POOR ORIGINAL COPY

STA. 218 + 30.3
 END OF PROJECT 152-L
 Non Government

211.50
 OF PWA DOCKET NO.
 VT 1011-R
 NY 1476-R

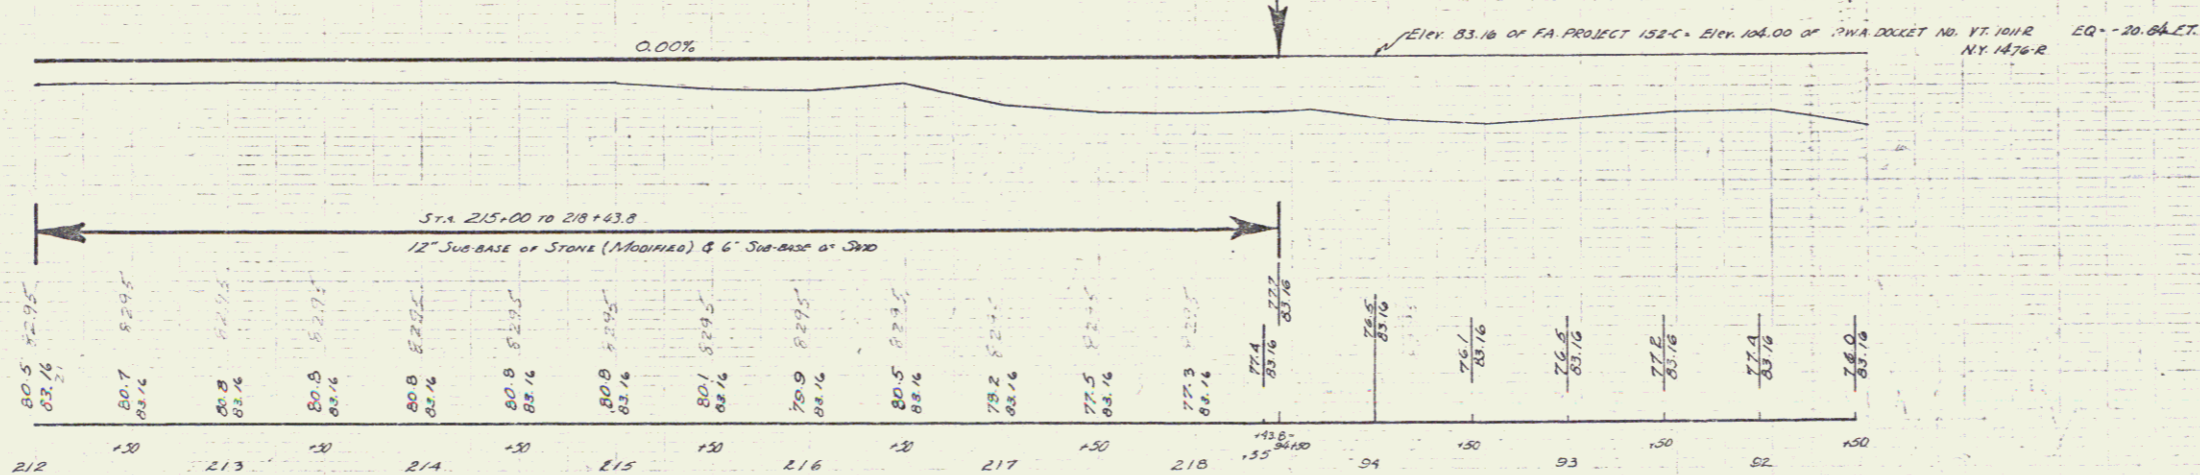

B.M. 20 SPIKE IN ROOT OF N 81° 18' RT STA 211+65 ELEV. 78.00 - ELEV. 29.83 of BRIDGE SURVEY EQ. - 2084

New Government
 No. 152-L
 10-17-36