


PLAN
 SCALE
 DATE

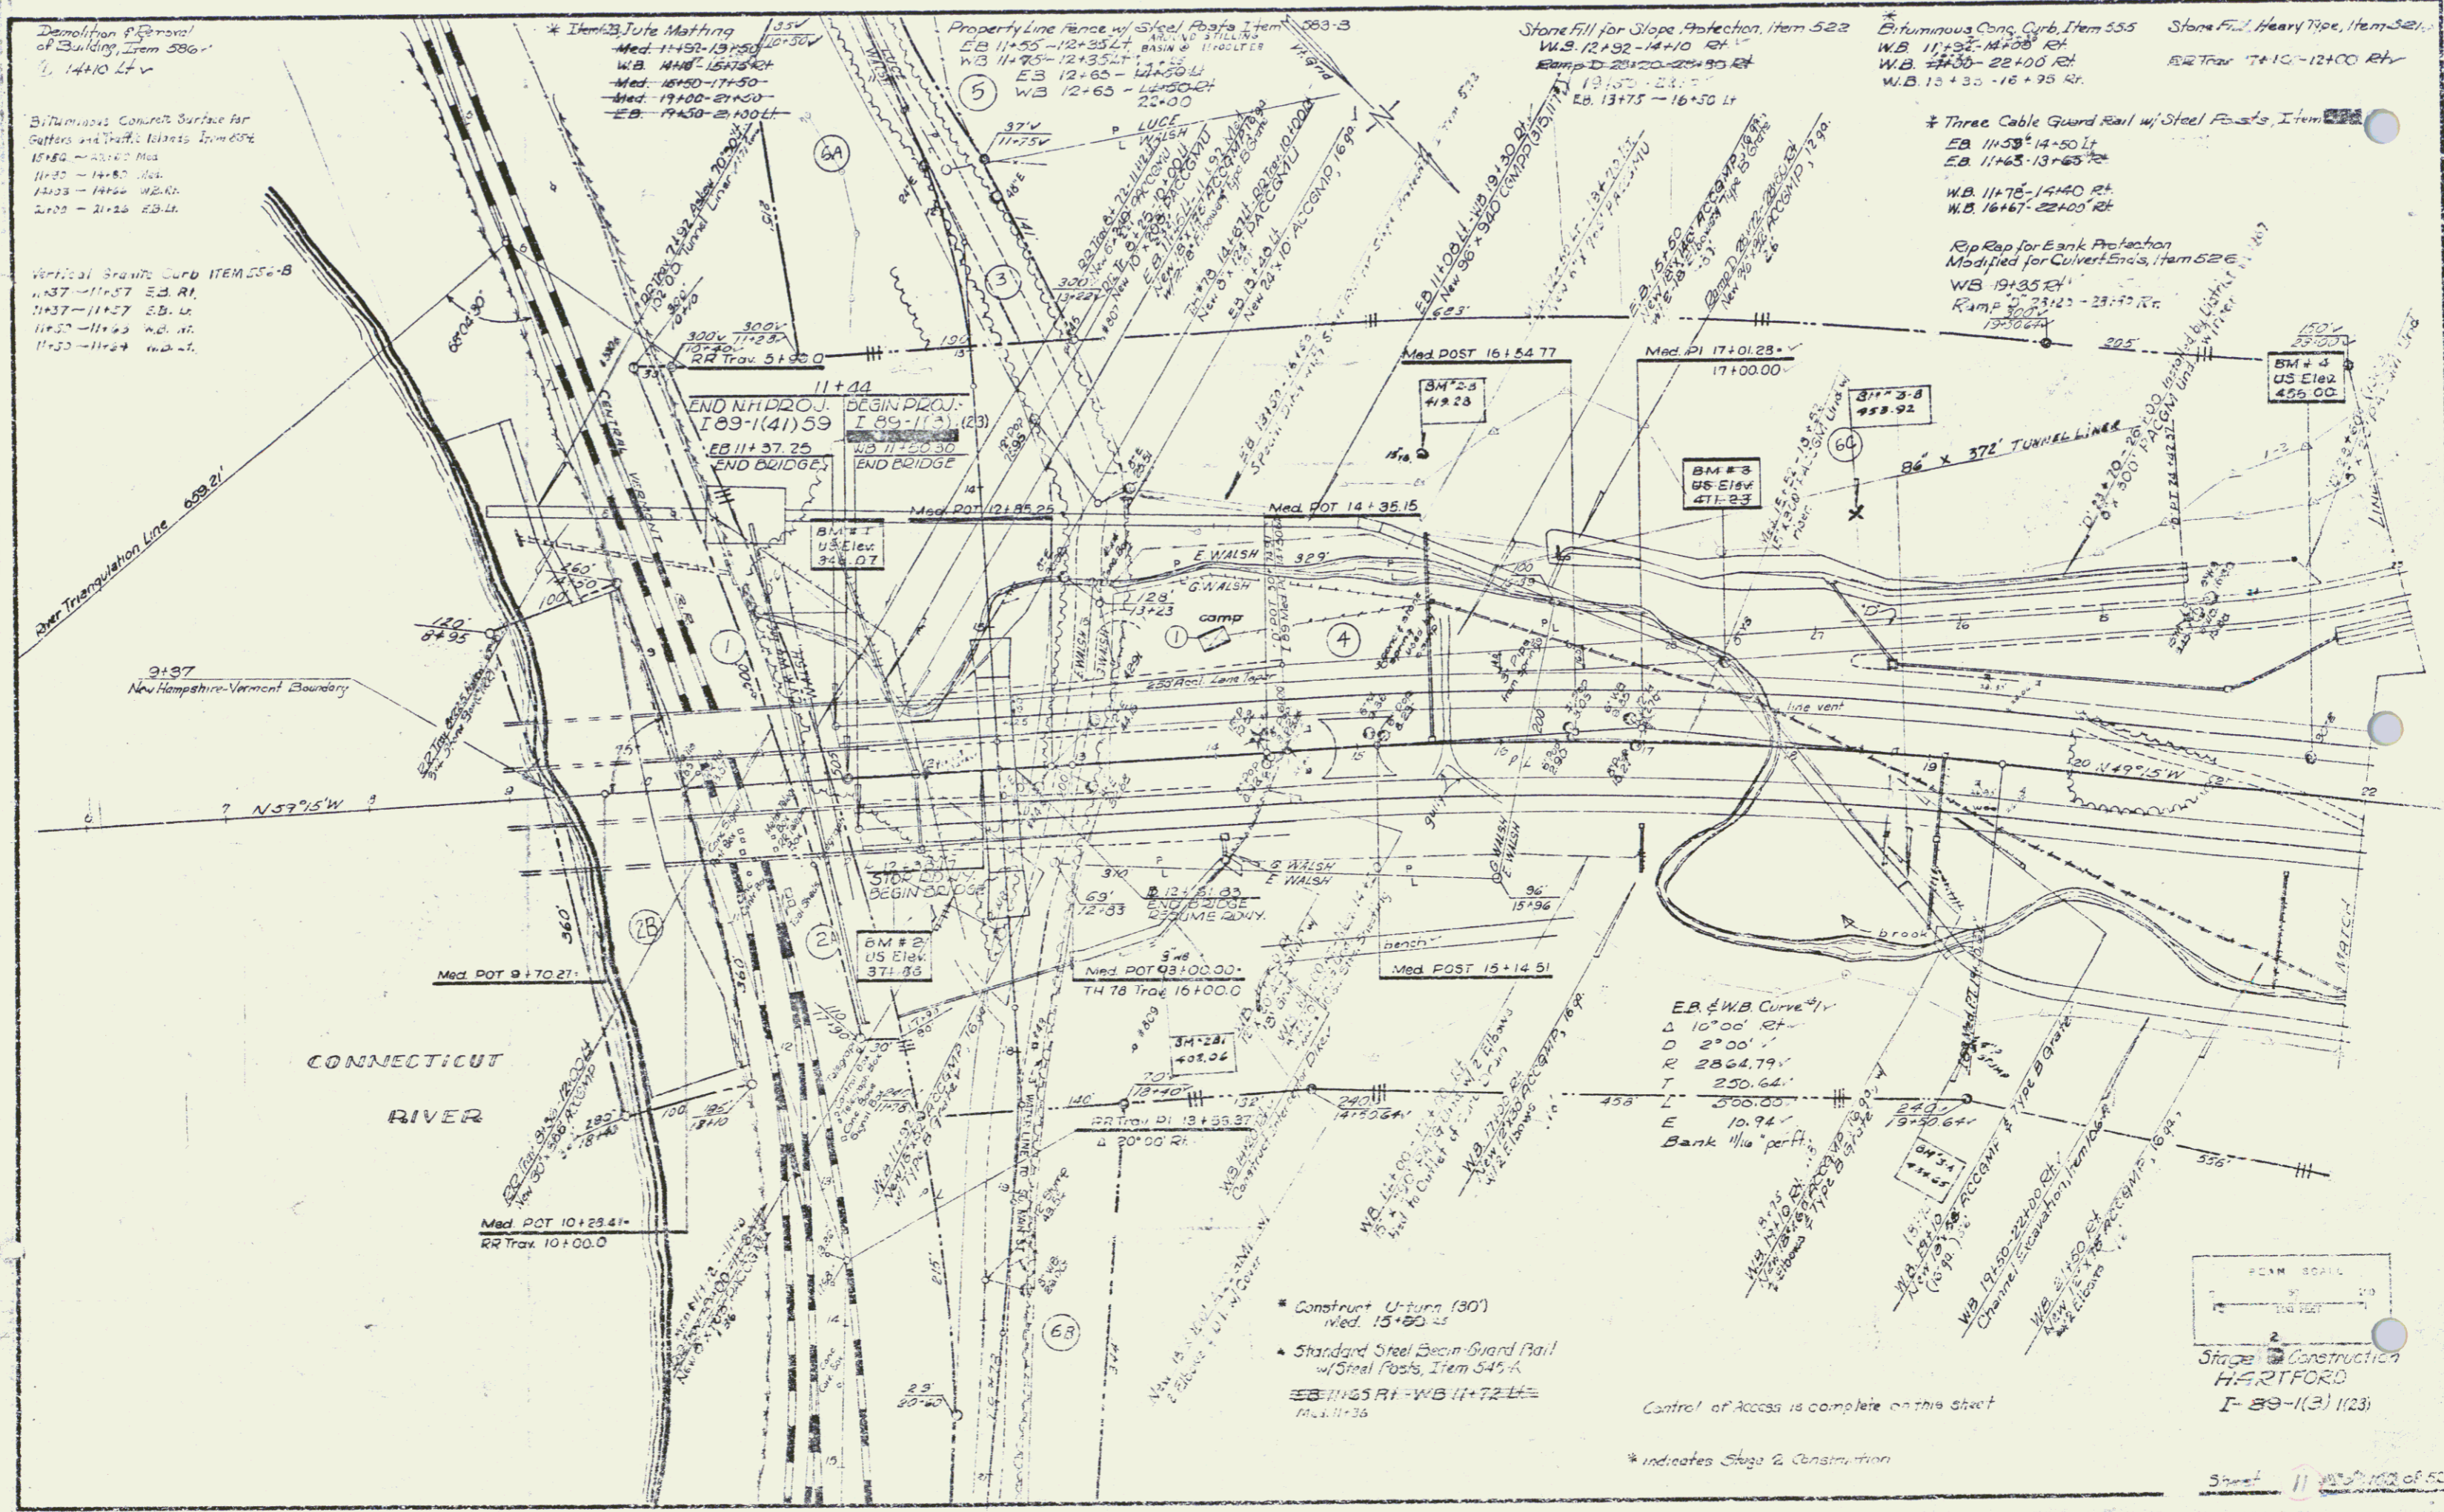

Demolition & Removal of Building, Item 586
 1440+00

Bituminous Concrete Surface for Gutters and Traffic Islands, Item 604
 1580 - 21+00 Med.
 11+35 - 14+50 Med.
 14+33 - 14+50 Med.
 21+25 - 21+25 EB-L

Vertical Granite Curb ITEM 555-B
 11+37 - 11+57 EB-R
 11+37 - 11+57 EB-L
 11+57 - 11+63 Med. R
 11+57 - 11+63 Med. L

* Item 23 Lute Matting
 Med. 11+49 - 13+50
 W.B. 11+49 - 13+50
 Med. 16+50 - 17+50
 Med. 17+00 - 21+50
 EB 17+50 - 21+00 LT

Property Line Fence w/ Steel Posts, Item 583-B
 EB 11+55 - 12+35 LT
 WB 11+55 - 12+35 LT
 EB 12+65 - 14+50 LT
 WB 12+65 - 14+50 LT

Stone Fill for Slope Protection, Item 522
 W.B. 12+92 - 14+10 RT
 Ramp D 23+20 - 23+90 RT
 13+75 - 21+75
 EB 13+75 - 16+50 LT

* Bituminous Conc. Curb, Item 555
 W.B. 11+32 - 14+00 RT
 W.B. 11+32 - 14+00 RT
 W.B. 15+35 - 16+95 RT

Stone Fill Heavy Type, Item 521
 EB Trax 11+10 - 12+00 RT

* Three Cable Guard Rail w/ Steel Posts, Item 523
 EB 11+33 - 14+50 LT
 EB 11+63 - 13+65 RT
 W.B. 11+75 - 14+40 RT
 W.B. 16+67 - 22+00 RT

Rep. Rap for Bank Protection Modified for Culvert Ends, Item 526
 WB 19+35 RT
 Ramp 23+20 - 23+90 RT
 13+75

11+44
 END NH D.D.O. I 89-1(4) 59
 BEGIN PROJ. I 89-1(3) 23
 EB 11+37 25
 END BRIDGES
 WB 11+20 50
 END BRIDGE

BM #1
 US Elev.
 348.07

BM #2
 US Elev.
 418.23

Med. POST 16+54.77

Med. PI 17+01.23

BM #3
 US Elev.
 411.23

BM #4
 US Elev.
 455.00

9+97
 New Hampshire-Vermont Boundary

CONNECTICUT RIVER

Med. POT 9+70.27

Med. POT 10+29.41
 RR Trax 10+00.0

Med. POT 93+00.00
 TH 78 Trax 16+00.0


Med. POST 15+14.51

EB & WB Curve 41
 Δ 10°00' RT
 D 2°00'
 R 2864.79'
 T 250.64'
 L 208.00'
 E 10.74'
 Bank 1/16' per ft

* Construct U-turn (30')
 Med. 13+00+00
 * Standard Steel Beam Guard Rail w/ Steel Posts, Item 545-A
 EB 11+25 RT - WB 11+72 LT
 11.3.11.36

Control of Access is complete on this street

* indicates Stage & Construction

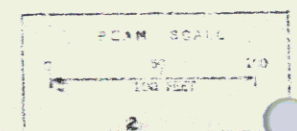

Stage Construction
 I-89-1(3) 1(23)

Sheet 11 of 100 of 55