

PLAN	NO.	DATE
189-11(3)	10	11/23
189-11(2)	9	11/23
189-11(1)	8	11/23
189-11(0)	7	11/23
189-11(0)	6	11/23
189-11(0)	5	11/23
189-11(0)	4	11/23
189-11(0)	3	11/23
189-11(0)	2	11/23
189-11(0)	1	11/23
189-11(0)	0	11/23

* Bituminous Concrete Curb-Item 555
 55+50-62+00 W.B. RT
 56+50-61+00 EB LT
 59+99-55+00 WB


STONE FILL FOR SLOPE PROTECTION ITEM 522
 WB 53+93-56+50 RT
 EB 56+30-57+30 LT

* Jute Matt.ing Item 623
 Med. 57+50-59+50
 Med. 54+50-56+50
 Med. 61+00-62+00

* Three Cable Guard Rail w/ Steel Posts
 WB 53+99-62+00 RT
 EB 56+40-62+00 LT


Drilling & Blasting of Solid
 Rock Subgrade Item 114
 EB 54+00-55+00

Property Line Fence w/ Steel Posts Item 10
 EB 54+00-65+00
 WB 54+00-86+00
 Above-stationed fence to be erected prior to the commencement of construction

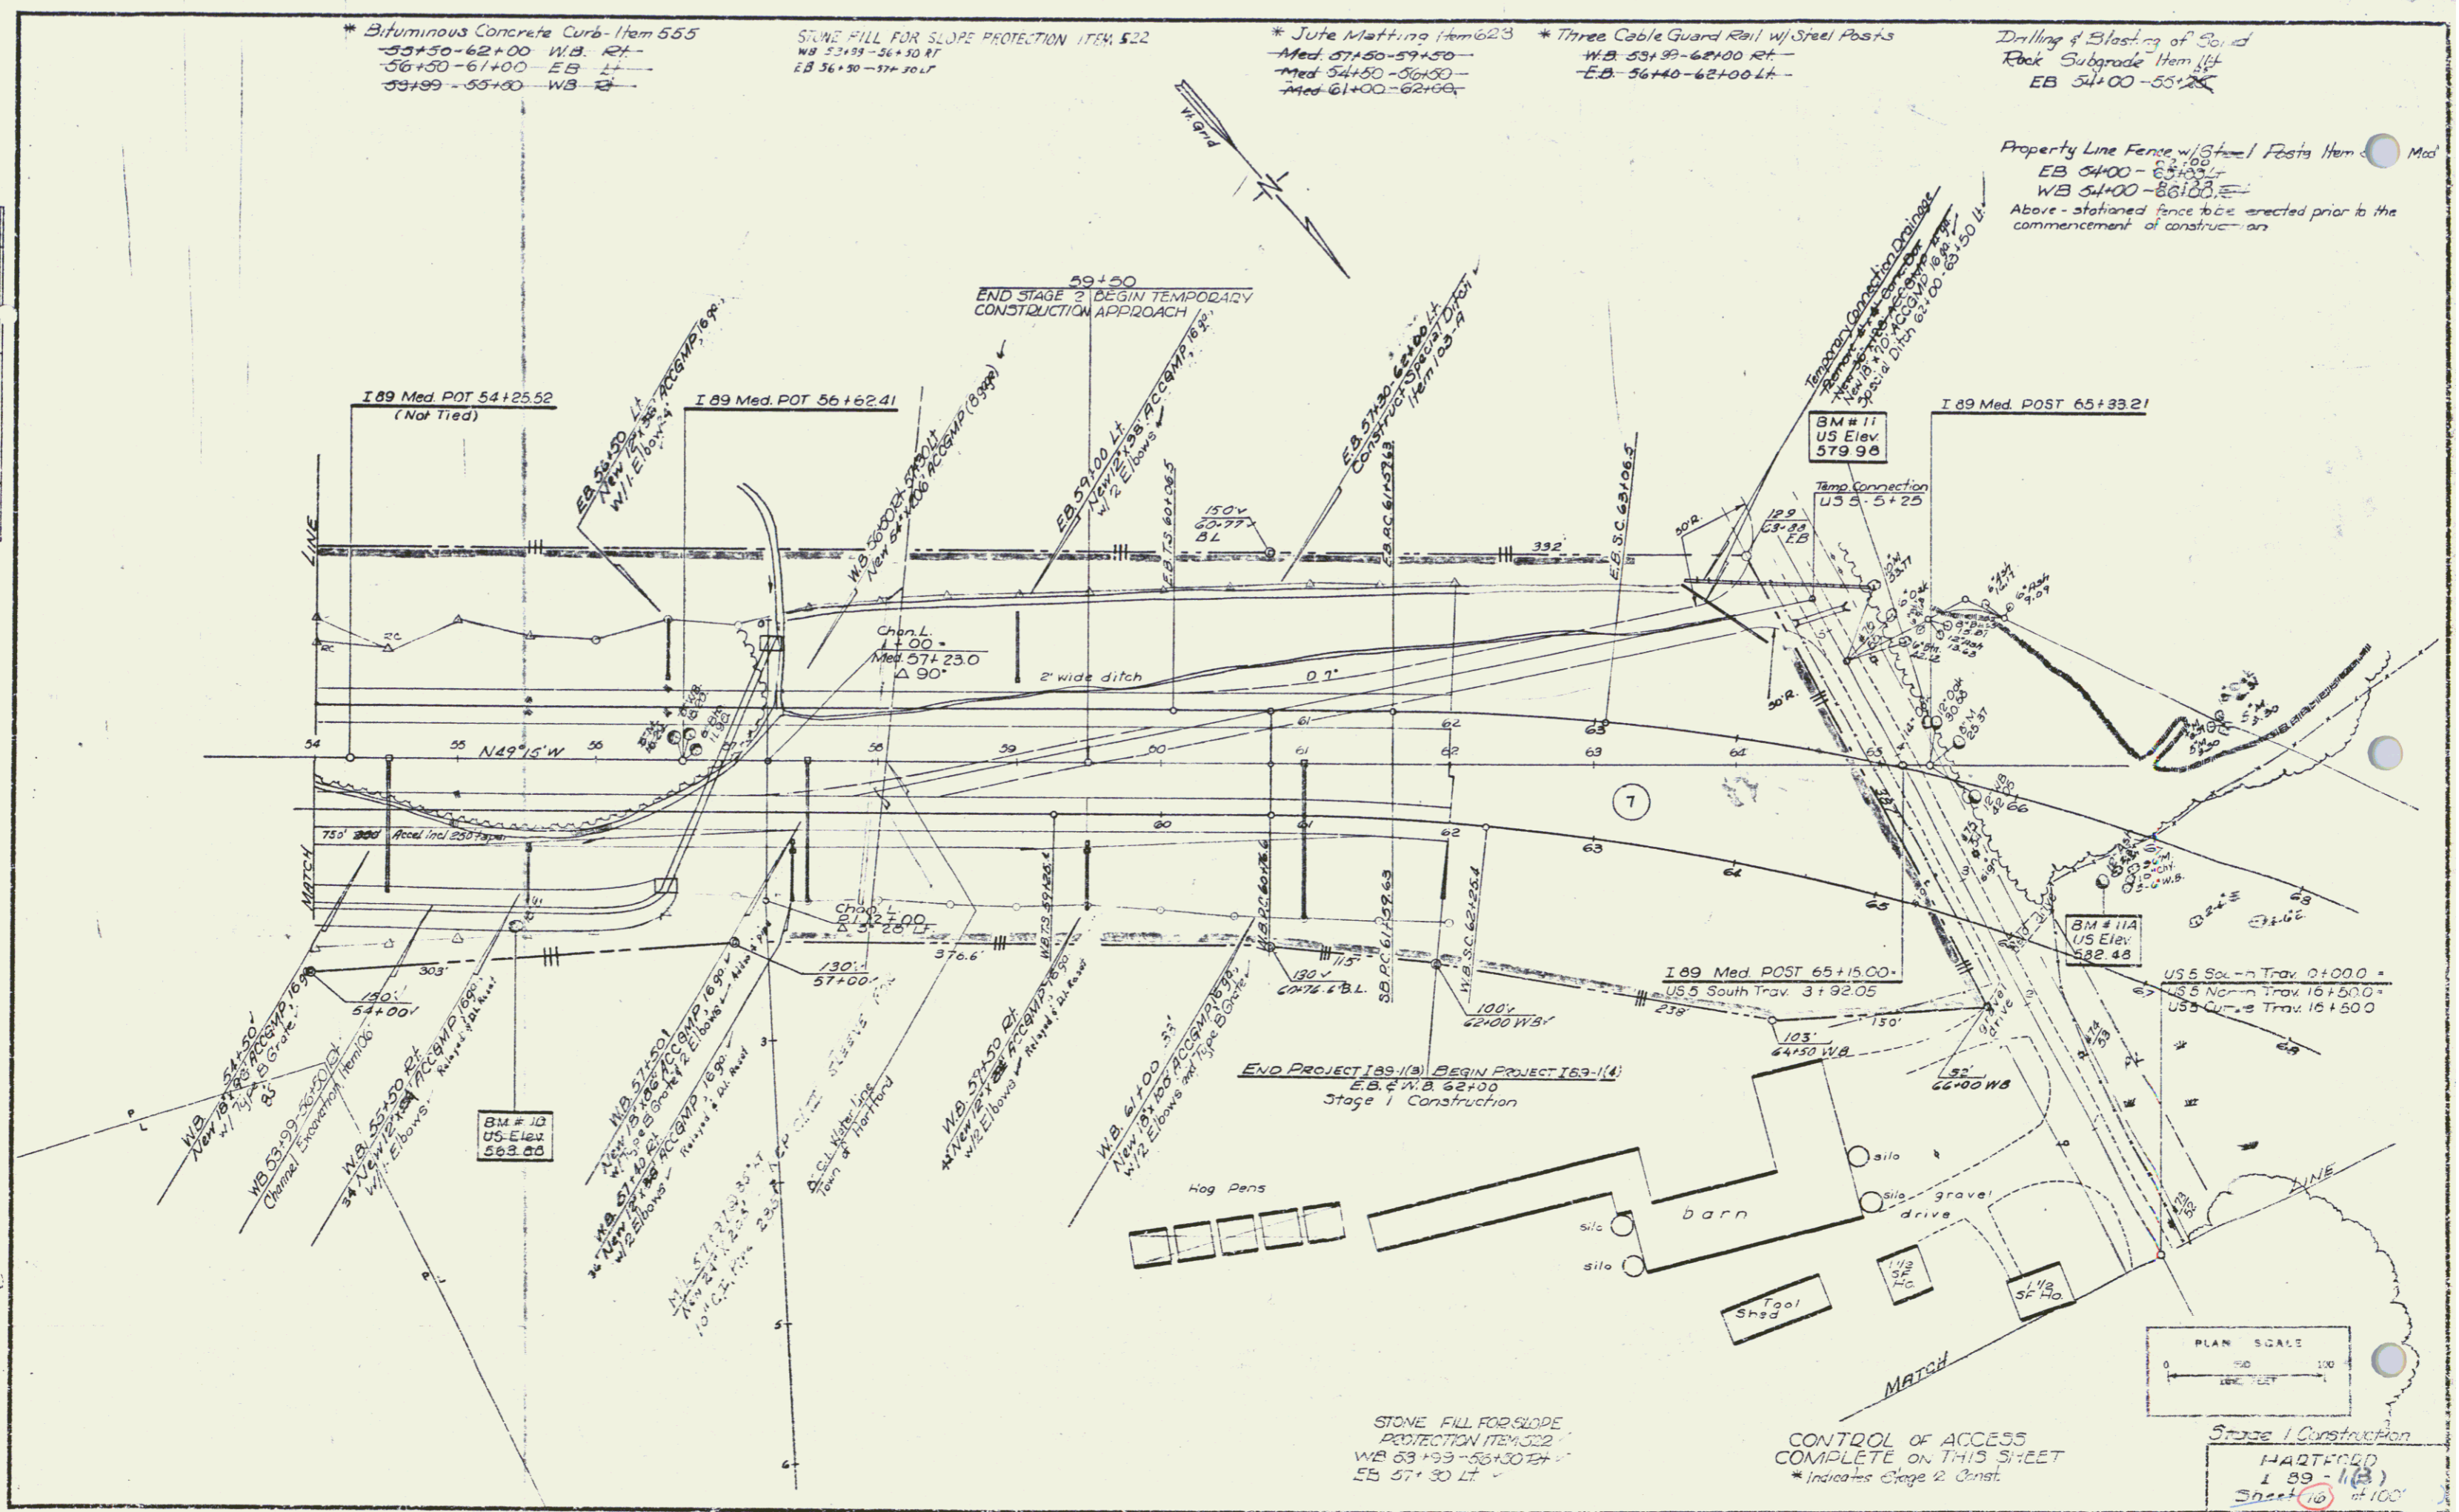

STONE FILL FOR SLOPE PROTECTION ITEM 522
 WB 53+93-56+50 RT
 EB 57+30 LT

CONTROL OF ACCESS COMPLETE ON THIS SHEET
 * Indicates Stage 2 Const.

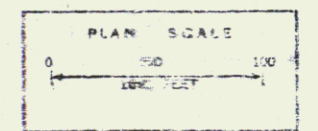

Stage 1 Construction
 HARTFORD
 189-11(3)
 Sheet 10 of 100