

Two Cable Guard Rail Item 542  
 10+49 - 15+05 P.T.  
 11+85 - 15+05 L.T.  
 17+04 - 20+56 P.T.  
 17+04 - 18+64 L.T.

END RELINQUISHMENT NO. I  
 BEGIN MAINT. AGREE. AREA NO. I  
 T.H. 78 13+00 C (541')


END MAINT. AGREE. AREA NO. I  
 BEGIN RELINQUISHMENT NO. II  
 T.H. 78 18+41 C (409')

END RELINQUISHMENT NO. II  
 T.H. 78 22+50 C

BEGIN RELINQUISHMENT NO. I  
 T.H. 78 10+00 C (300')

TH 78 POT 10+00  
 Begin Construction

TH 78 POT 22+50  
 End Construction

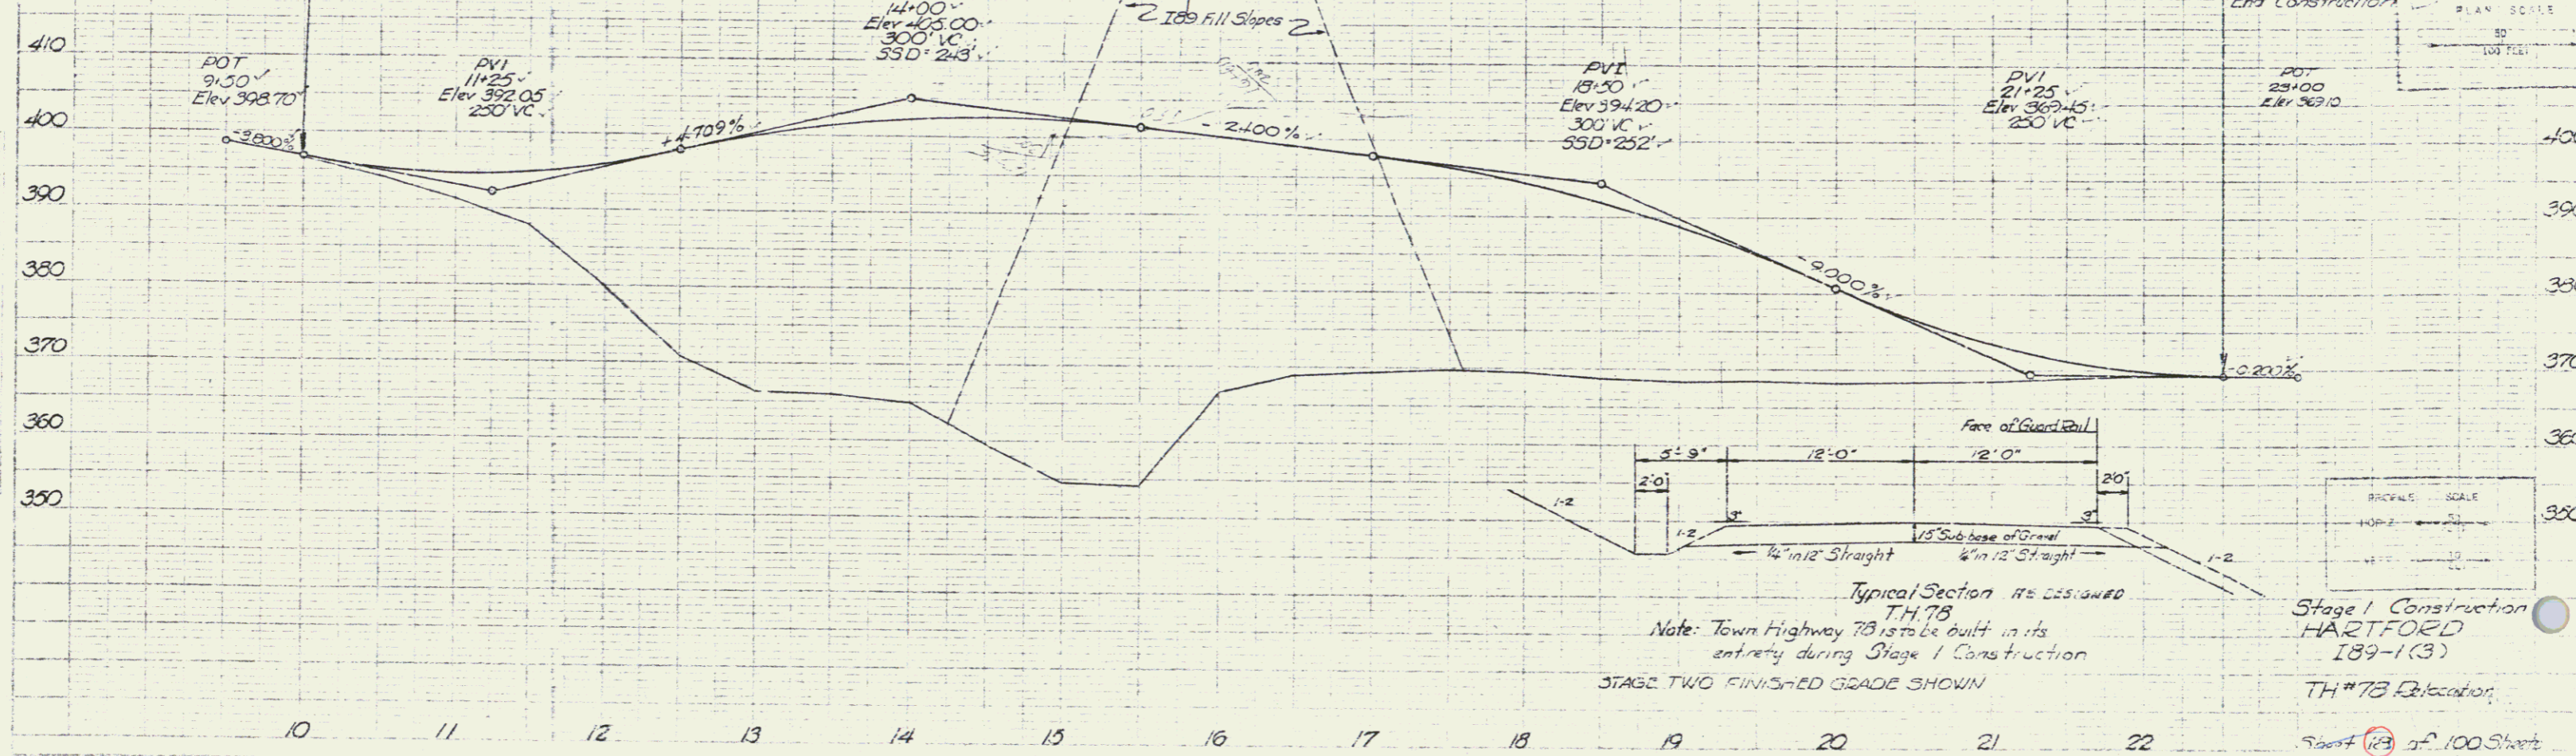

Typical Section as Designed  
 T.H. 78  
 Note: Town Highway 78 is to be built in its  
 entirety during Stage I Construction  
 STAGE TWO FINISHED GRADE SHOWN  
 Stage I Construction  
 HARTFORD  
 189-1(3)  
 TH #78 Elevation  
 Sheet 189 of 100 Sheets

PLAN SCALE  
 1" = 40'

PLAN SCALE  
 1" = 40'

ARCWAVE SCALE  
 1" = 10'