

Drilling and Pre-splitting of Solid Rock  
Item 125  
WB 136+00 LT - 139+75 LT  
EB 133+25 RT - 139+00 RT

Rip-Rap (light type)  
Item 513B-1  
E.B. 151+40 LT


Property Line Fence w/ Steel Posts, Mod. - Item 583-II  
EB 137+00 - 141+50 LT  
WB 137+00 - 142+00 RT  
EB 142+50 - 151+00 LT  
WB 142+50 - 151+00 RT  
Property Line Fence Listed Below to be Installed Prior to Other Work in the Area  
WB 137+00 - 140+00 RT  
EB 137+00 - 140+00 LT

Jute Matting - Item 623  
EB 140+00 - 143+75 LT  
Med 140+42 - 142+50  
Med 142+00 - 142+50  
Med 144+30 - 152+50  
EB 151+38 - 152+00 LT  
EB 142+88 - 142+43 LT  
EB 151+88 - 151+43 LT  
Med 137+00 - 137+75

Bituminous Conc. Curb  
Item 5-5-5  
WB 150+50 - 152+00 RT  
EB 151+00 - 152+00 LT  
WB 141+50 - 143+50 RT  
EB 142+00 - 143+00 LT

Three Cable Guard Rail With Steel Posts  
Item 5-5-5  
WB 141+50 - 142+50 RT  
EB 142+50 - 143+00 LT  
WB 150+50 - 152+00 RT  
EB 151+00 - 152+00 LT

PLAN	DATE	BY
Drilling and Pre-splitting of Solid Rock	12/20/73	J.P.
Property Line Fence		
Rip-Rap		
Jute Matting		
Bituminous Conc. Curb		
Three Cable Guard Rail		

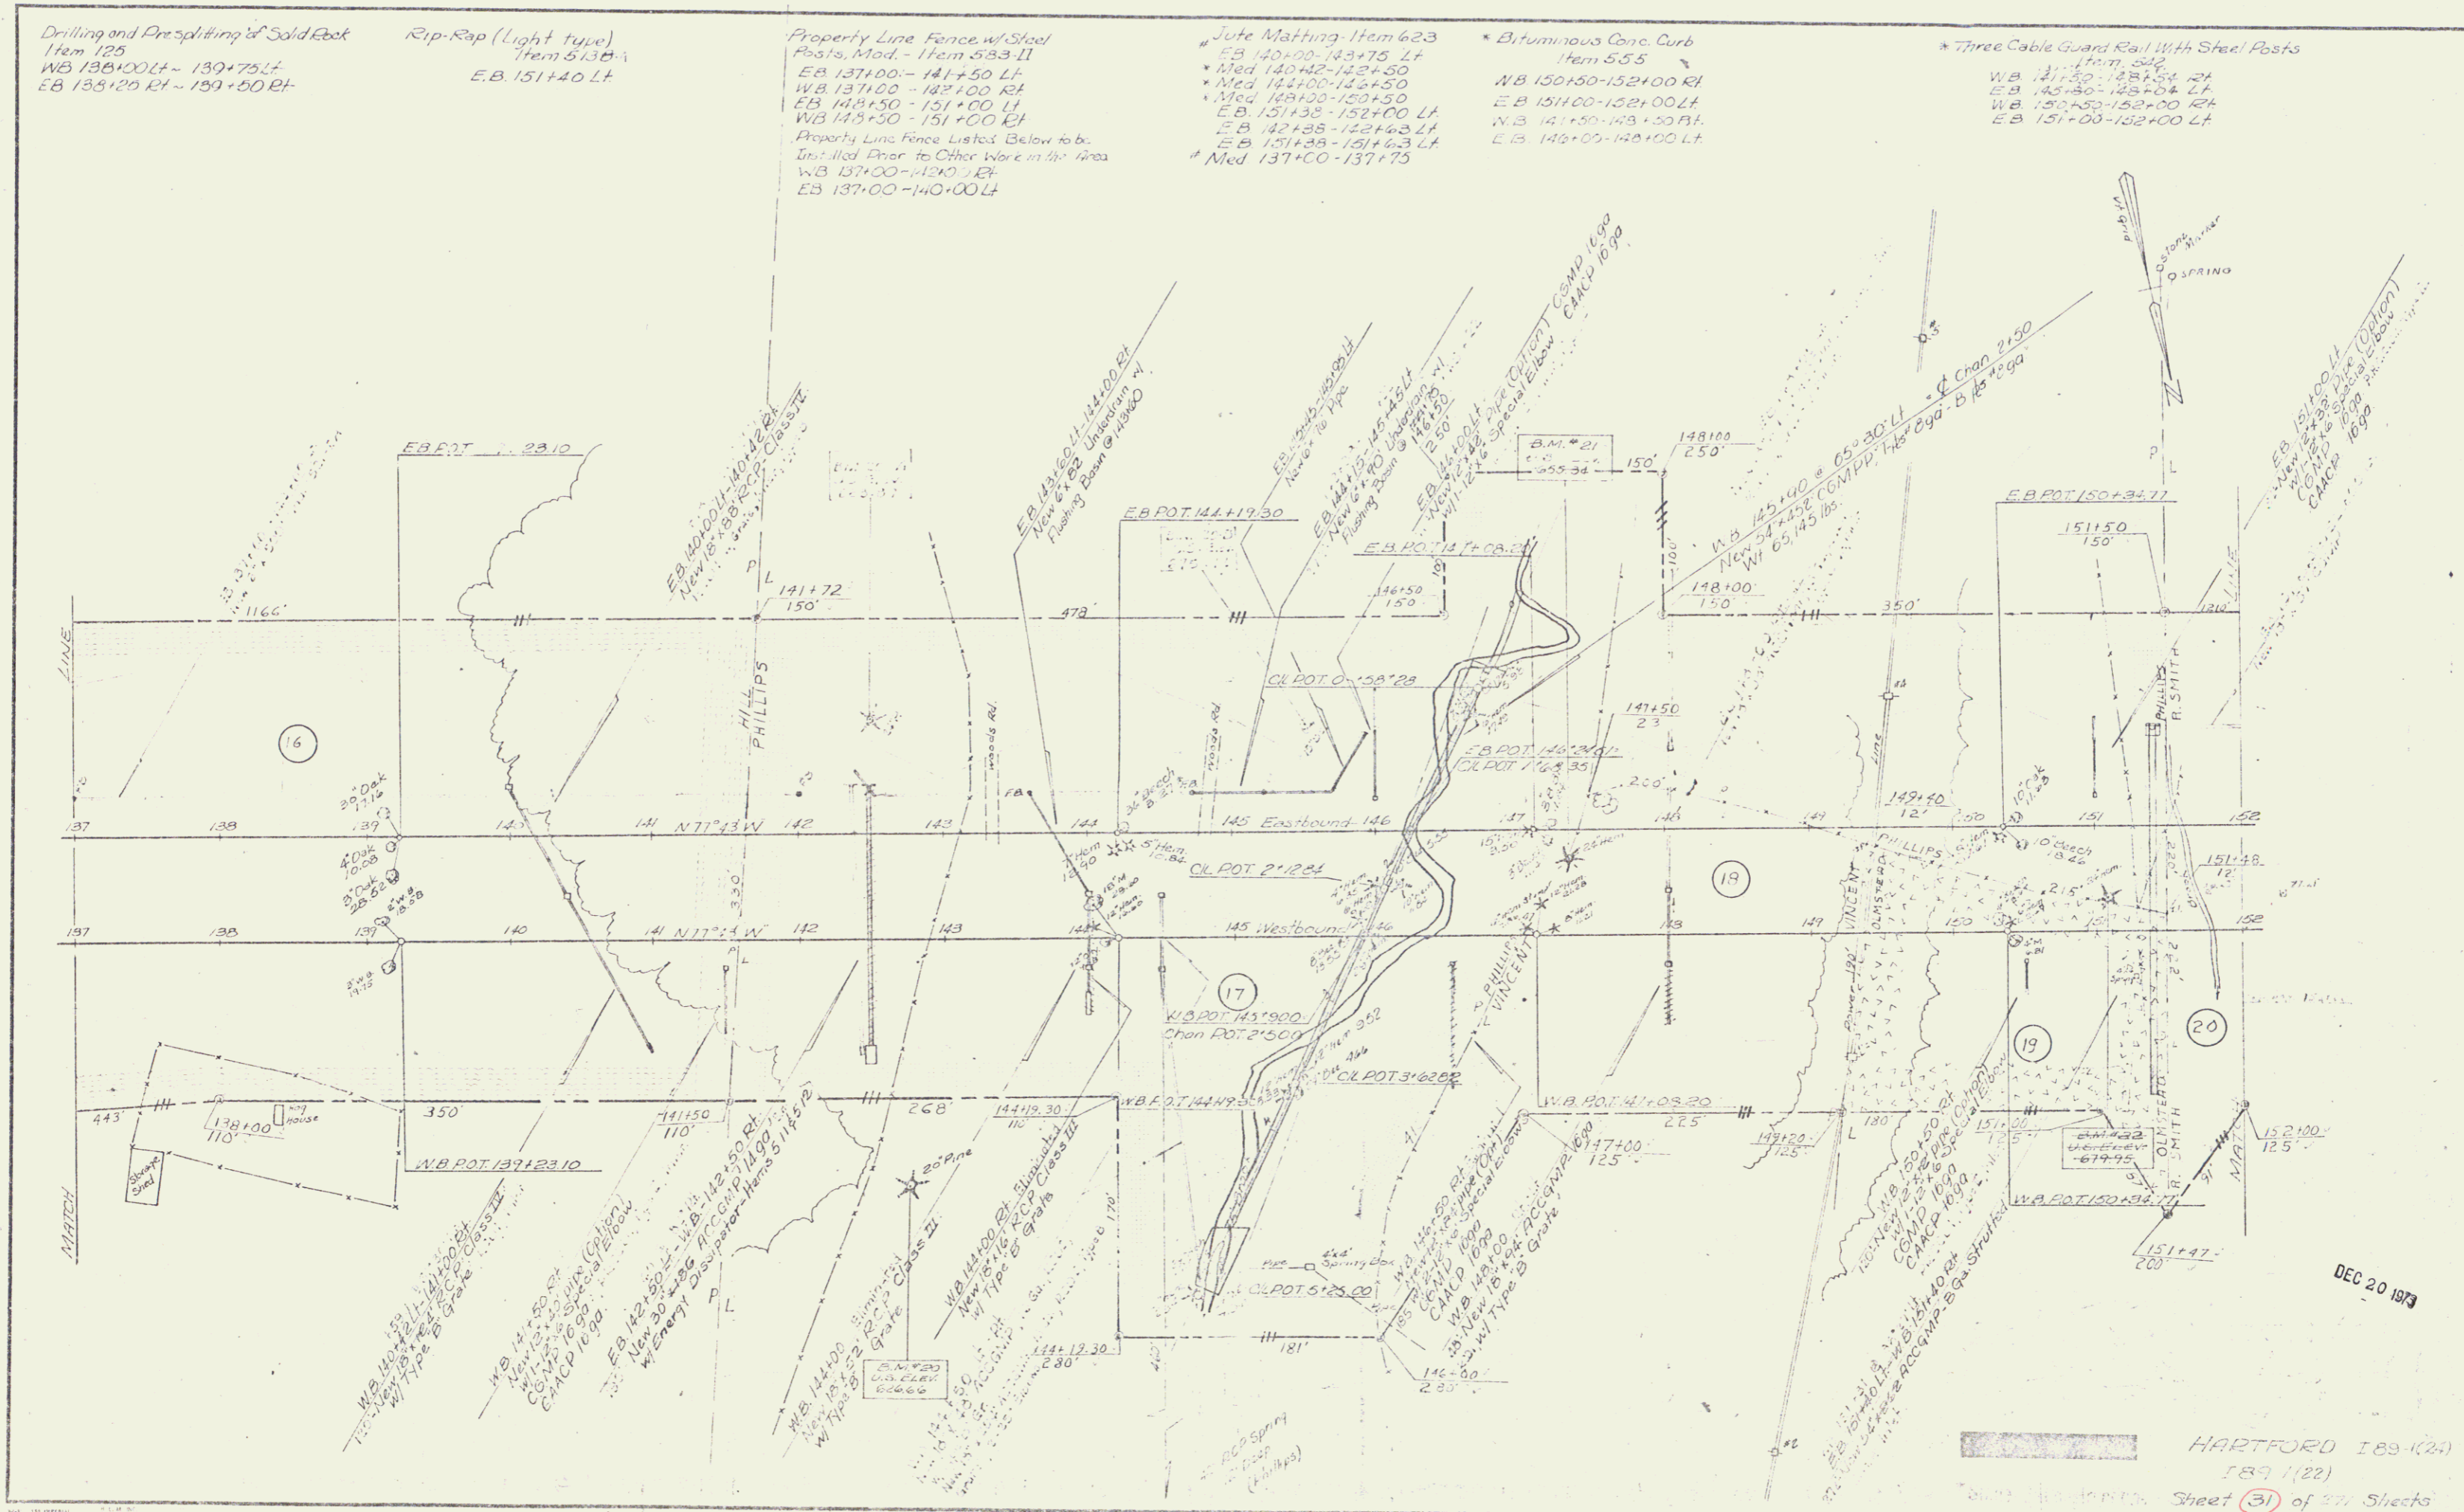

DEC 20 1973

HARTFORD 189 (24)  
189 (22)  
Sheet (3) of 27 Sheets  
Sheet 40 of 141