



Three Cable Guard Rail w/ Steel Posts.
Item 542

4 113+30 - 114+48 (L) (112)

Construct Drives
US 4 112+60 RT ✓
US 4 115+19 RT ✓
US 4 116+66 RT ✓

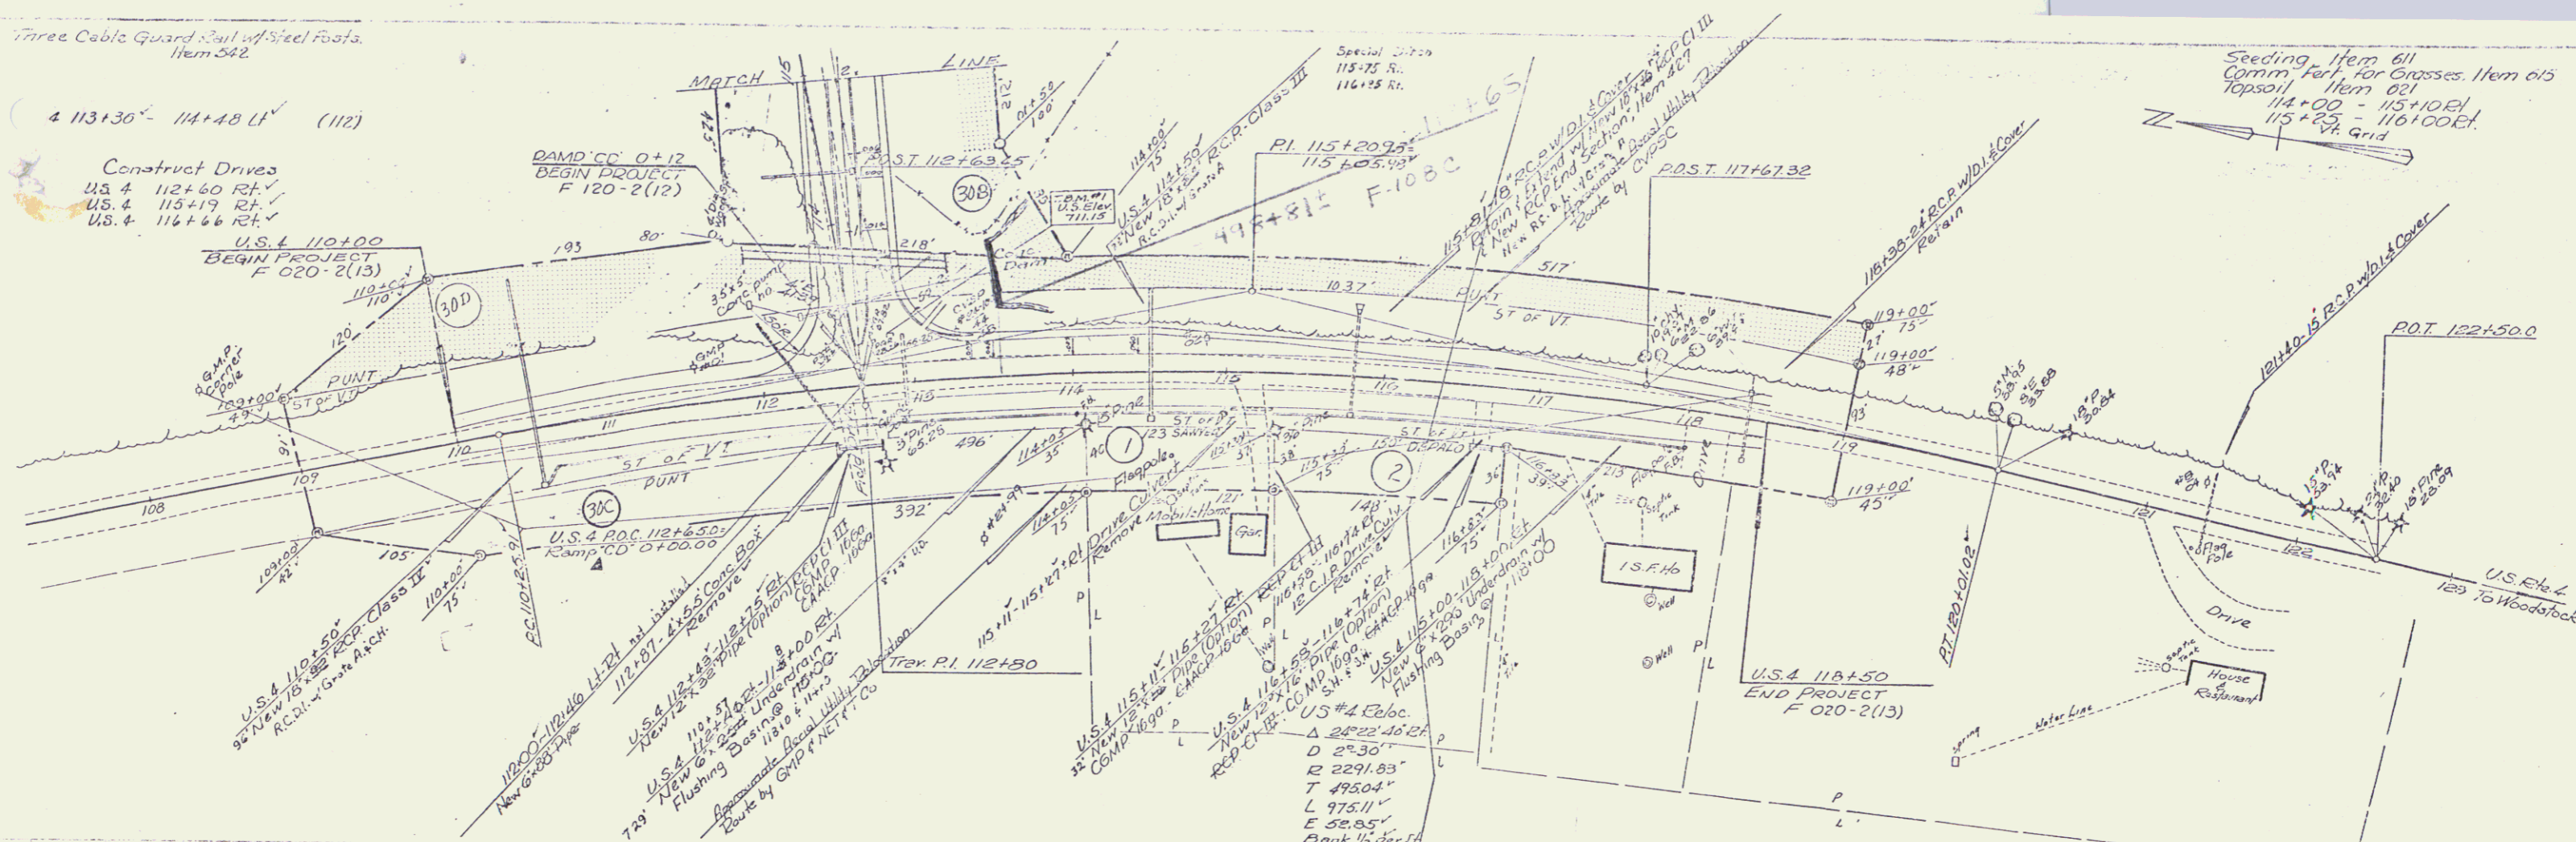

Seeding Item 611
Comm. Fert. for Grasses, Item 615
Topsoil Item 621
114+00 - 115+100ft.
115+20' Sta. Grid

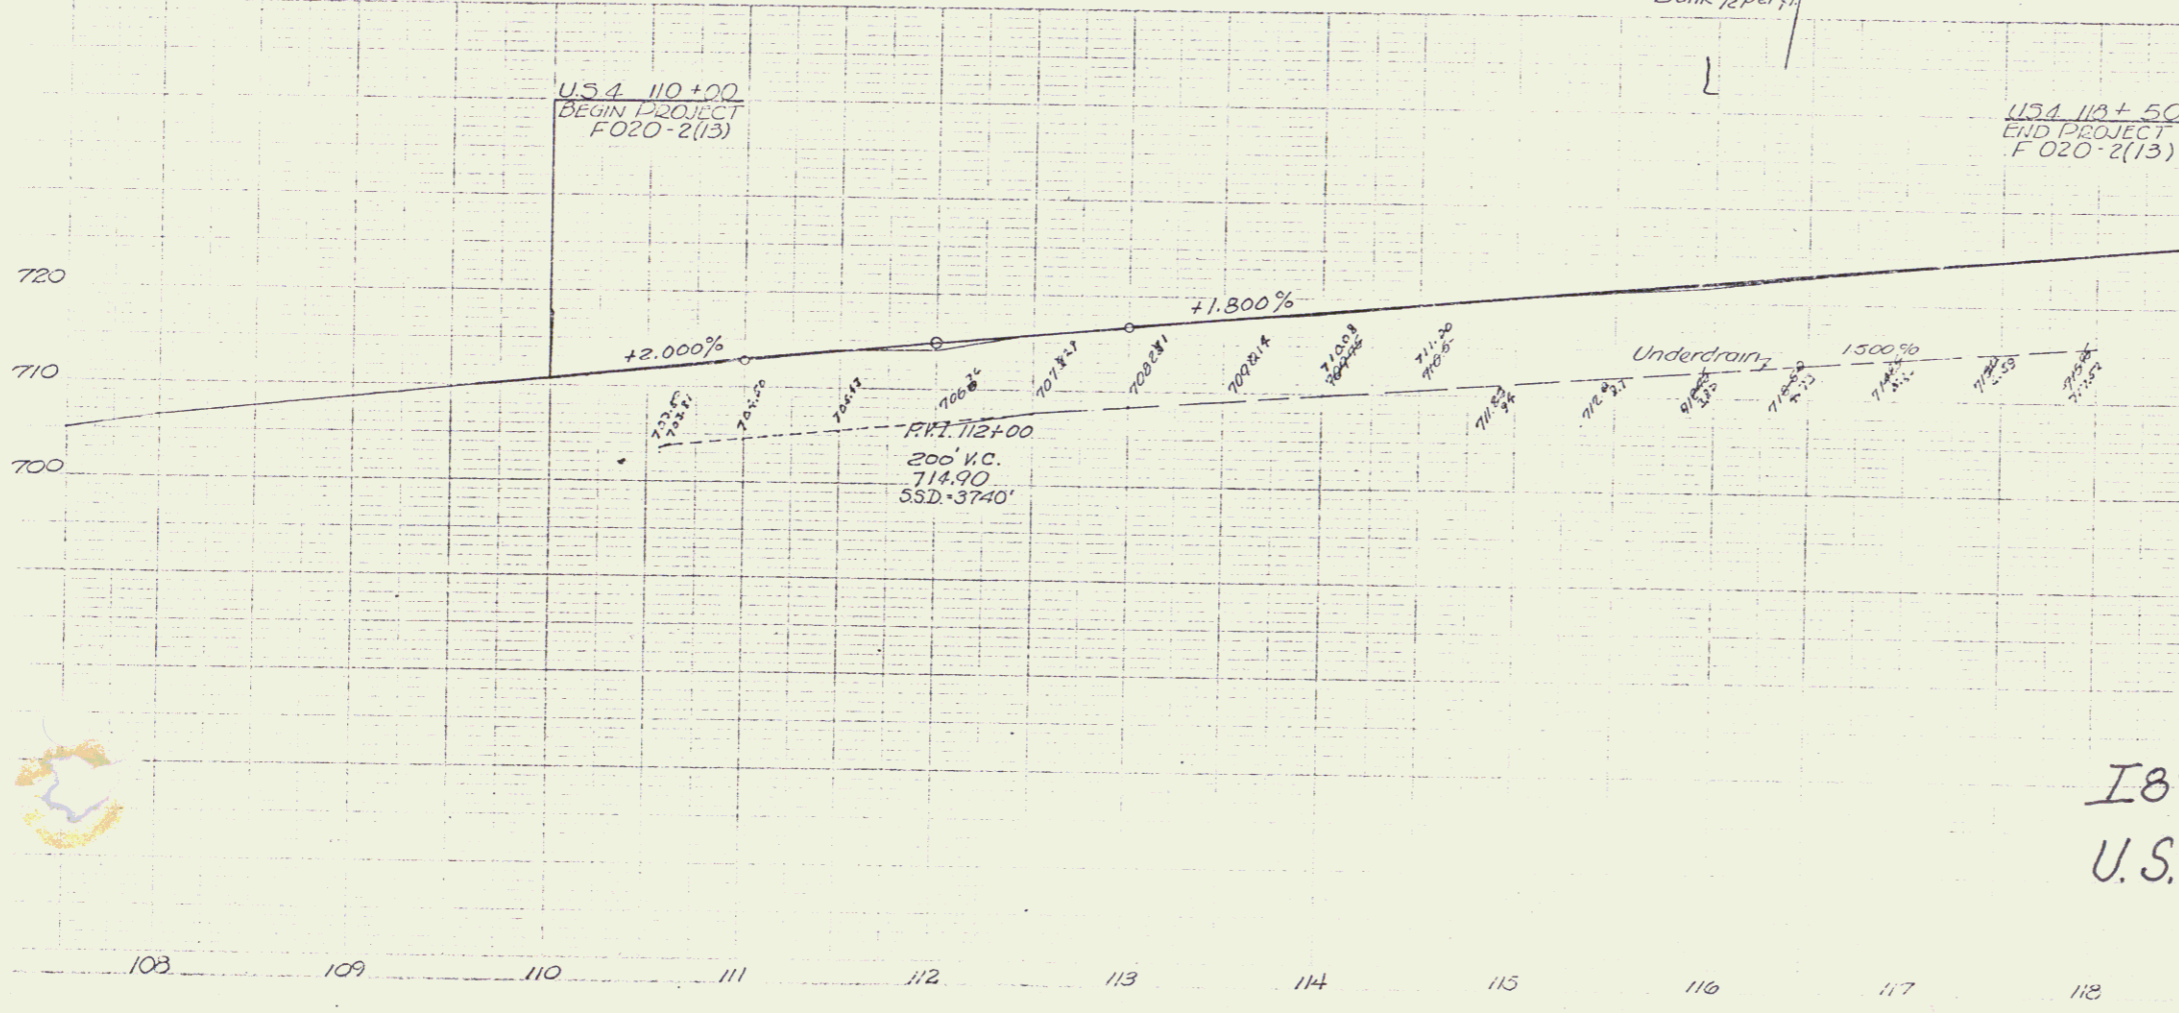

Stone Fill for Slope Protection
Sta. 115+75 RT.
Sta. 115+85 RT.

TO BE BUILT IN ITS ENTIRETY DURING
STAGE 1 CONSTRUCTION

I 89
U.S. Rte 4

Stage 1 Construction

Stage 2 Construction

HARTFORD
F020-2(13)
Sheet 45A of 40 Sheets
122 123