


TWO CABLE GUARD RAIL
 W/ WOOD POSTS - ITEM 0411
 TH 36 0+18 - 2+35 LT (232)
 TH 36 0+30 - 4+24 RT (208)
 TH 10 0+00 - 3+00 RT (240)
 TH 10 2+90 - 5+08 LT (210)
 TH 10 4+00 - 5+80 RT (120)
 Dev TH 10 7+26 - 9+00 RT (174)

BEGIN RELINQUISHMENT NO. III
 T.H. 36 0+95¢ (705')

END RELINQUISHMENT NO. III
 T.H. 36 8+00¢

BEGIN RELINQUISHMENT NO. I
 T.H. 10 -1+50¢ (1338')

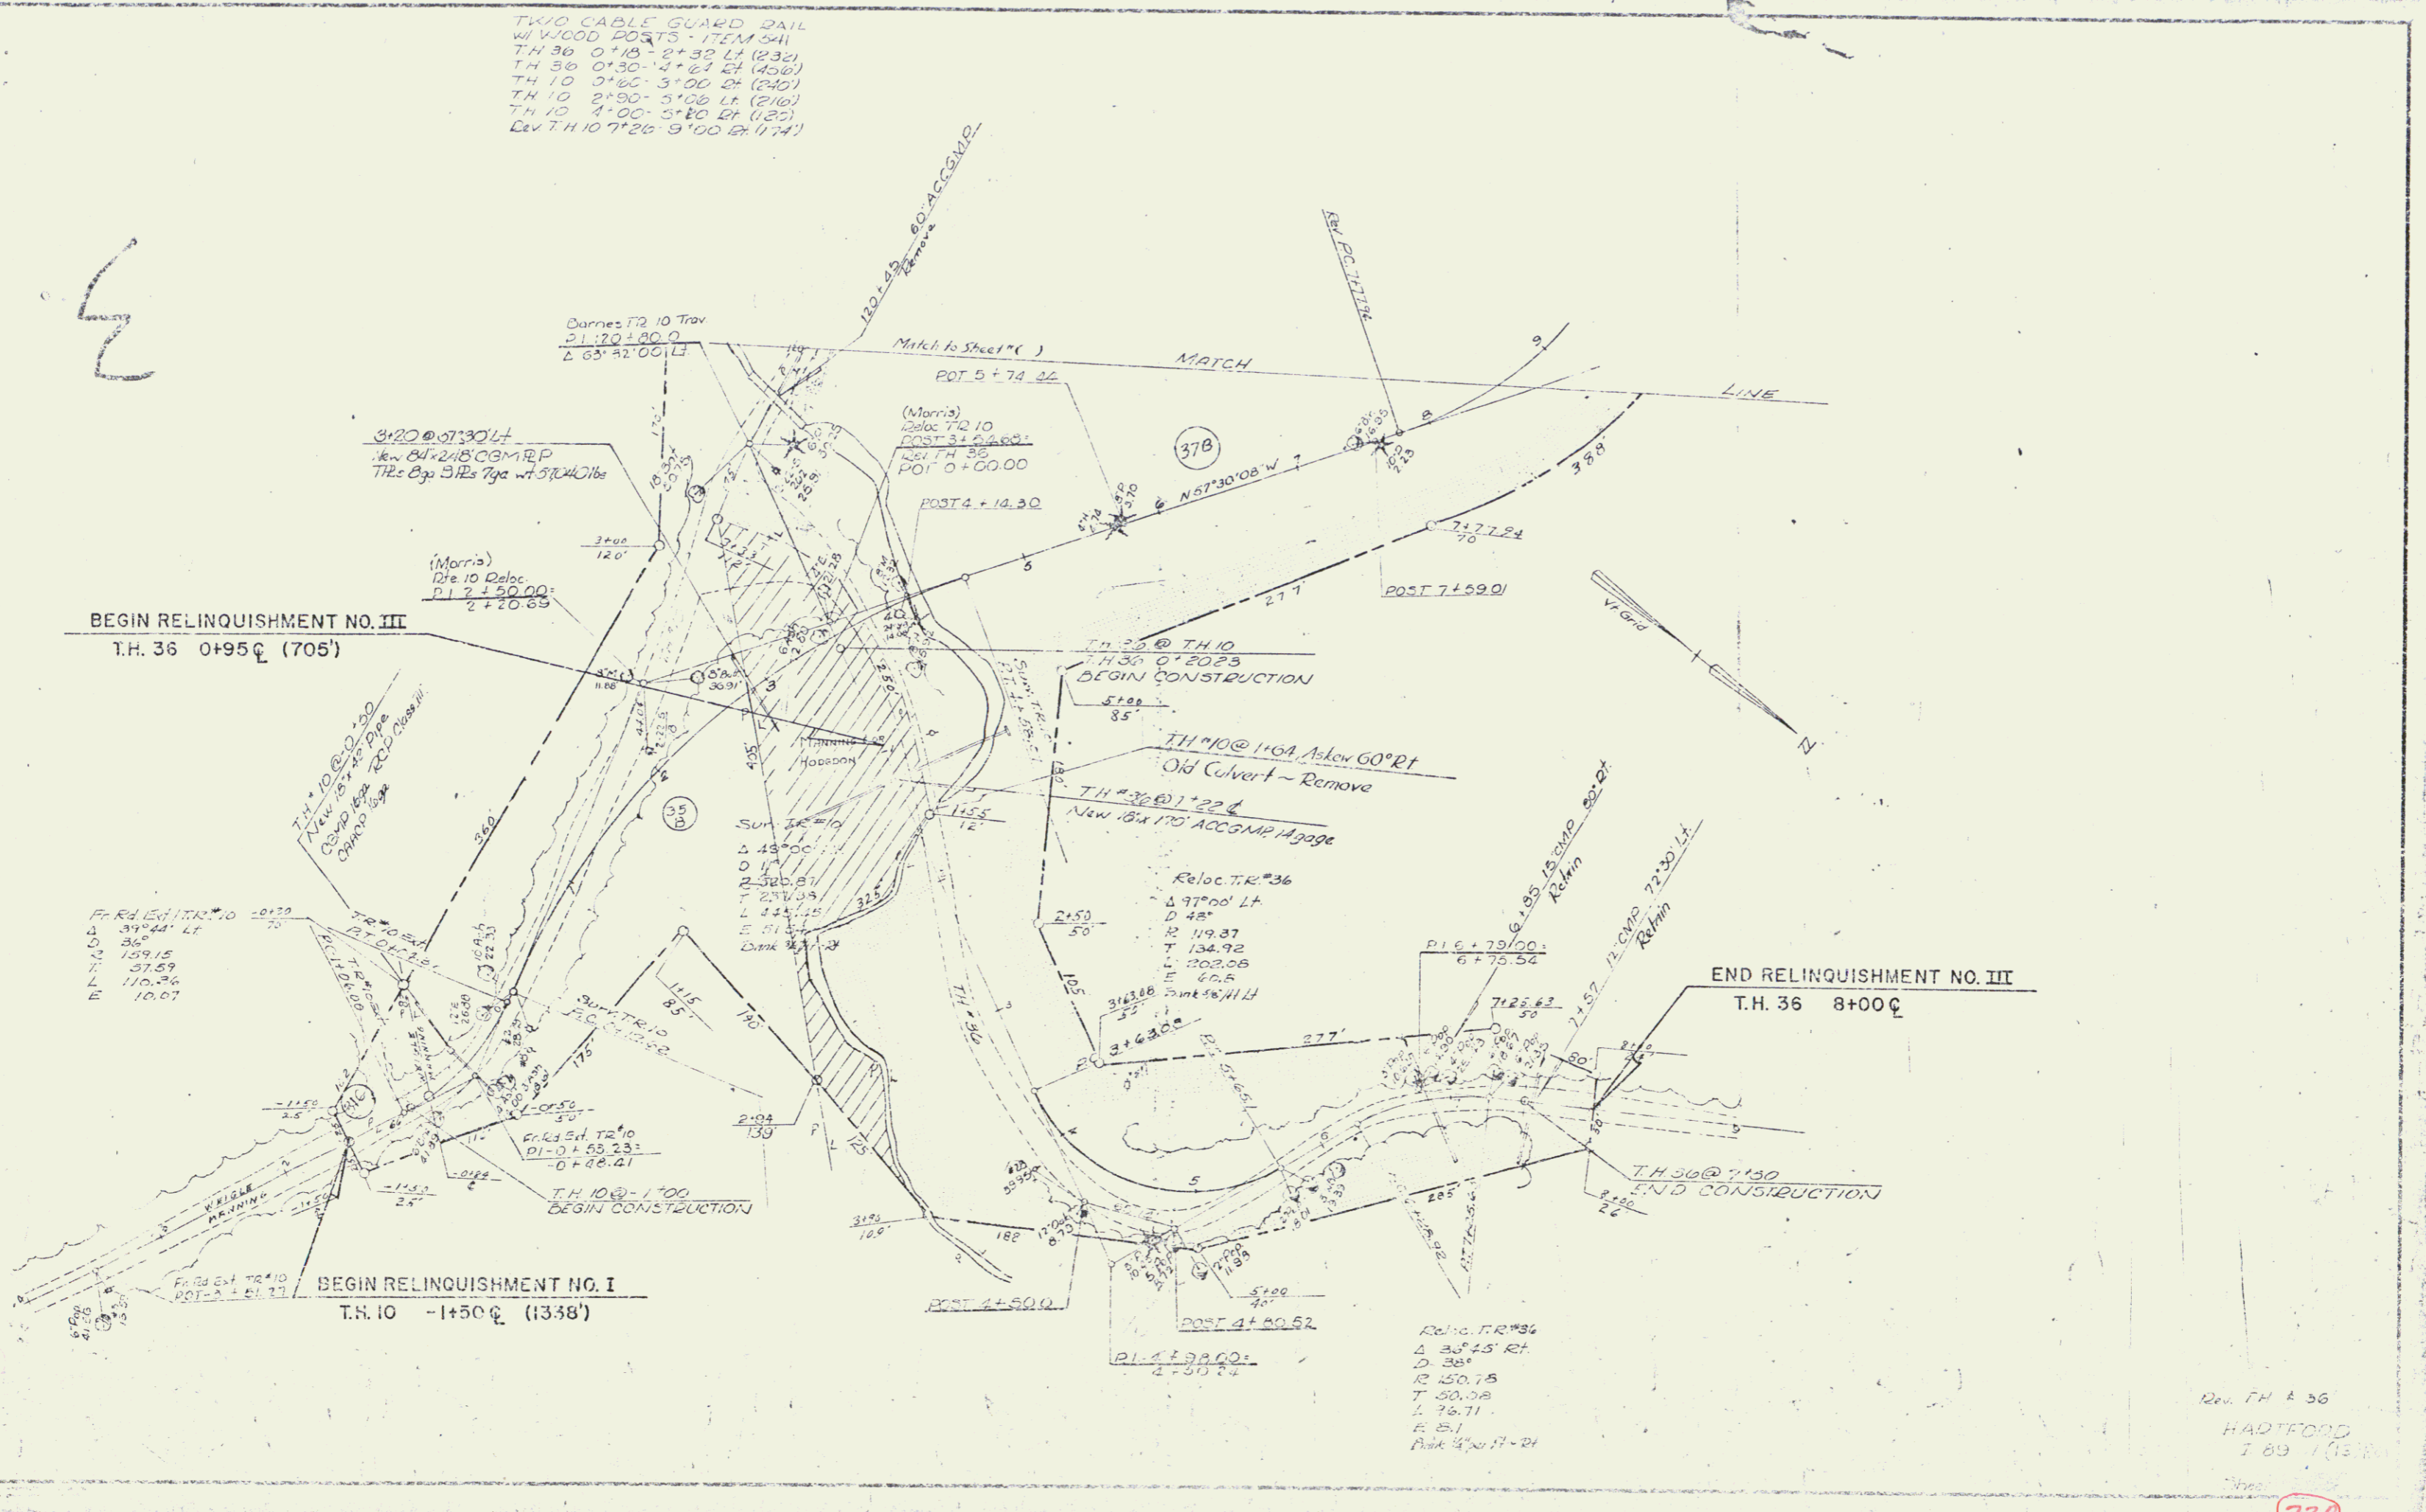

Rev. TH # 36
 HADTFORD
 T 89 1 (13)

226