


PLAN
 DATE 1/28/89
 DRAWN BY M. W. G.
 CHECKED BY M. W. G.
 NO. 1663

VERTICAL
 DATE 2/22/89
 DRAWN BY M. W. G.
 CHECKED BY M. W. G.
 NO. 1663

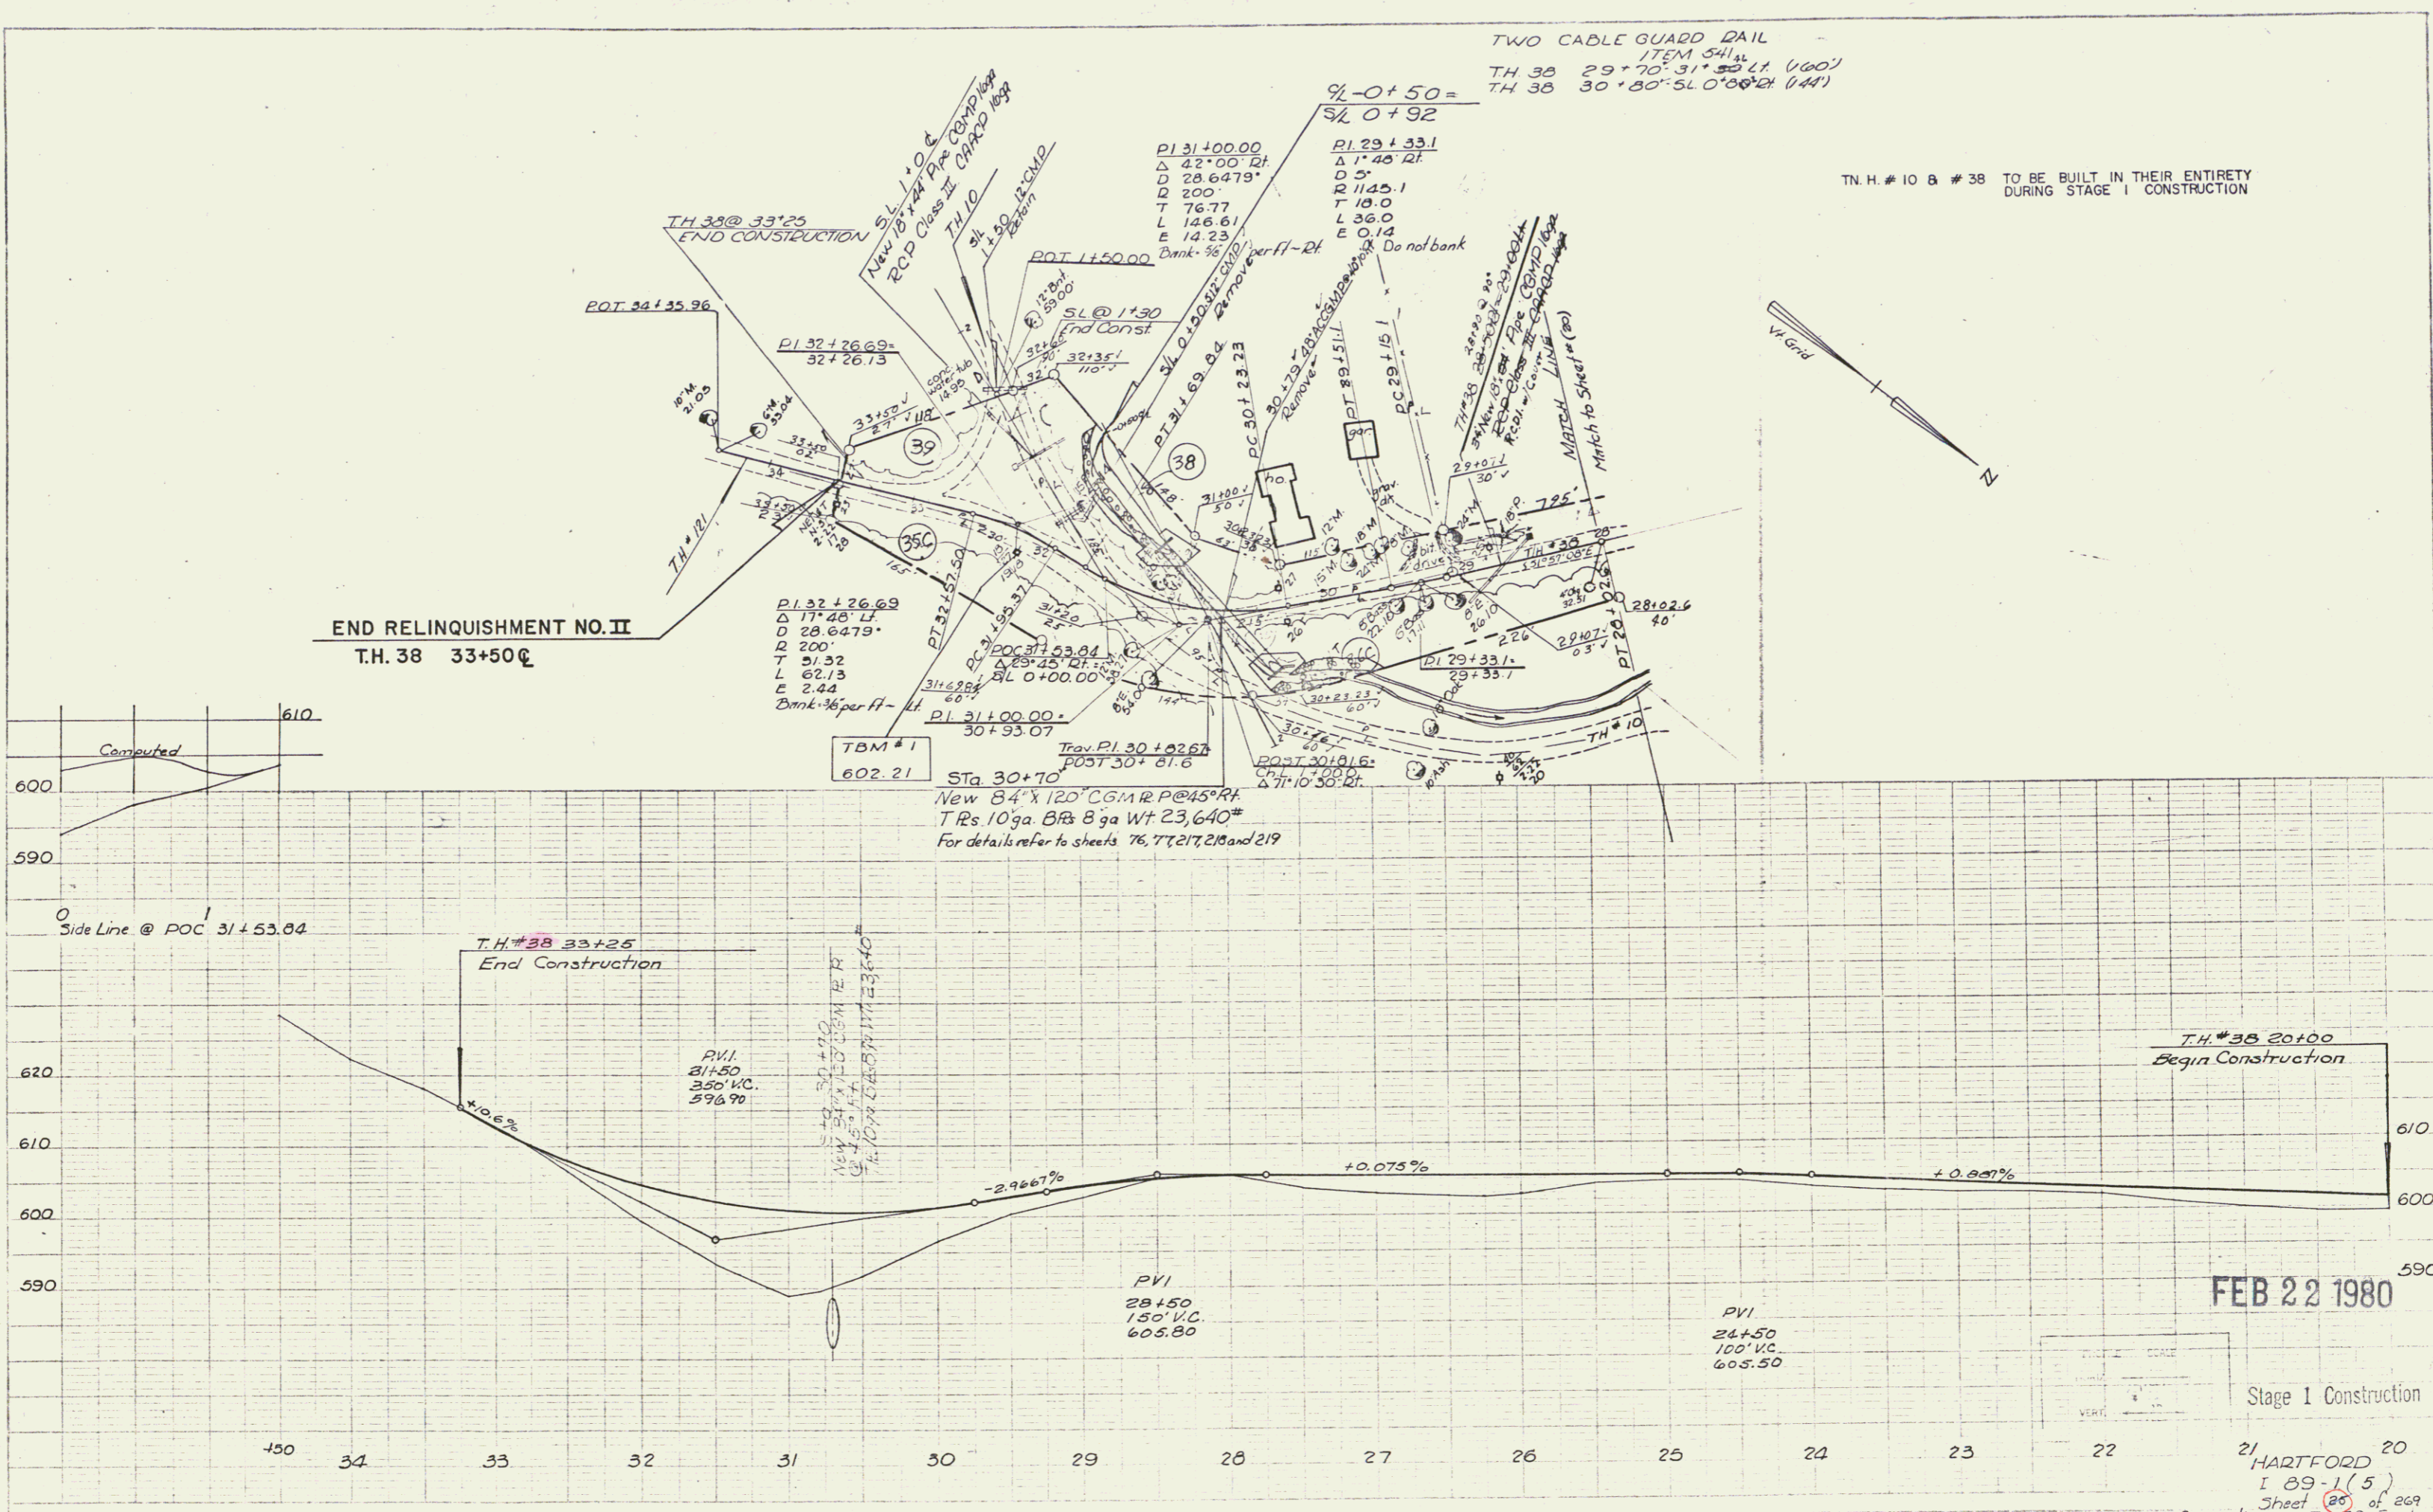

T.H. # 10 & # 38 TO BE BUILT IN THEIR ENTIRETY DURING STAGE I CONSTRUCTION

FEB 22 1980

Stage I Construction
 21 HARTFORD 20
 I 89-1(5)
 Sheet 20 of 209
 Connection of TH-38 Heritage Rd.
 from old TH 10 to Route TH 10