

Three Cable Guard Rail 15' Steel Posts
Item 543
 Southbound 317+00 to 332+00 LT
 Northbound 317+00 to 322+09 RT
 Northbound 323+80 to 325+20 RT
 Southbound 324+08 to 326+00 LT

Bituminous Concrete Curb
Item 535
 Northbound 319+75 RT
 Northbound 323+75 to 325+00 RT
 Southbound 324+25 to 326+00 LT


Stone Fill For Slope Protection
Item 522
 Southbound 324+00 to 324+62 LT
 Southbound 324+78 to 326+00 LT

Sub base of Sand, Med
Item 202
 Northbound 327+00 to 332+00
 Southbound 327+00 to 332+00

Gravel Backfill
Item 222
 Northbound 327+00 to 332+00
 Southbound 327+00 to 332+00

Two Cable Guard Rail
1/2 Wood Posts, Item 542
 TH #36 33+00 to 33+70 RT

DATE: 11/15/00
 DRAWN BY: J. J. [unclear]
 CHECKED BY: [unclear]
 SCALE: AS SHOWN

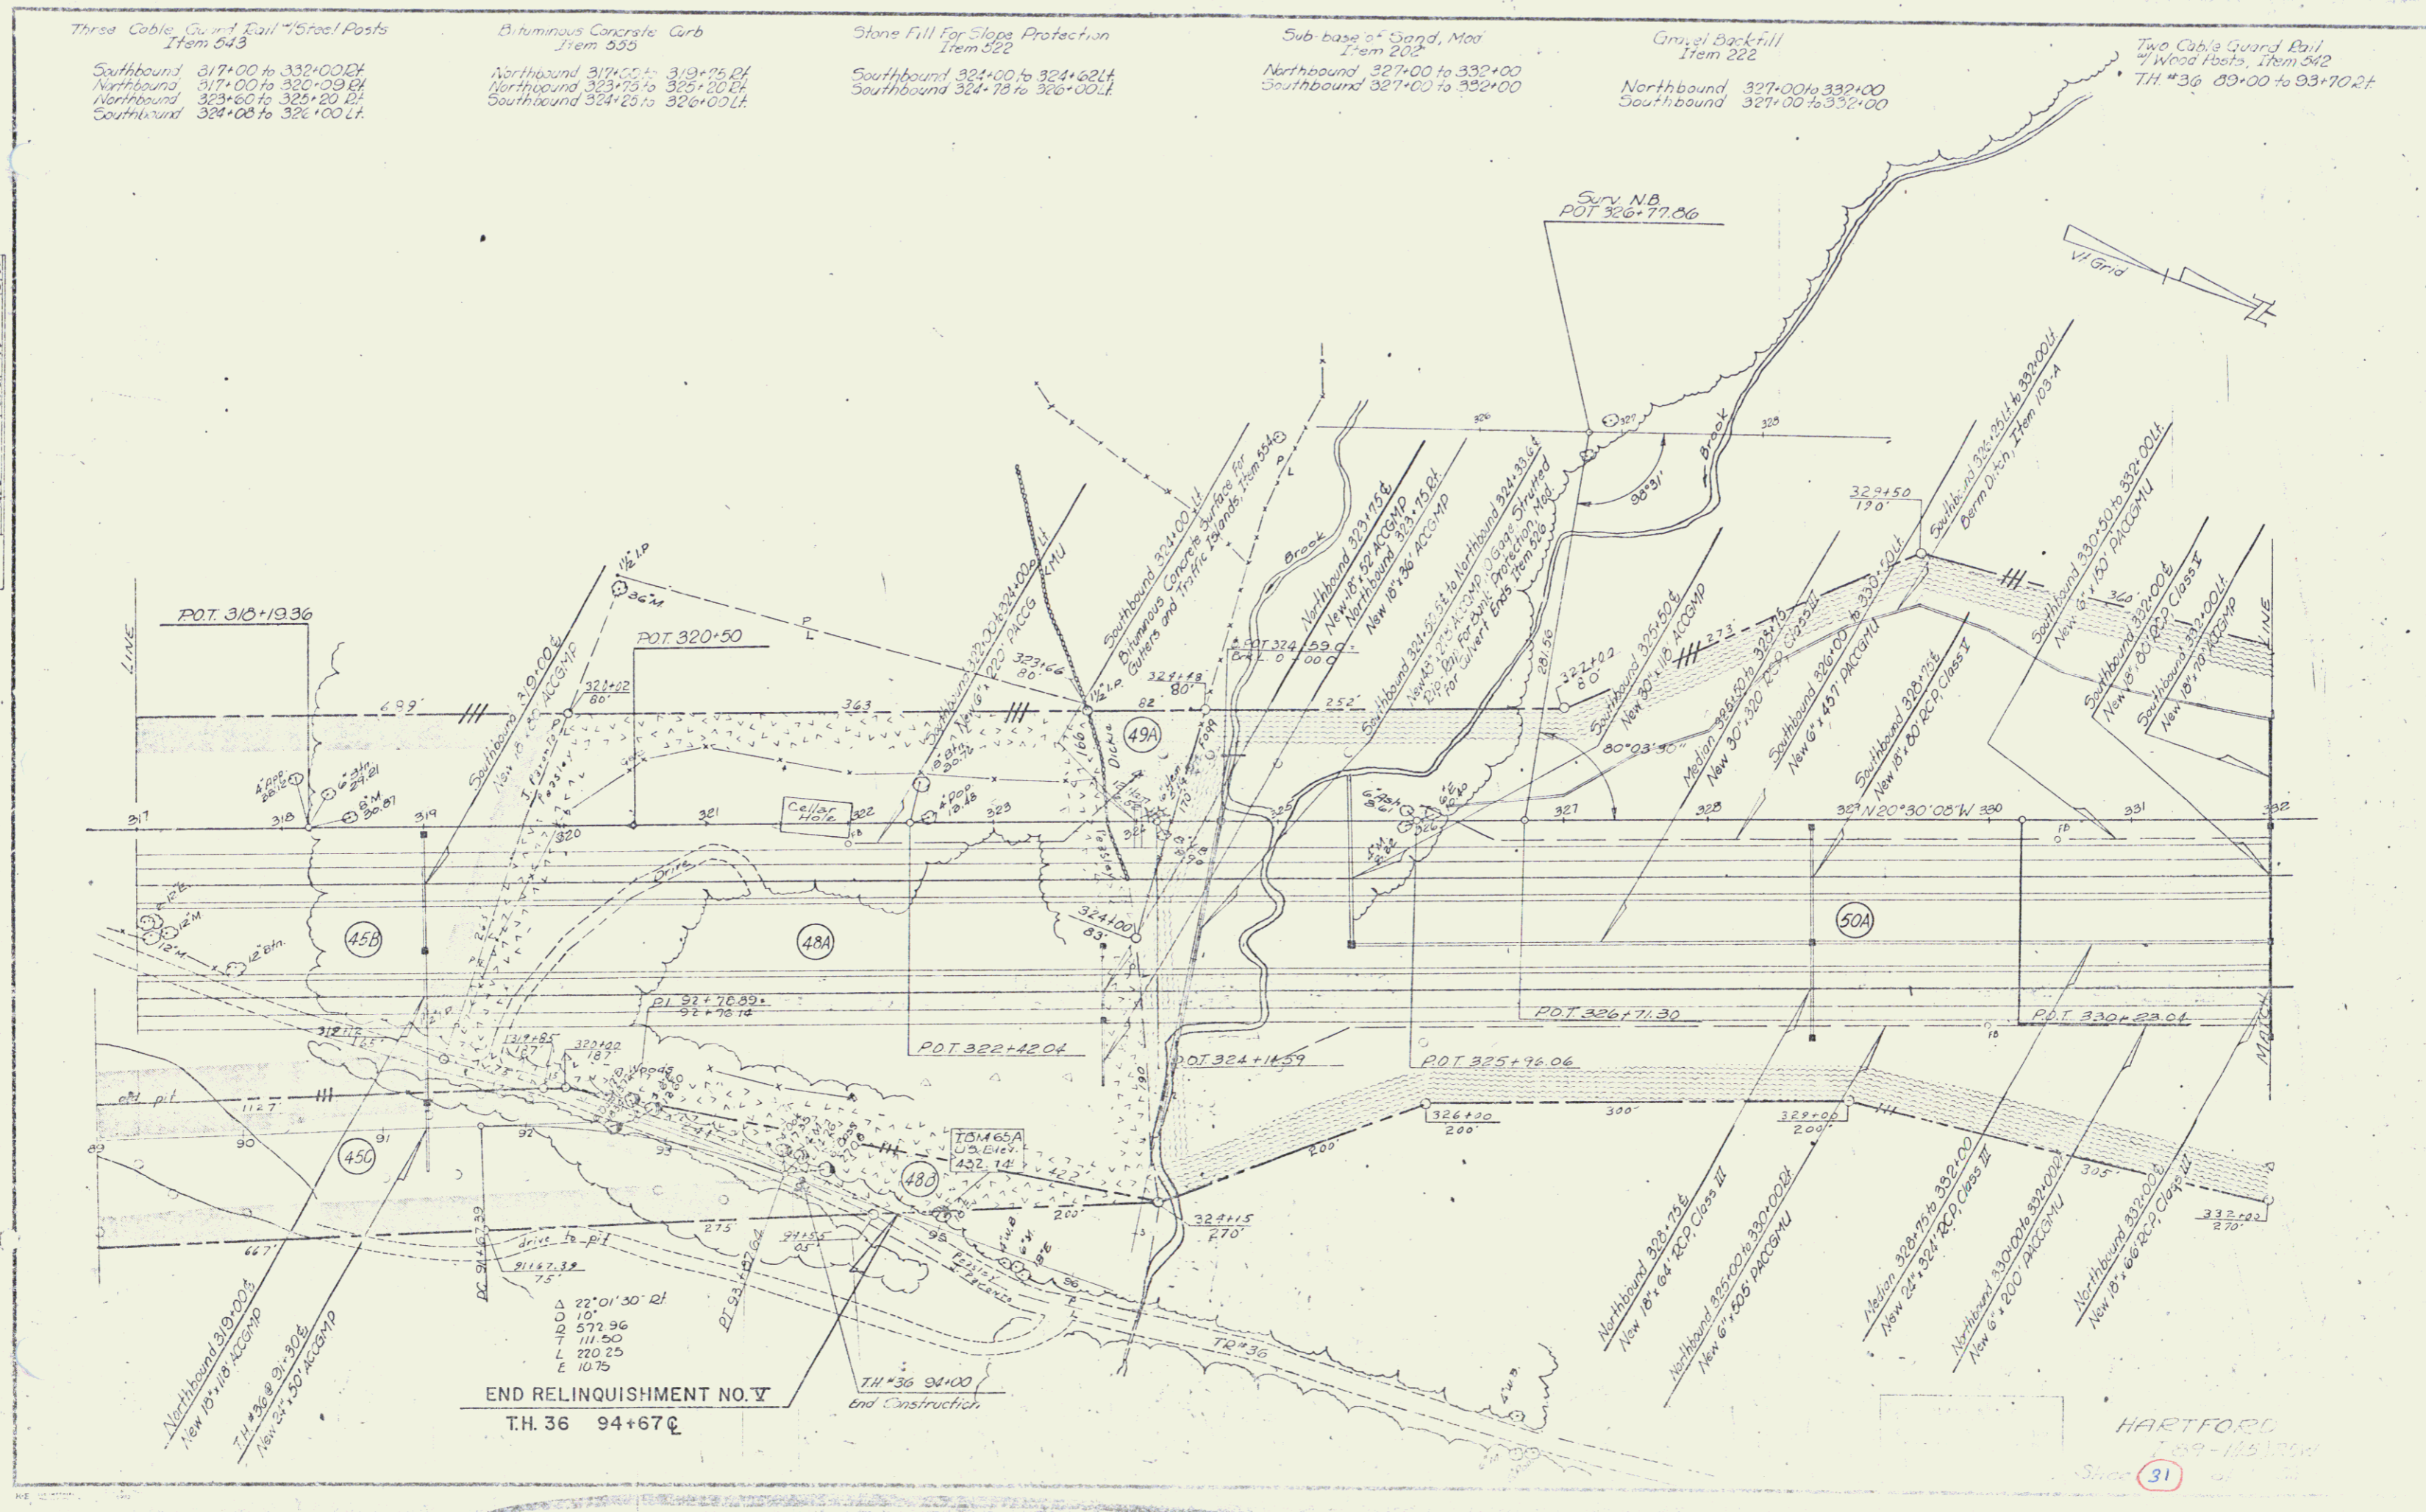

END RELINQUISHMENT NO. V
 T.H. 36 94+67.6

TH #36 94+00
 end Construction

HARTFORD
 159-115120W
 Sheet 31