


Bituminous Concrete Curb  
Item 555  
Northbound 362+60 to 363+00LT

Three Cable Guard Rail 1/2 Steel Posts  
Item 343  
Northbound 362+00 to 363+00RT

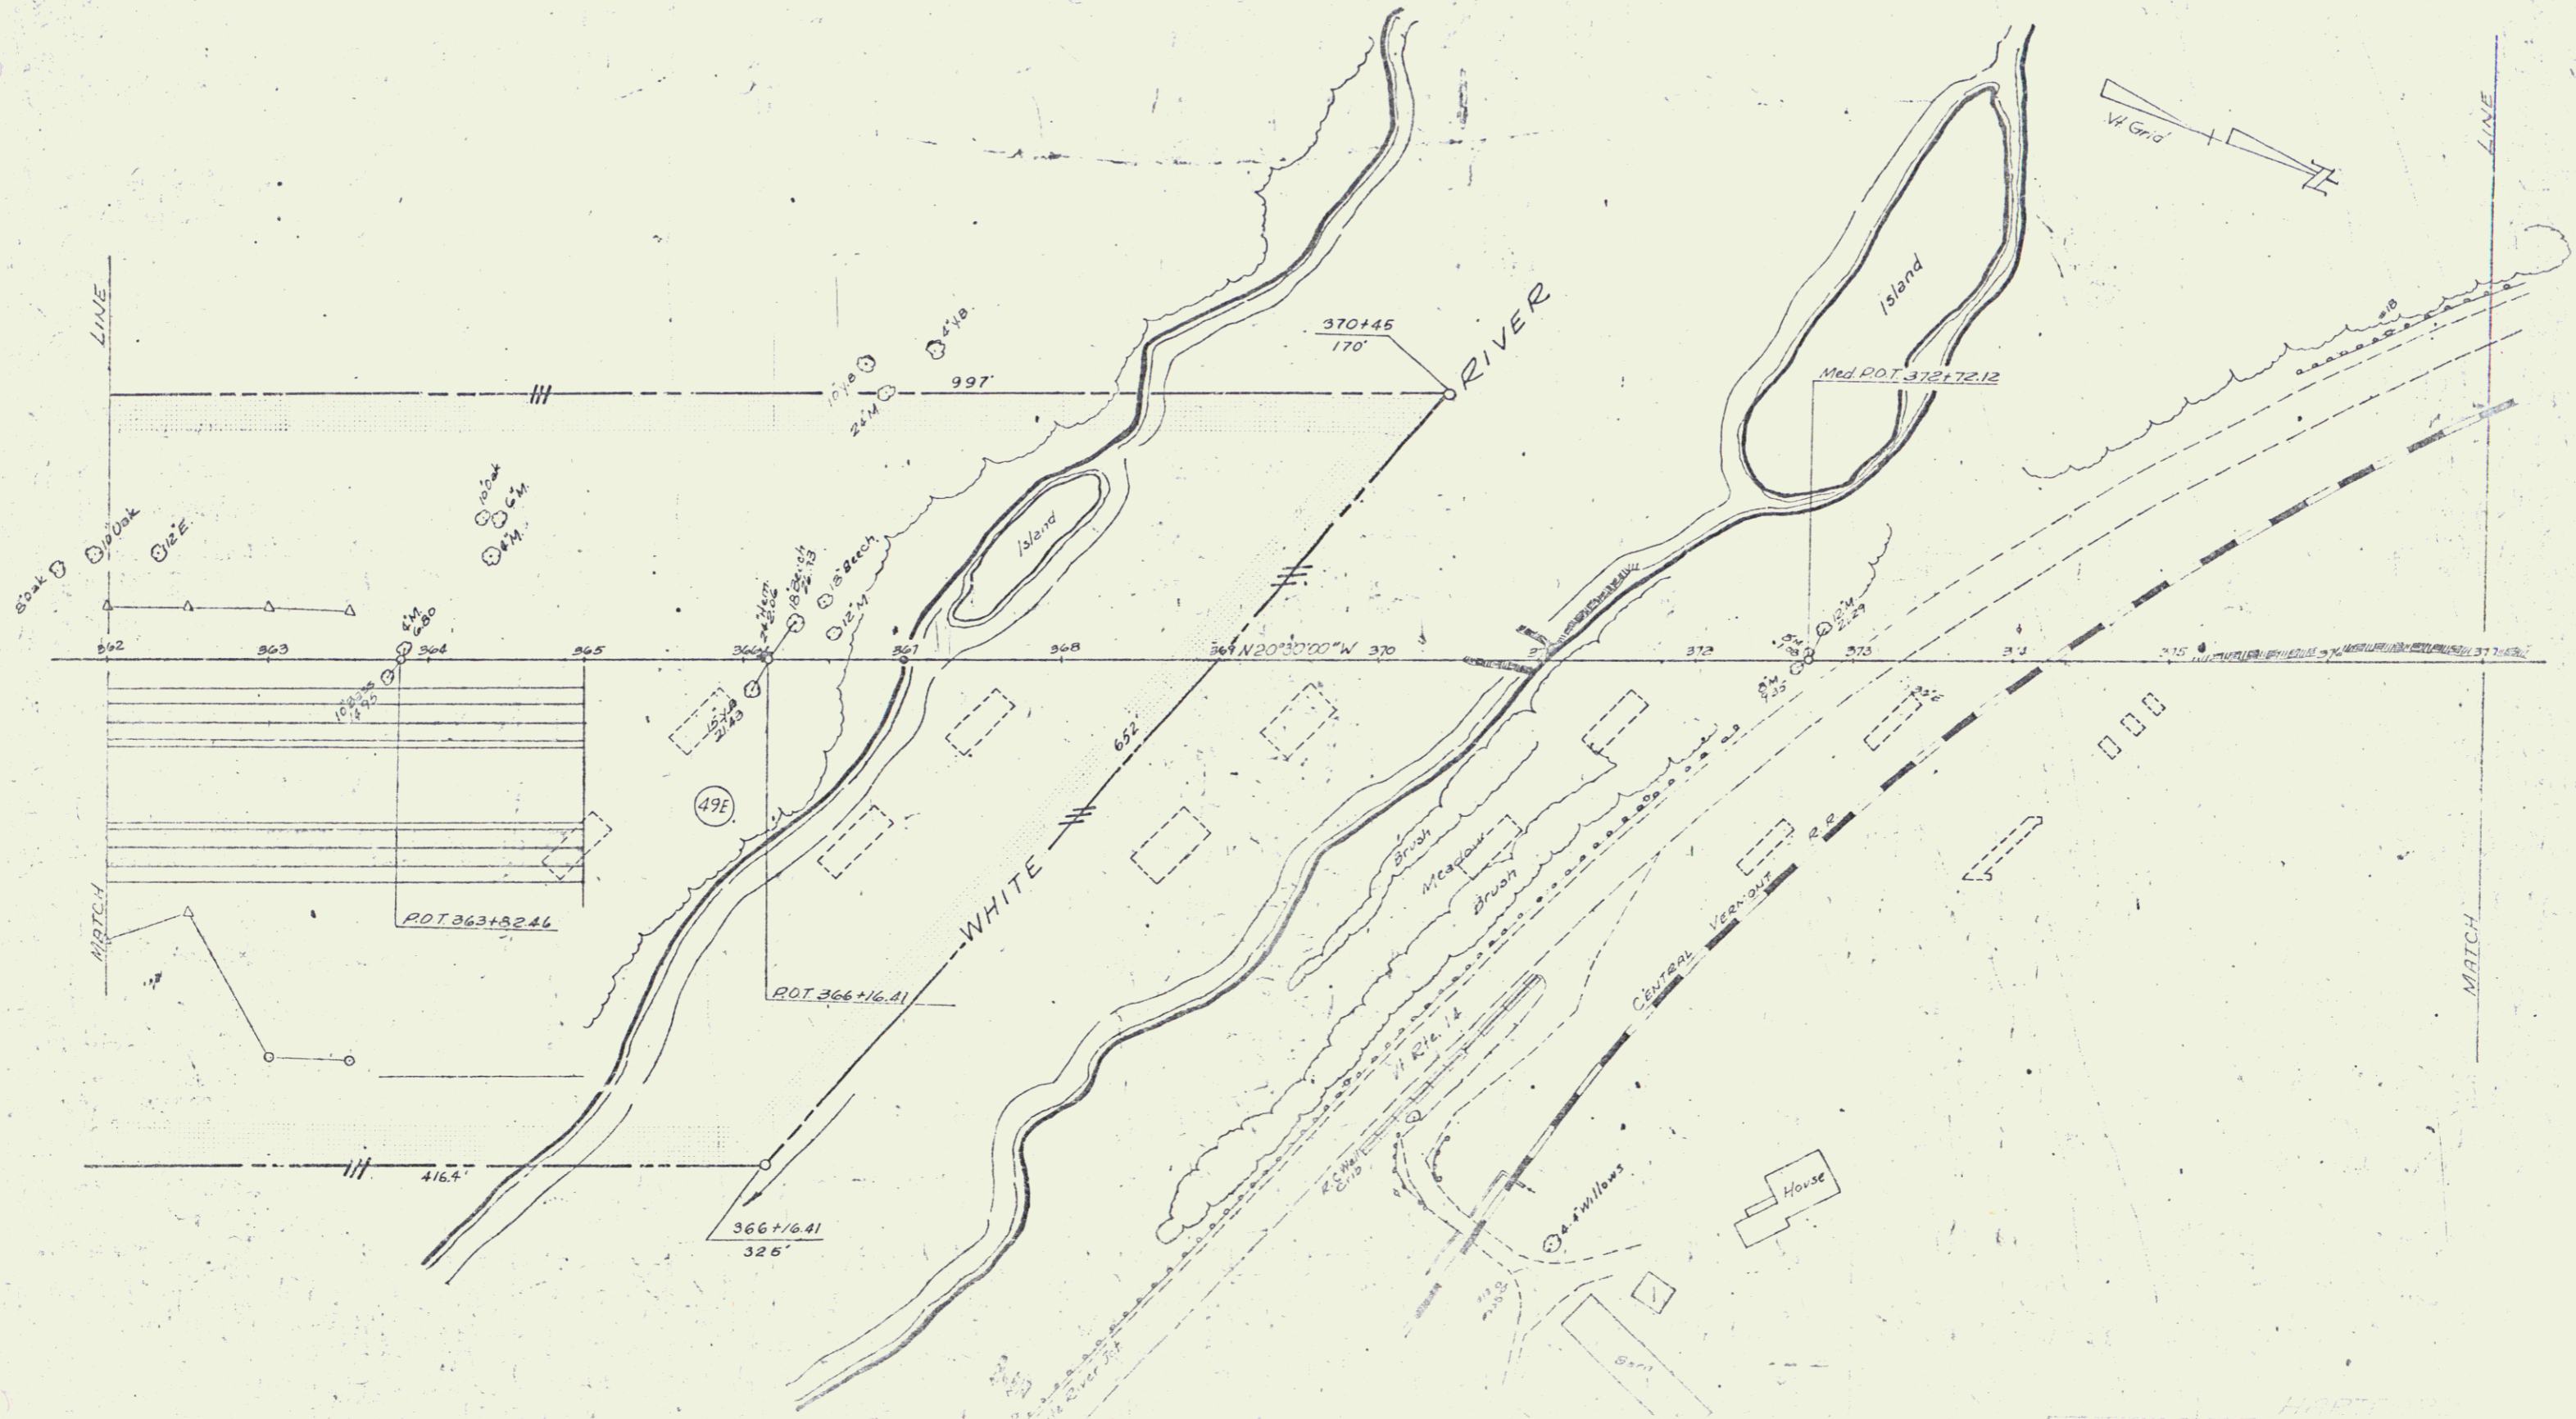

(15) ROW  
SHEET 34