

THREE CABLE GUARD RAIL
W/STEEL POSTS, ITEM 542
404+50 - 411+18 S.D. LT.
417+70 - 418+00 S.D. LT.
403+50 - 411+72 NB. LT.


BITUMINOUS CONCRETE
GUTTER, ITEM 504
411+25 - 411+50 S.D. LT.

BITUMINOUS CONCRETE
CURB TYPE II, ITEM 505
NB 405+52 - 411+35 LT.
S.D. 404+50 - 411+18 LT.

SUB-BASE OF SAND
ITEM 502
NB 418+25 - 417+25
S.D. 411+50 - 416+00

JUTE MATTING
ITEM 1023
S.D. 406+55 - 413+50 LT.

DRILLING AND BLASTING
OF SOLID ROCK SUBGRADE
ITEM 115
NB. 403+50 - 408+00

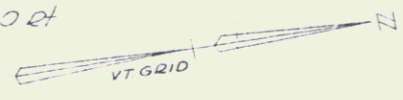

NOT TO SCALE
 1" = 40'
 1" = 20'
 1" = 10'
 1" = 5'
 1" = 2.5'
 1" = 1.25'
 1" = 0.625'
 1" = 0.3125'
 1" = 0.15625'
 1" = 0.078125'
 1" = 0.0390625'
 1" = 0.01953125'
 1" = 0.009765625'
 1" = 0.0048828125'
 1" = 0.00244140625'
 1" = 0.001220703125'
 1" = 0.0006103515625'
 1" = 0.00030517578125'
 1" = 0.000152587890625'
 1" = 0.0000762939453125'
 1" = 0.00003814697265625'
 1" = 0.000019073486328125'
 1" = 0.0000095367431640625'
 1" = 0.00000476837158203125'
 1" = 0.000002384185791015625'
 1" = 0.0000011920928955078125'
 1" = 0.00000059604644775390625'
 1" = 0.000000298023223876953125'
 1" = 0.0000001490116119384765625'
 1" = 0.00000007450580596923828125'
 1" = 0.000000037252902984619140625'
 1" = 0.0000000186264514923095703125'
 1" = 0.00000000931322574615478515625'
 1" = 0.000000004656612873077392578125'
 1" = 0.0000000023283064365386962890625'
 1" = 0.00000000116415321826934814453125'
 1" = 0.00000000058207660913467407171875'
 1" = 0.000000000291038304567337035859375'
 1" = 0.0000000001455191522836685179296875'
 1" = 0.00000000007275957614183425896484375'
 1" = 0.000000000036379788070917124482421875'
 1" = 0.0000000000181898940354585622412109375'
 1" = 0.0000000000090949470177292811206046875'
 1" = 0.00000000000454747350886456103030234375'
 1" = 0.000000000002273736754432280515151171875'
 1" = 0.000000000001136868377216140257575890625'
 1" = 0.0000000000005684341886080701287879453125'
 1" = 0.00000000000028421709430403506439397265625'
 1" = 0.000000000000142108547152017532196986328125'
 1" = 0.0000000000000710542735760087660984931640625'
 1" = 0.00000000000003552713678800438304924658203125'
 1" = 0.000000000000017763568394002191514623291015625'
 1" = 0.0000000000000088817841970010957573116456078125'
 1" = 0.0000000000000044408920985005478786558228125'
 1" = 0.00000000000000222044604925027393932791140625'
 1" = 0.000000000000001110223024625136969663955703125'
 1" = 0.0000000000000005551115123125584848319778515625'
 1" = 0.0000000000000002775557561562792424198892890625'
 1" = 0.00000000000000013877787807813962124944464453125'
 1" = 0.000000000000000069388939039069810624722322265625'
 1" = 0.000000000000000034694469519534905312361111328125'
 1" = 0.00000000000000001734723475976745265615556640625'
 1" = 0.000000000000000008673617379883726328077783203125'
 1" = 0.0000000000000000043368086899418631640388916015625'
 1" = 0.00000000000000000216840434497093157019444480078125'
 1" = 0.000000000000000001084202172485465785097222400390625'
 1" = 0.0000000000000000005421010862427328750486112001953125'
 1" = 0.00000000000000000027105054312136643752430560009765625'
 1" = 0.000000000000000000135525271560683218762152800048828125'
 1" = 0.000000000000000000067762635780341609381064000244140625'
 1" = 0.0000000000000000000338813178901708046905320001220703125'
 1" = 0.00000000000000000001694065894508540234526400006103515625'
 1" = 0.0000000000000000000084703294725427011722630000030517578125'
 1" = 0.0000000000000000000042351647362713505861315000001525890625'
 1" = 0.000000000000000000002117582368135675293065750000007629453125'
 1" = 0.00000000000000000000105879118406783764653287500000038147265625'
 1" = 0.0000000000000000000005293955920339187322664375000000190736328125'
 1" = 0.000000000000000000000264697796016959366133218750000000953681640625'
 1" = 0.00000000000000000000013234889800847968330660937500000004768408203125'
 1" = 0.0000000000000000000000661744490042398415330304687500000023842041015625'
 1" = 0.000000000000000000000033087224502119920766515234375000000119210205078125'
 1" = 0.000000000000000000000016543612251059960382757619375000000596051025390625'
 1" = 0.00000000000000000000000827180612552998019137888968750000029802551271953125'
 1" = 0.000000000000000000000004135903062764994046894444843750000149012756389578125'
 1" = 0.000000000000000000000002067951531382497023447222421875000007450637819440625'
 1" = 0.0000000000000000000000010339757656912485117236111120937500003725318947203125'
 1" = 0.00000000000000000000000051698788284562425586180555604687500018626594736015625'
 1" = 0.0000000000000000000000002584939414228122778089027780234375000093132973680078125'
 1" = 0.00000000000000000000000012924697071140563894444444011718750000465664868400390625'
 1" = 0.000000000000000000000000064623485355702819472222220058937500002328324342001953125'
 1" = 0.000000000000000000000000032311742677851424711111100294687500011641621710009765625'
 1" = 0.0000000000000000000000000161558713389271235555555001473437500058208108550048828125'
 1" = 0.000000000000000000000000008077935669463561777777750007367187500291040542750244140625'
 1" = 0.00000000000000000000000000403896783473178088888875000368359375001455202713751220703125'
 1" = 0.000000000000000000000000002019483917365890444444375000184179687500072760136876015625'
 1" = 0.0000000000000000000000000010097419586829452222221875000092089843750036380068438078125'
 1" = 0.0000000000000000000000000005048709793414726111110937500004604492187500181900342190390625'
 1" = 0.0000000000000000000000000002524354896707363055555468750000230224609375000909501710951953125'
 1" = 0.000000000000000000000000000126217744835368152777772343750000115112304687500454750855476078125'
 1" = 0.0000000000000000000000000000631088724176840763888811718750000575561534375002273754277380390625'
 1" = 0.0000000000000000000000000000315544362088420381944445893750000287780767187501136877136876015625'
 1" = 0.00000000000000000000000000001577721810442101909722222937500014389038359375056843871368760078125'
 1" = 0.0000000000000000000000000000078886090522105095486111114687500007194519179687502842193687600390625'
 1" = 0.0000000000000000000000000000039443045261052547727777234375000035972595893750142109684380390625'
 1" = 0.000000000000000000000000000001972152263052627386888811718750000179862979375007105482193687601953125'
 1" = 0.000000000000000000000000000000986076131526313694444458937500008993148968750035527136876009765625'
 1" = 0.000000000000000000000000000000493038065763168472222229375000044965744843750177635684380390625'
 1" = 0.0000000000000000000000000000002465190328815423611111468750000224828724218750088817836876001953125'
 1" = 0.000000000000000000000000000000123259516440771180555552343750001124143860937500444089184380390625'
 1" = 0.0000000000000000000000000000000616297582203855927777711718750000562071930468750222044592190390625'
 1" = 0.0000000000000000000000000000000308148791101927913888858937500002810359653437501110222960951953125'
 1" = 0.00000000000000000000000000000001540743955509639569444293750000140517982671875005551111476078125'
 1" = 0.00000000000000000000000000000000770371977754819782222146875000070258991368750027755557380390625'
 1" = 0.00000000000000000000000000000000385185988877409891111073437500003512949568750013877773687601953125'
 1" = 0.000000000000000000000000000000001925929944387049455555368750000175647478437500693888684380390625'
 1" = 0.0000000000000000000000000000000009629649721935247277771843750000878237392187500346944342190390625'
 1" = 0.000000000000000000000000000000000481482486096762363888892187500004391186960937501734721710951953125'
 1" = 0.000000000000000000000000000000000240741243048381181944445893750000219559348437500867360855476078125'
 1" = 0.000000000000000000000000000000000120370621524159590972222293750001097796742187500433680427380390625'
 1" = 0.00000000000000000000000000000000006018531076207979548611111468750000548898371368750216840213687601953125'
 1" = 0.00000000000000000000000000000000003009265538103989772777723437500002744491856875010842010855476078125'
 1" = 0.000000000000000000000000000000000015046327690519948868881171875000013722459284375005421005427380390625'
 1" = 0.000000000000000000000000000000000007523163845259974434444589375000068612296421875002710502713687601953125'
 1" = 0.000000000000000000000000000000000003761581922629987217222229375000034306148213687501355250136876009765625'
 1" = 0.0000000000000000000000000000000000018807909613149936086111114687500017153074109375006776250684380390625'
 1" = 0.0000000000000000000000000000000000009403954806574996804444293750000857653705468750033881250342190390625'
 1" = 0.00000000000000000000000000000000000047019774032874993402222146875000042882685273437501694060684380390625'
 1" = 0.00000000000000000000000000000000000023509887016437497211111073437500002144134263687500847030342190390625'
 1" = 0.00000000000000000000000000000000000011754943508218748605555536875000107206713168750042351501710951953125'
 1" = 0.0000000000000000000000000000000000000587747175410937243027777184375000053603356343750021175750684380390625'
 1" = 0.000000000000000000000000000000000000029387358770546861138888921875000026801678171875010587750342190390625'
 1" = 0.0000000000000000000000000000000000000146936793852734306944445893750001340083908937500529387501694060684380390625'
 1" = 0.0000000000000000000000000000000000000073468396926367153222222937500006700419546875002646937501347030342190390625'
 1" = 0.000000000000000000000000000000000000003673419846318357661111146875000033502097734375013235187501347030342190390625'
 1" = 0.00000000000000000000000000000000000000183670992315917883055555368750001675104886718750066175937501347030342190390625'
 1" = 0.000000000000000000000000000000000000000918354961579589417277771843750000837552443437500330879687501347030342190390625'
 1" = 0.0000000000000000000000000000000000000004591774807897947086888117187500004187762217187501654398437501347030342190390625'
 1" = 0.0000000000000000000000000000000000000002295887403948973543444458937500020938811089375008271992187501347030342190390625'
 1" = 0.0000000000000000000000000000000000000001147943701974486771722222937500010469405443750041359960937501347030342190390625'
 1" = 0.005739718509872433858611111468750000523470272187500206799804687501347030342190390625'
 1" = 0.00286985925493721692930555553687500026173513609375001033999023437501347030342190390625'
 1" = 0.00143492962746860846471727777184375000130867568046875005167995117187501347030342190390625'
 1" = 0.000717464813734304323858881171875000065433784023437500258399758937501347030342190390625'
 1" = 0.0003587324068671716119444458937500032716892011718750012919987937501347030342190390625'
 1" = 0.0001793662034335858059722222937500016358446005893750064599939687501347030342190390625'
 1" = 0.008968310171679290298611111468750000817922300293750032299969687501347030342190390625'
 1" = 0.00448415508583964514930555553687500040896115014687500161499848437501347030342190390625'
 1" = 0.00224207754291982257246888117187500020448057507343750080749972187501347030342190390625'
 1" = 0.00112103877145991136123444458937500010224028753687500403749860937501347030342190390625'
 1" = 0.000560519385729955660617277771843750005112014376875002018748304687501347030342190390625'
 1" = 0.0002802596928649778303086881171875000255600718843750010093741523437501347030342190390625'
 1" = 0.000140129846432488915015444445893750001278003594218750050468707617187501347030342190390625'
 1" = 0.007006