

NO. 100-100-100
 NO. 100-100-100
 NO. 100-100-100


THREE CADL...
 100' 100' 100'
 100' 100' 100'
 100' 100' 100'

GRADING...
 OF SOLID...
 100' 100' 100'

...
 100' 100' 100'

457+24 SB
 459+00 NB
 PROJECT 83-12
 END CONTRACT #1

PROJECT 83-17
 BEGIN CONTRACT #2

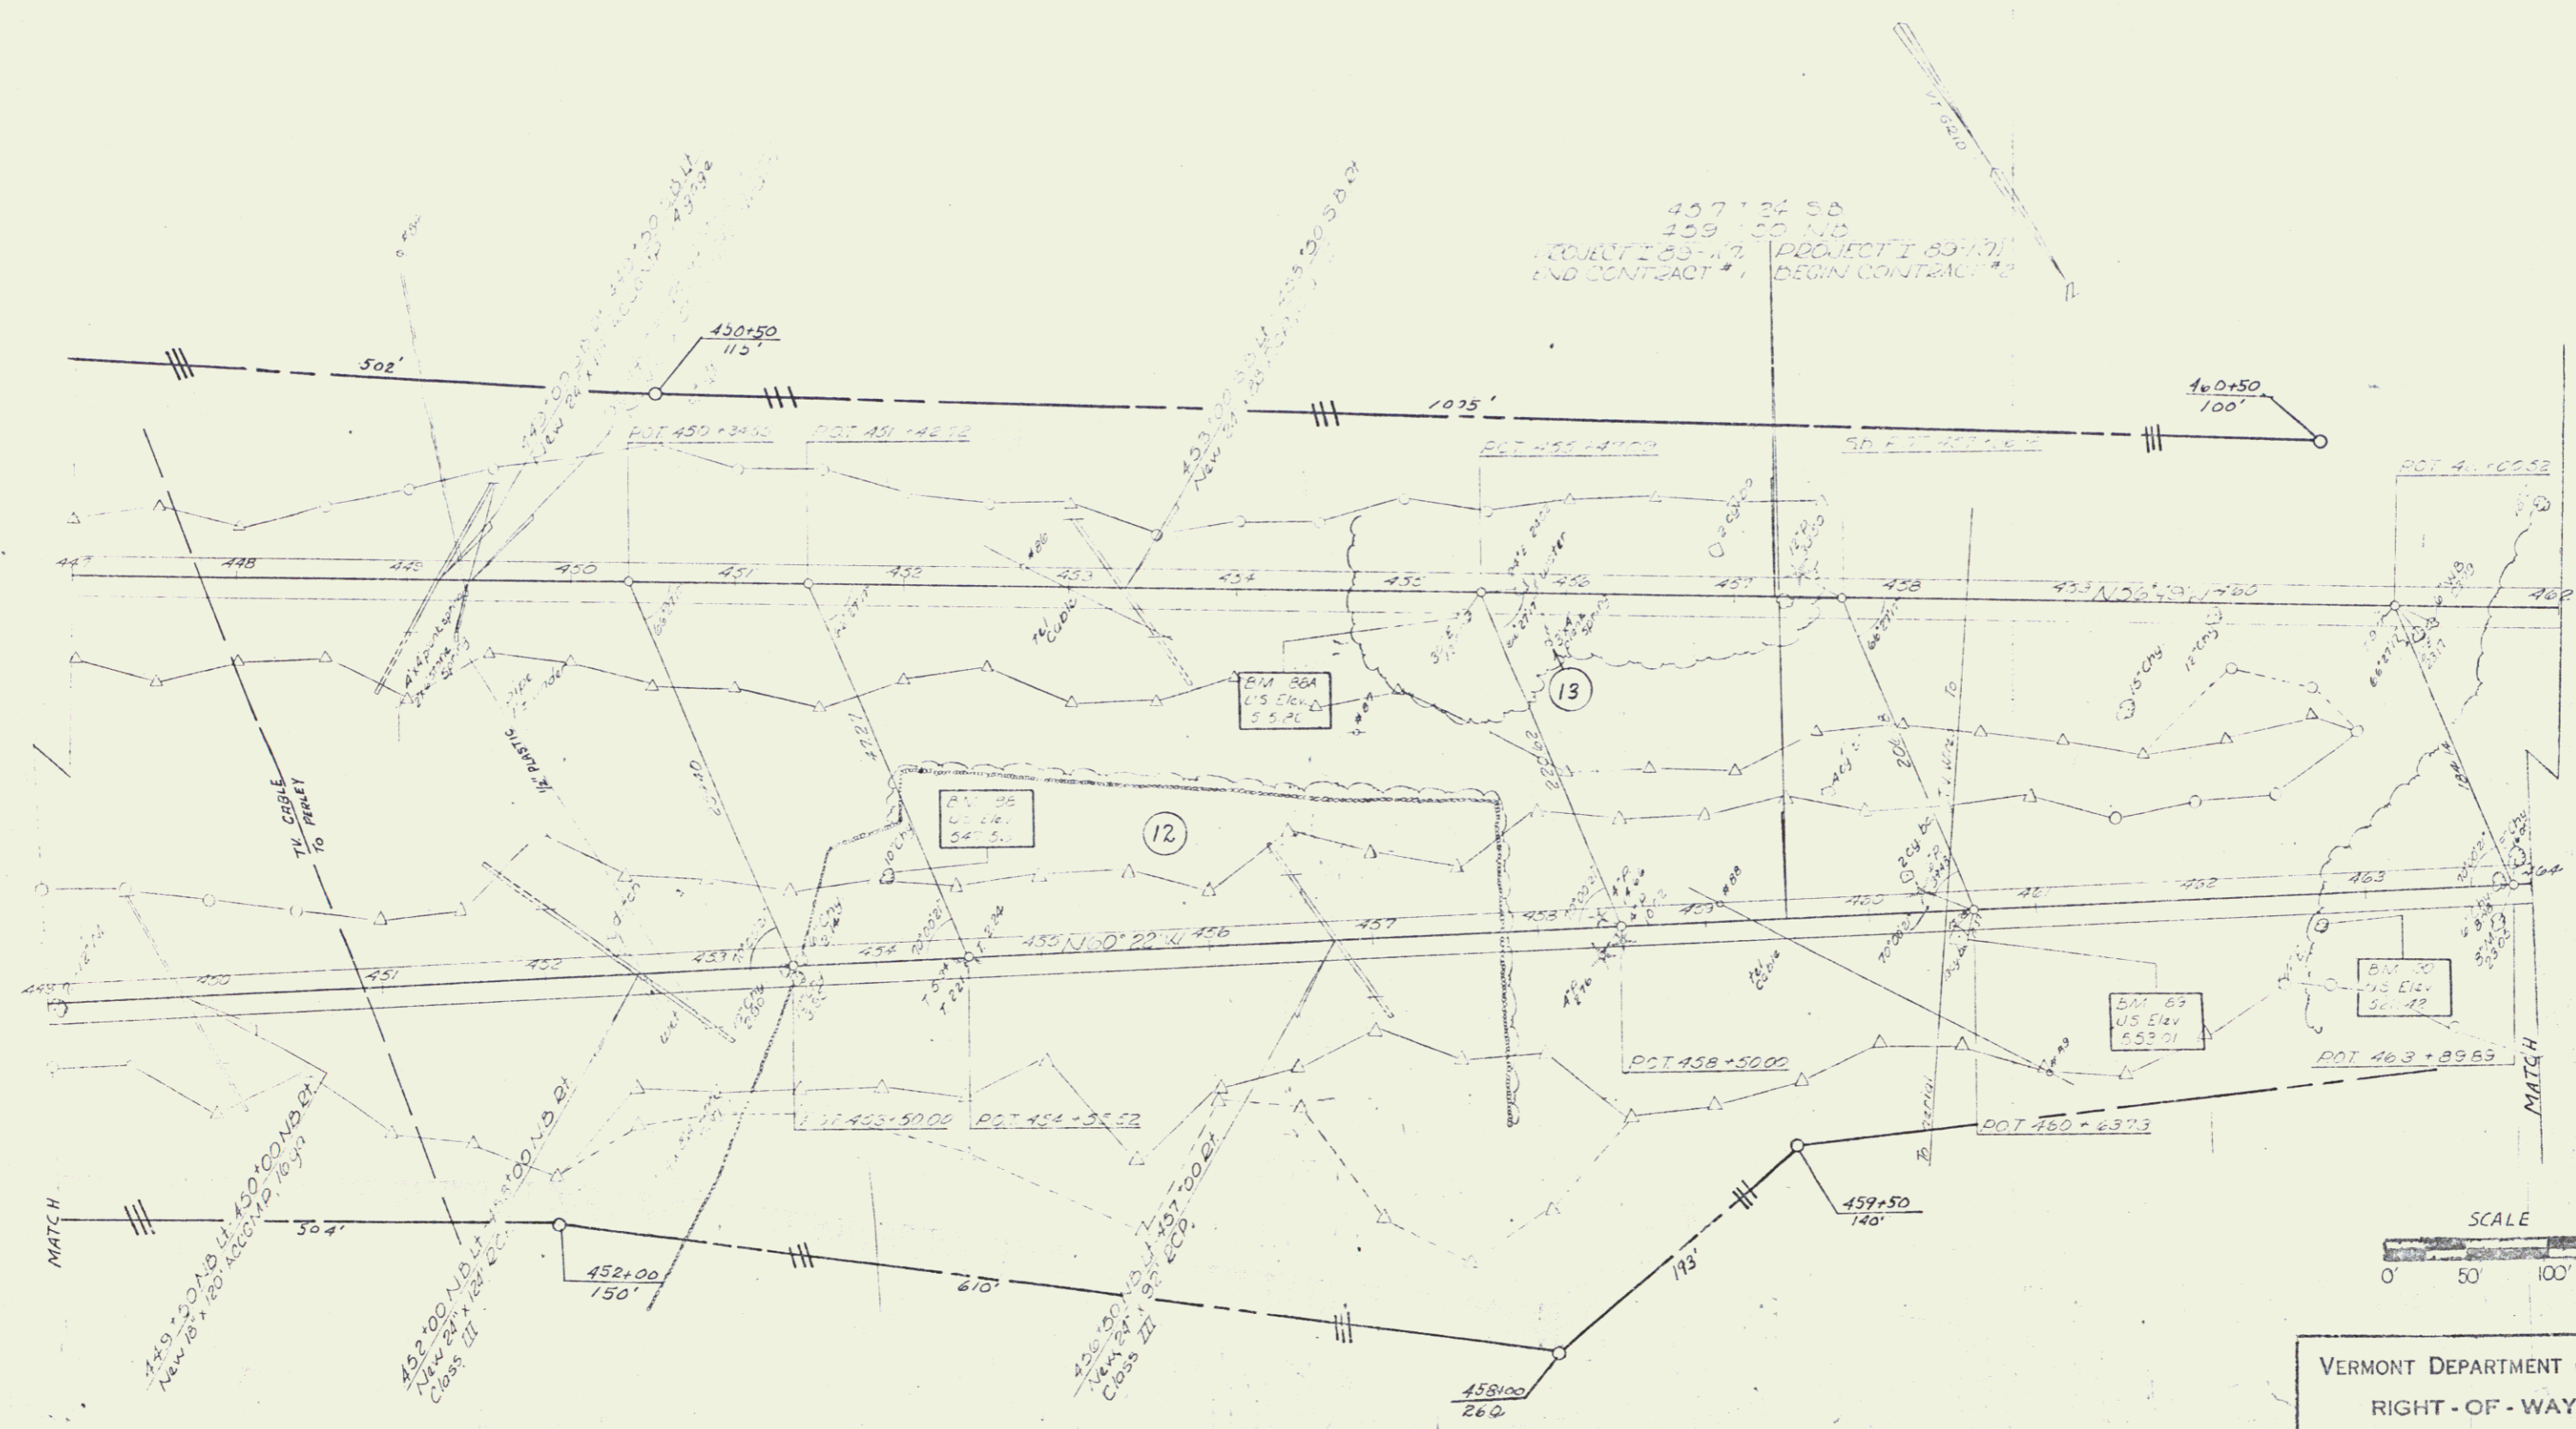

VERMONT DEPARTMENT OF HIGHWAYS
 RIGHT-OF-WAY PLANS
 PROJECT: HARTFORD - SHARON
 No. T-89-1 (16)
 SHEET 20 OF 23