


ACQUIRED FROM ORRIS H.
BUSHWAY BY COND. RECORDED
MAY 25, 1966 BOOK 29
PAGES 83-91

TOTAL ACREAGE = 16.5A±

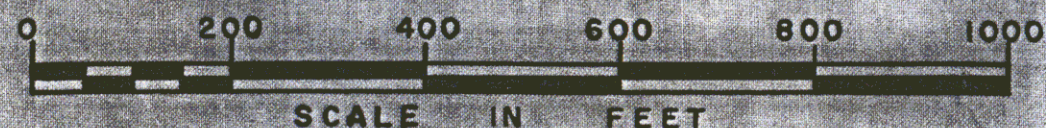

SP206A and 206B
Conveyed by QCD
to Richard Rhodes
12/11/74 and recorded
in Bk 31, Pg 301-312

RIGHT-OF-WAY DIVISION
TOWN FILE
PERPETUAL

Town of Sharon I 89
(To Be Returned To R.O.W. Division)

STATE OF VERMONT
DEPT. OF HIGHWAYS

TOWN OF SHARON **25B**

PROJECT HARTFORD-SHARON I-89-1(16)

APPROX. SCALE 1"=200' DATE 10/8/74 DRAWN BY JEH

