


RIGHT-OF-WAY DIVISION
 TOWN FILE
 PERPETUAL
 Town of _____
 (To Be Returned To R.O.W. Division)

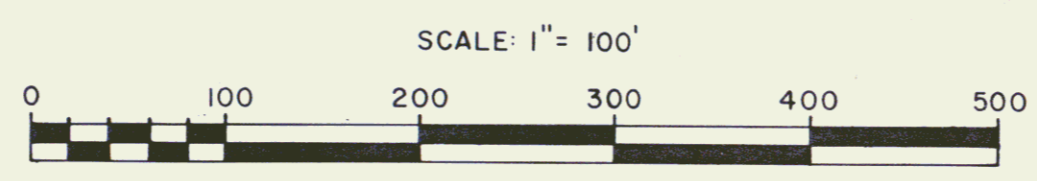

HARTFORD-SHARON I 89-1 (16)
 REF. SHEETS 25 & 26 OF 73

STATE OF VERMONT
AGENCY OF TRANSPORTATION

TOWN OF SHARON **25C**

PROJECT **I 89-1 (16)**

APPROX SCALE 1"=100'	DATE 12/21/79	DRAWN BY B.A.M.
----------------------	---------------	-----------------

77 101