


THREE CABLE GUARD RAIL
w/ STEEL POSTS, ITEM 542
NB 527+00 LT - 528+53 LT
NB 531+00 LT - 543+00 LT
NB 527+00 RT - 527+46 RT

BITUMINOUS CONCRETE CURB
ITEM 555, TYPE II
NB 531+00 - 543+00 LT

NOT TO SCALE
 PLAN VIEW ONLY
 NO. 1000
 DATE 1/27/88

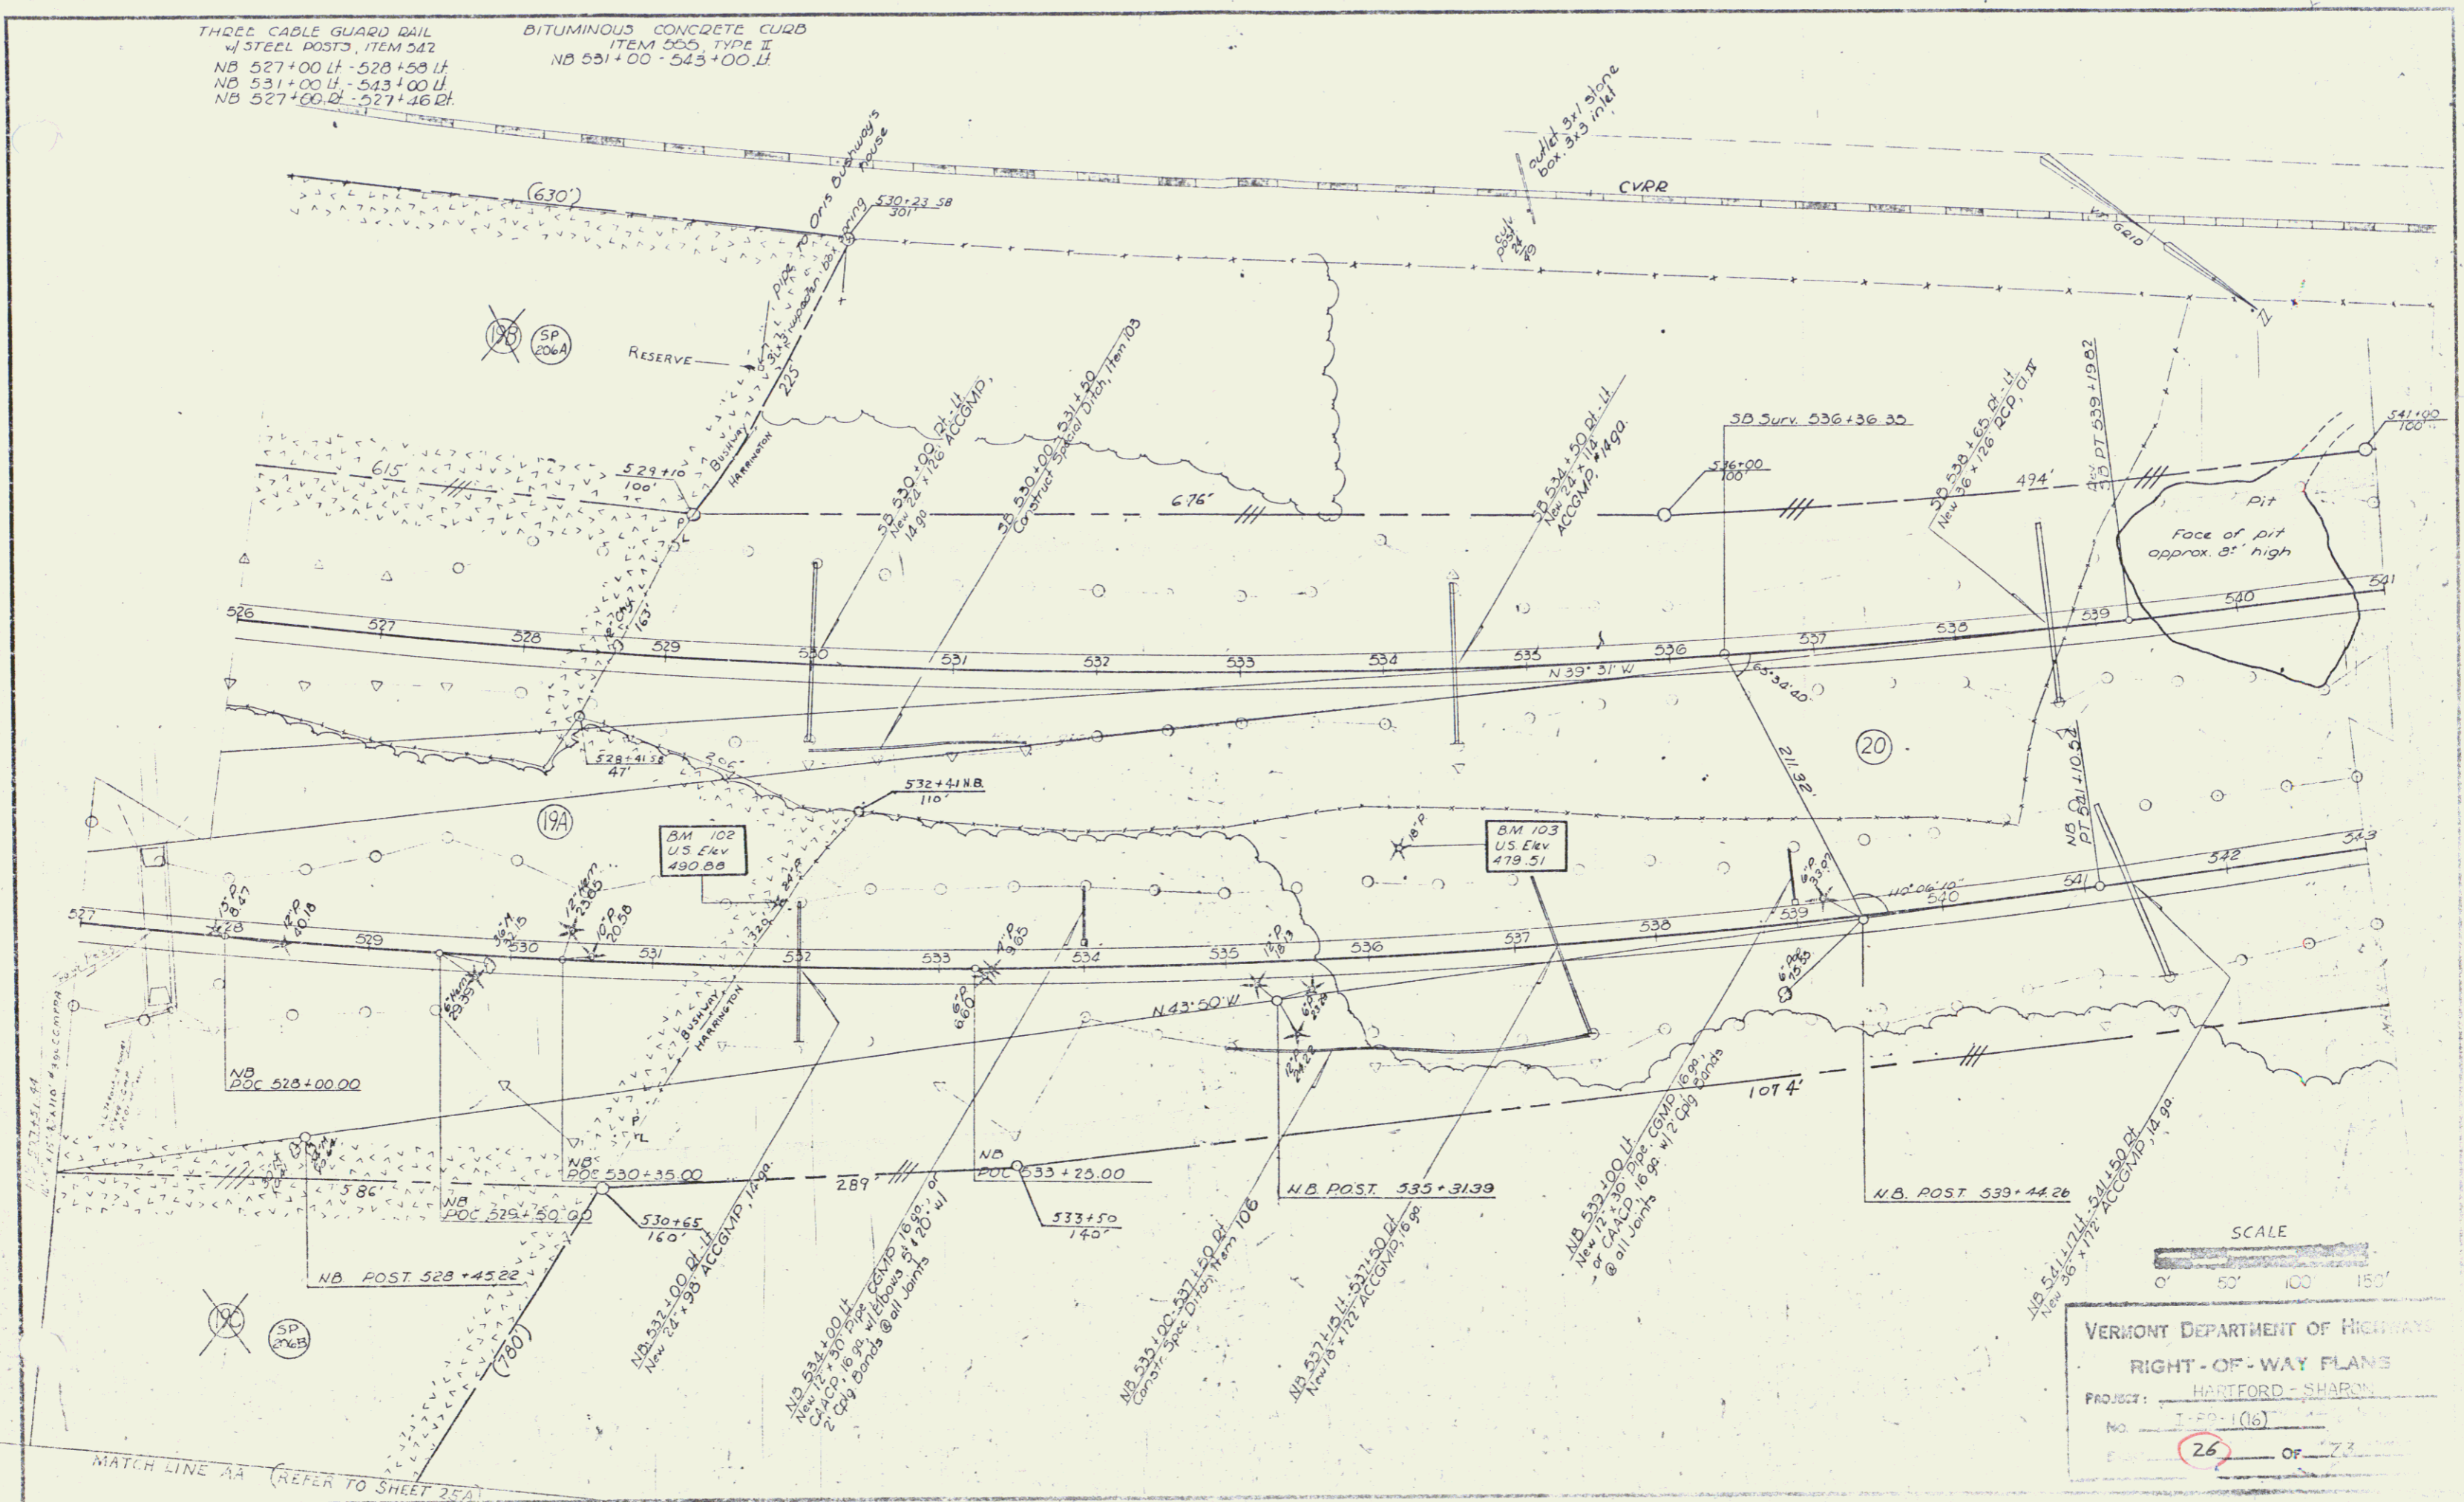

MATCH LINE AA (REFER TO SHEET 25A)