

* SODDING
Item 612
SB 393+00 - 403+00 LF
SB 394+00 - 403+00 LF
SB 395+00 - 403+00 LF

* THREE CABLE GUARD RAIL w/ LIGHT STEEL FCSTS
Item 538
SB 392+00 - 404+00 LF
NB 392+00 - 403+50 LF

* BITUMINOUS CONCRETE CURB
TYPE II - Item 550
398+46 - 404+50 SB LF


PROPERTY LINE FENCE, ITEM 563-II mod
391+00 - 403+50 NB LF
391+00 - 404+00 SB LF

DRILLING AND BLASTING
OF SOLID ROCK SUBGRADE
ITEM 115
NB 395+00 - 403+50
SB 399+50 - 403+00 LF

STATION	LOCATION	OFFSET	DESCRIPTION
394+35.58	LT.	250'	Reinf. Conc. Pipe
395+00.58	LT.	500'	Drilled Well
396+50.58	LT.	50'	Vit. Clay Pipe
398+50.58	LT.	375'	Stone Box
399+00.58	LT.	330'	Conc. Box
399+50.58	LT.	400'	Stone Box
399+55.58	LT.	400'	Wood Box
401+00.58	LT.	430'	Vit. Clay Pipe
402+50.58	LT.	900'	Drilled Well
403+15.58	LT.	520'	Vit. Clay Pipe
403+50.58	LT.	513'	Vit. Clay Pipe
403+80.58	LT.	540'	Stone Box

* DENOTES STAGE 2 ITEMS

TREATED TIMBER PILE, ITEM 554
S.D. 398+46 - 404+50 LF
NB 398+46 - 404+50 LF

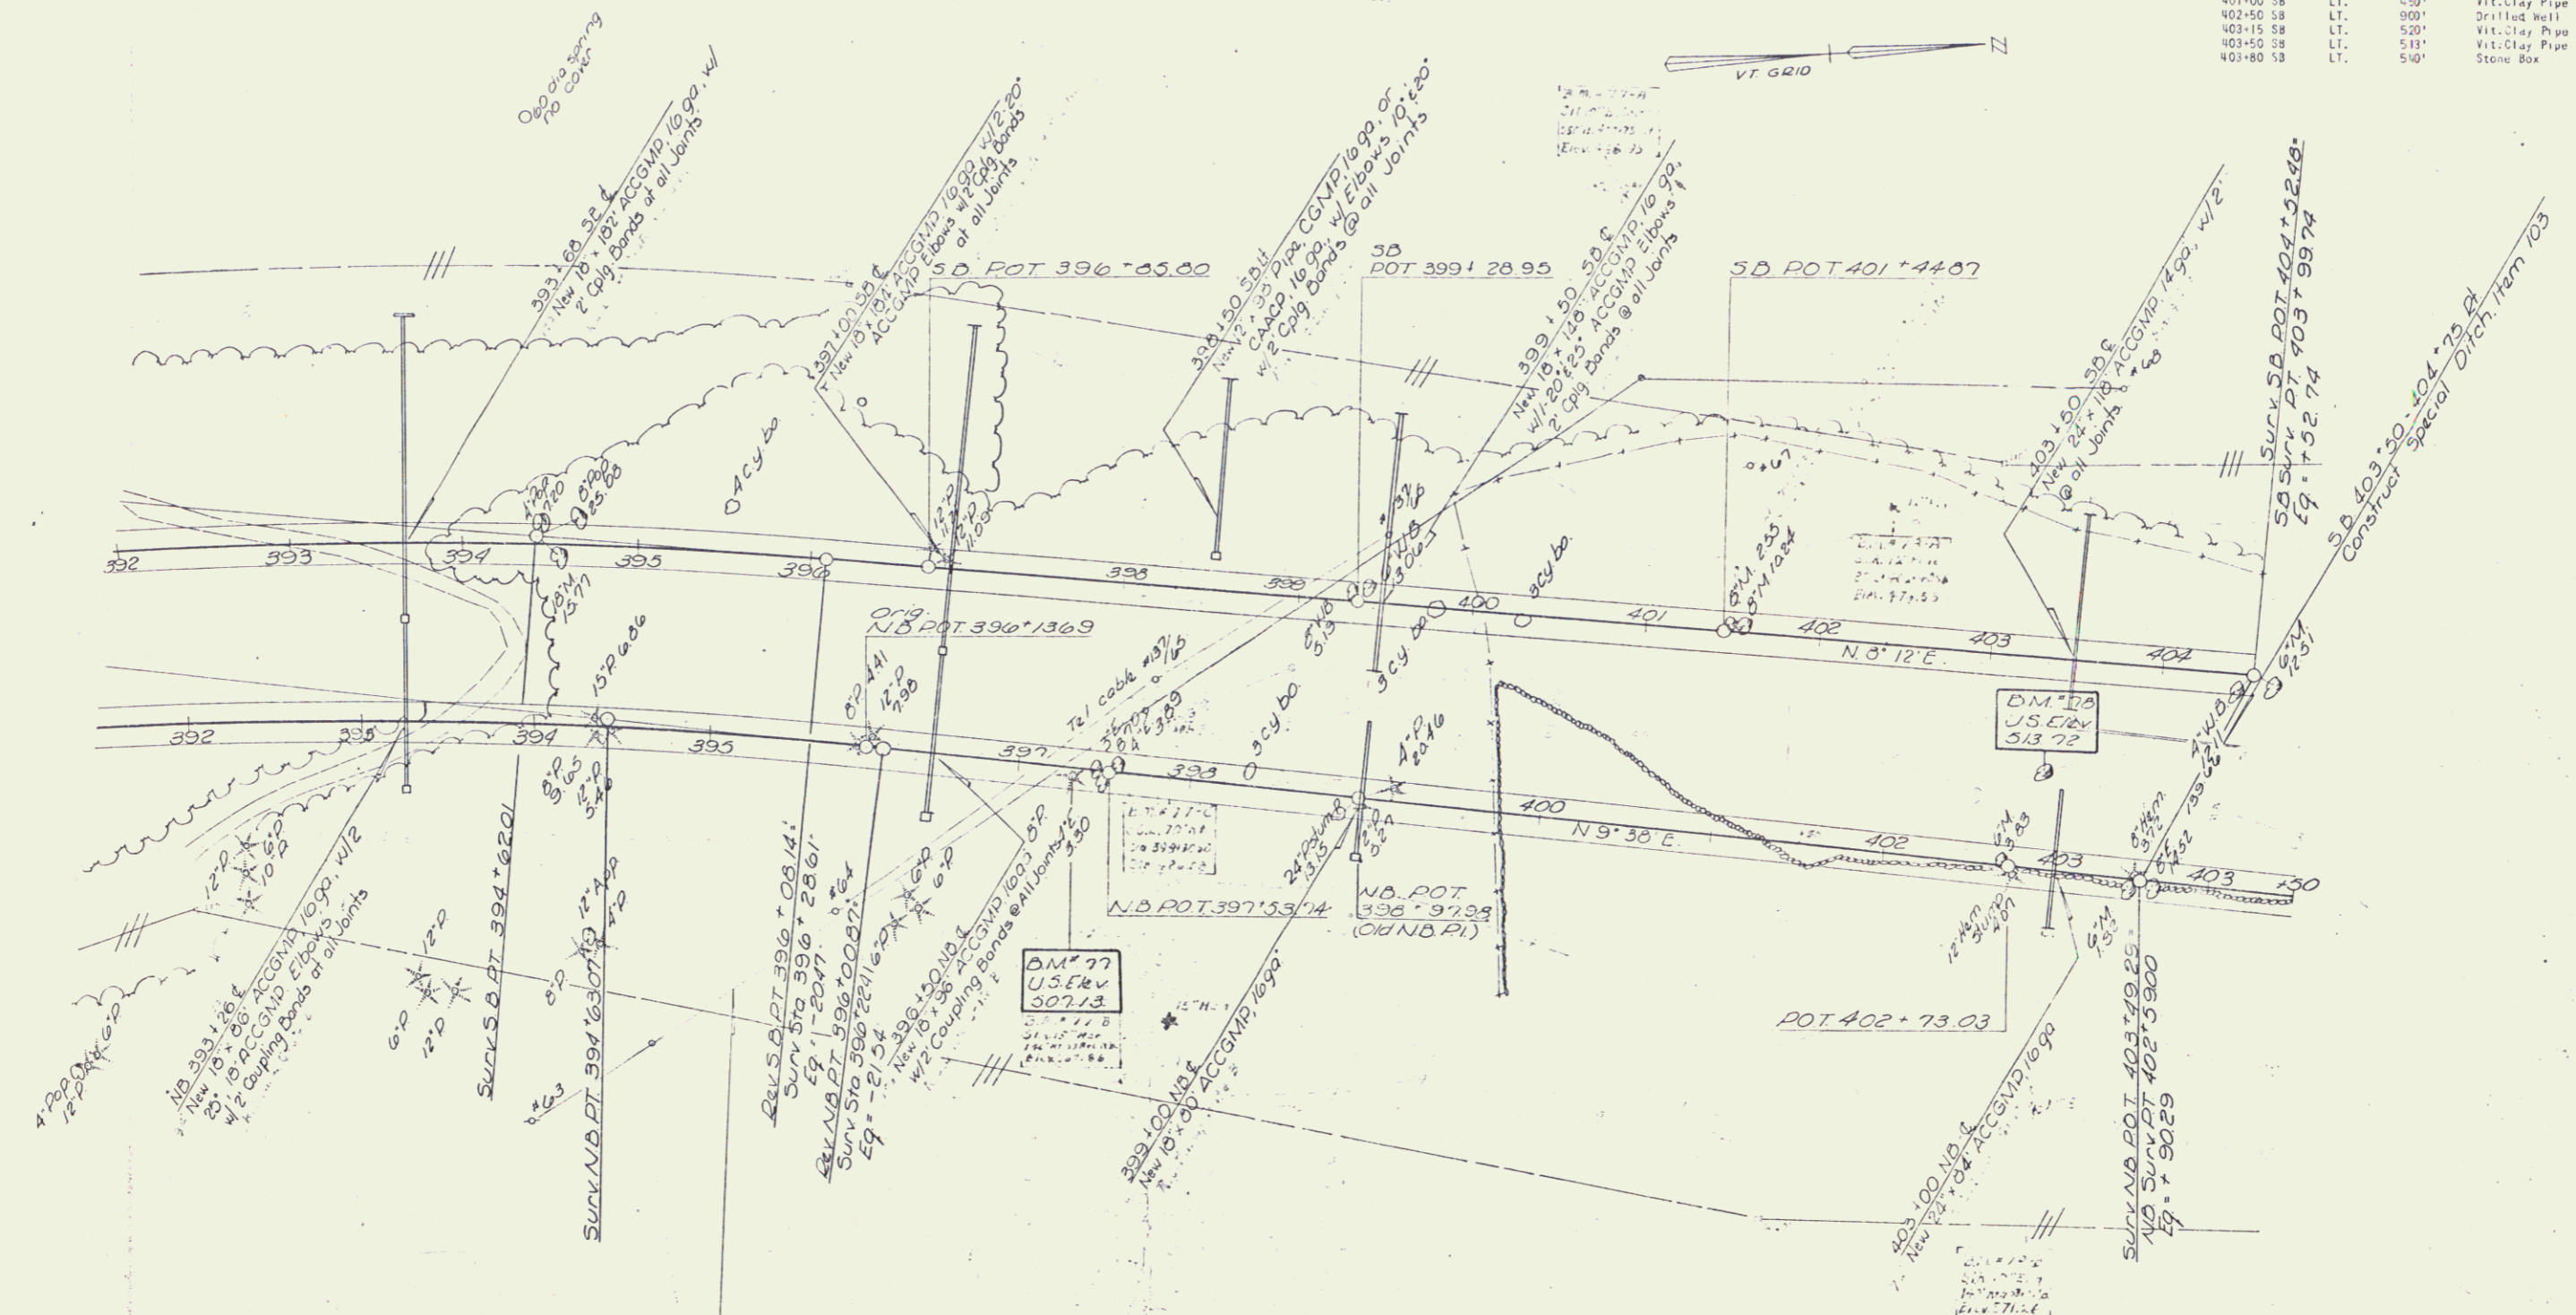

DEC 20 1973

Sign II Construction

SURVEYED BY *Jewell* DATE *10/62*
DRAWN BY *Reichelt* DATE *10/62*
TRACED BY *L. Clark* DATE *11/62*
HARTFORD-SHAERON
PROJ. NO. *89-1*
SHEET *25* OF *25*

CONTROL OF ACCESS IS COMPLETE ON THIS SHEET