


PLAN SHEET
 NOTE BOOK NUMBER CONTROLLED
 NO. OF MAP SHEETS
 SHEET NO.
 DATE
 L. CLARK

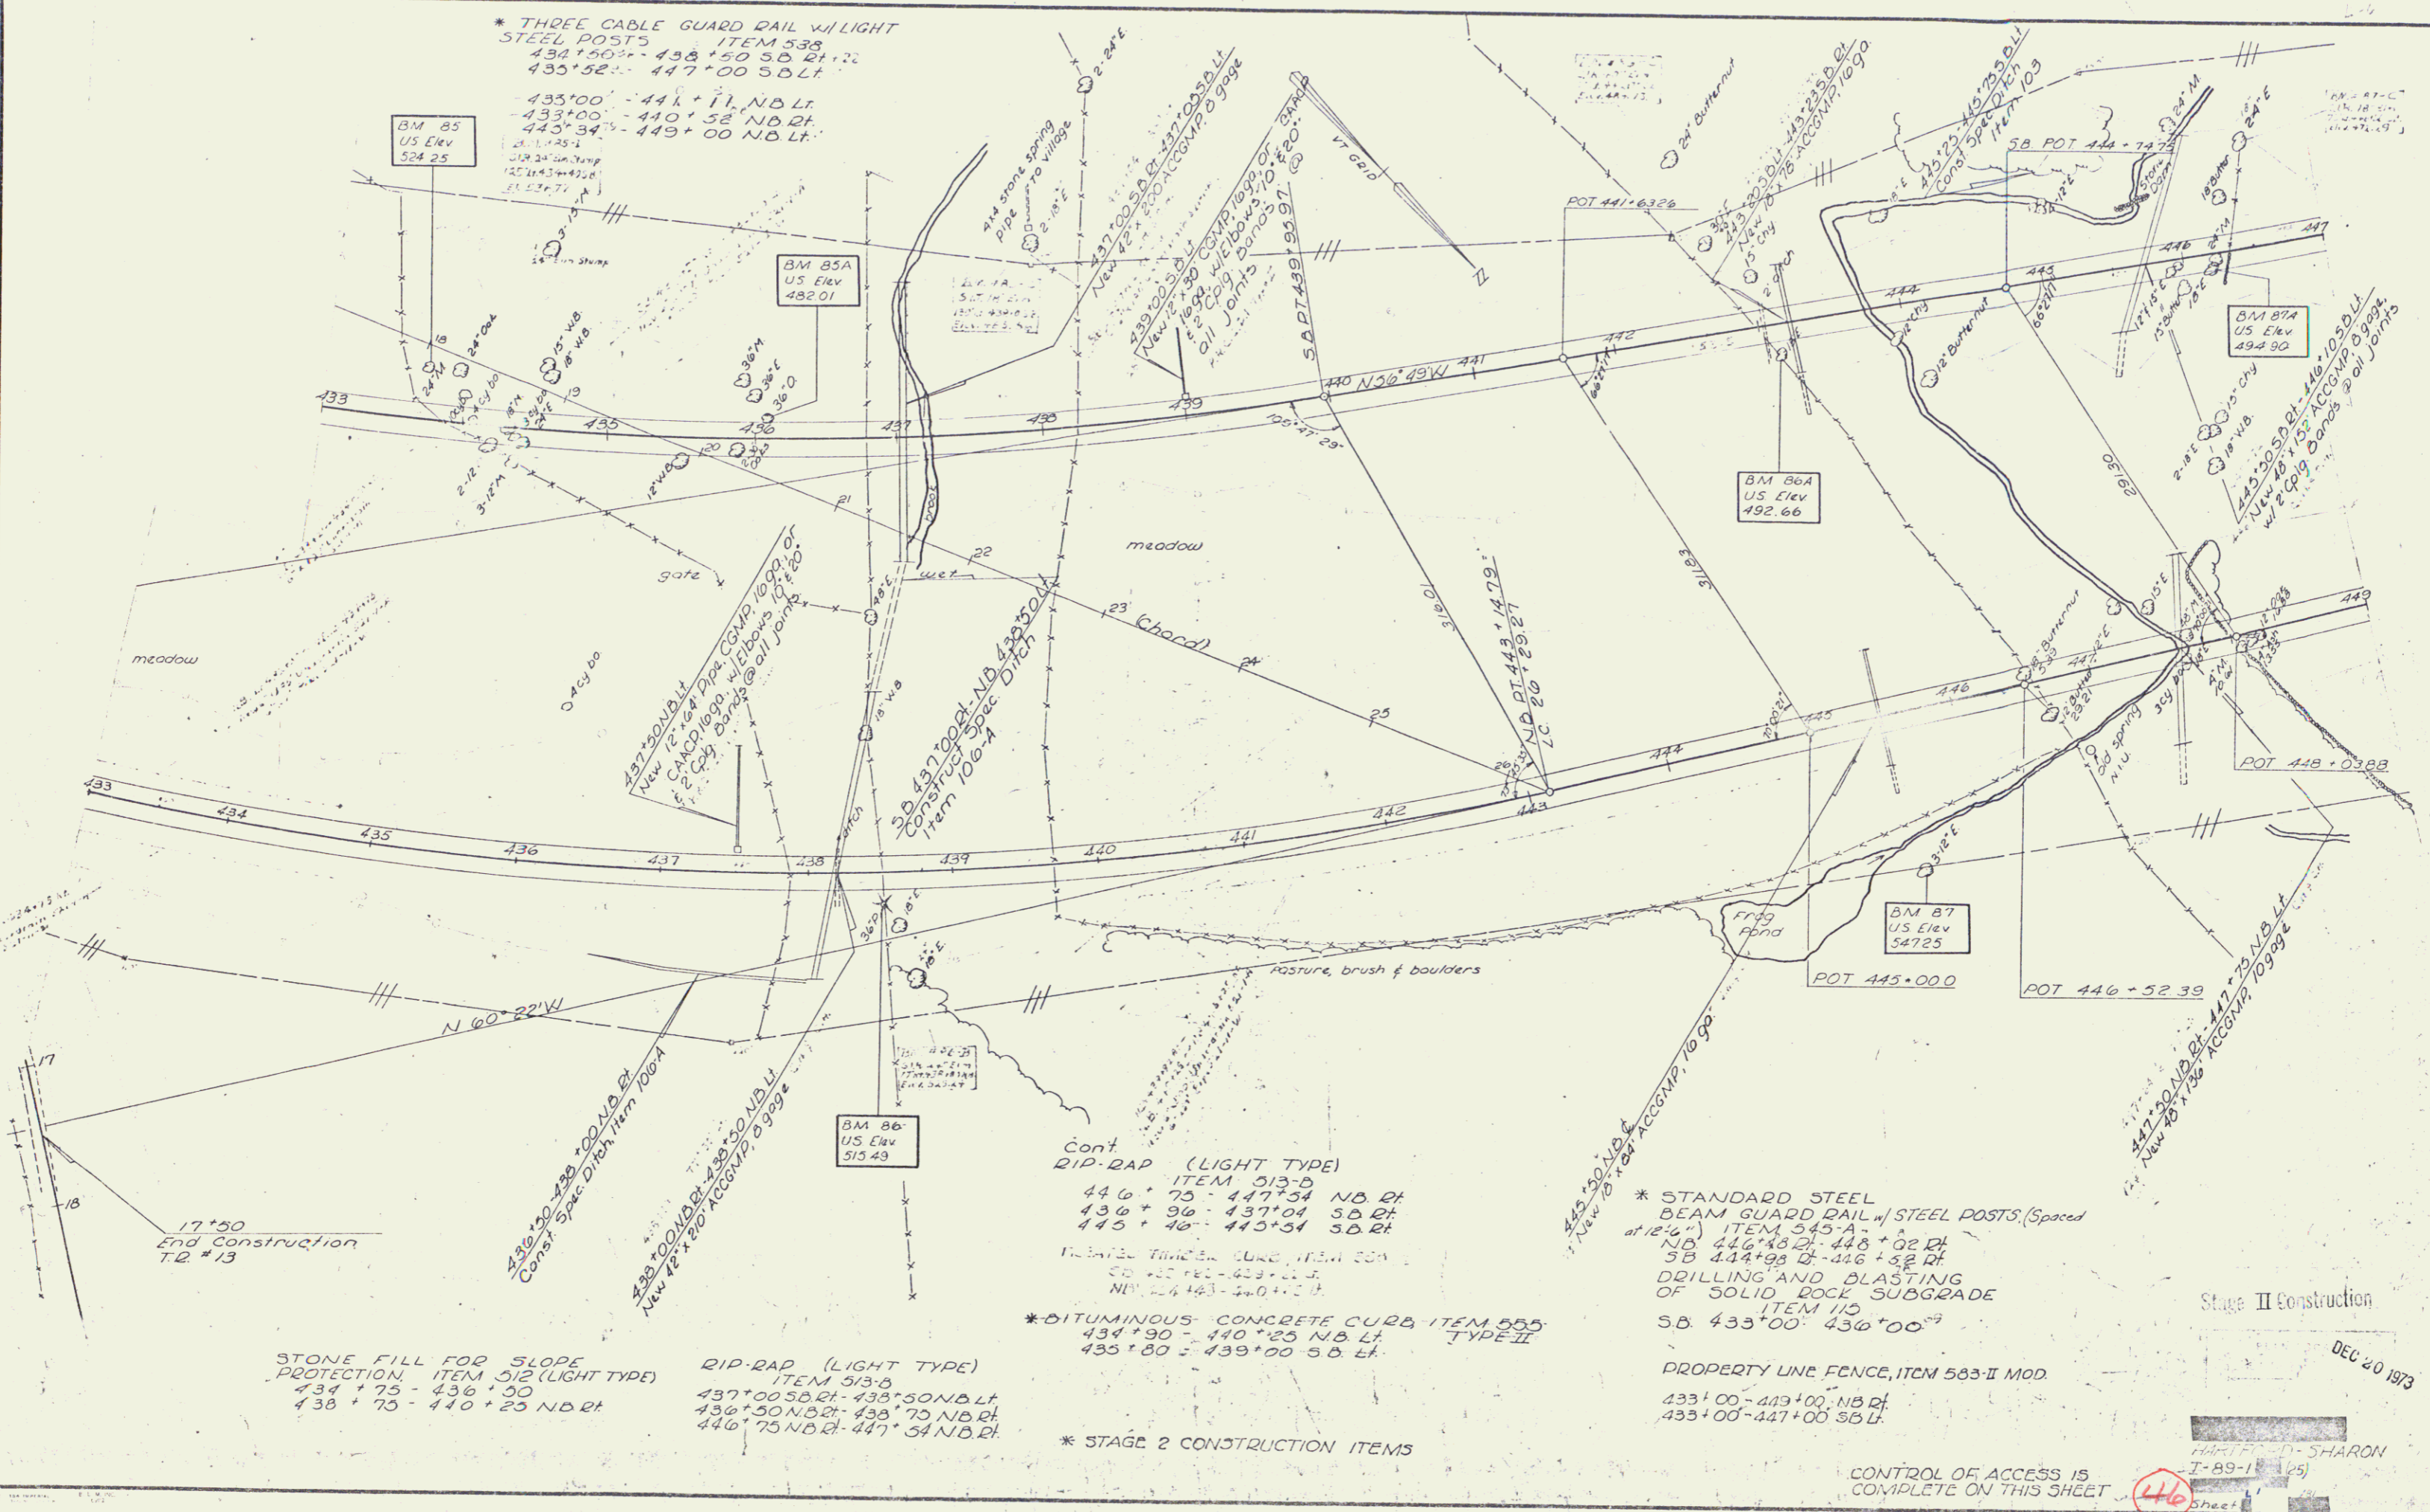

* THREE CABLE GUARD RAIL w/LIGHT STEEL POSTS ITEM 533
 434+50 - 438+50 SB 21.72
 435+52 - 447+00 S.D.Lt.

BM 85
 US Elev
 524.25

BM 85A
 US Elev
 482.01

BM 86A
 US Elev
 492.66

BM 87A
 US Elev
 494.90

BM 86
 US Elev
 515.49

BM 87
 US Elev
 547.25

Cont RIP-RAP (LIGHT TYPE) ITEM 513-D
 446+75 - 447+54 NB Rt
 436+90 - 437+04 SB Rt
 445+40 - 445+54 S.D.Rt
 1/2" x 3/4" CURB ITEM 504
 SB 435+80 - 438+25 Lt
 NB 444+63 - 447+25 Lt

* BITUMINOUS CONCRETE CURB ITEM 505 TYPE II
 434+90 - 440+25 NB Lt
 435+80 - 439+00 SB Lt

* STANDARD STEEL BEAM GUARD RAIL w/ STEEL POSTS (Spaced at 12' 6") ITEM 545-A
 NB 446+40 - 448+02 Rt
 SB 444+90 - 446+32 Rt
 DRILLING AND BLASTING OF SOLID ROCK SUBGRADE ITEM 110
 SB 433+00 - 436+00

PROPERTY LINE FENCE, ITEM 583-II MOD
 433+00 - 443+00 NB Rt
 433+00 - 447+00 SB Lt

STONE FILL FOR SLOPE PROTECTION, ITEM 512 (LIGHT TYPE)
 434+75 - 436+50
 438+75 - 440+25 NB Rt

RIP-RAP (LIGHT TYPE) ITEM 513-B
 437+00 SB Rt - 438+50 NB Lt
 436+50 NB Rt - 438+75 NB Rt
 446+75 NB Rt - 447+54 NB Rt

* STAGE 2 CONSTRUCTION ITEMS

Stage II Construction

DEC 20 1973

CONTROL OF ACCESS IS COMPLETE ON THIS SHEET

46

54