


PLAN  
 DATE  
 DRAWN BY  
 CHECKED BY  
 SCALE  
 SHEET NO.

\*THREE CABLE GUARD w/LIGHT STEEL  
 POSTS ITEM 512  
 SB 447+00 - 458+00 Lt + r  
 NB 449+00 - 450+94 Lt  
 PROPERTY LINE FENCE, ITEM 503-II Mod  
 449+00 - 459+00 NB Dt.  
 447+00 - 457+24 SB Lt.

DRILLING & BLASTING  
 OF SOLID ROCK SUBGRADE  
 ITEM 115  
 NB 451+50 - 458+50  
 S B 453+00 - 457+50

| STATION   | LOCATION | OFFSET | DESCRIPTION |
|-----------|----------|--------|-------------|
| 437+00 SB | LT.      | 145'   | Stony Box   |
| 449+35 SB | KT.      | 81'    | Plank Box   |
| 453+10 NB | RT.      | 85'    | Plank Box   |
| 455+75 SB | WT.      | 32'    | Plank Box   |

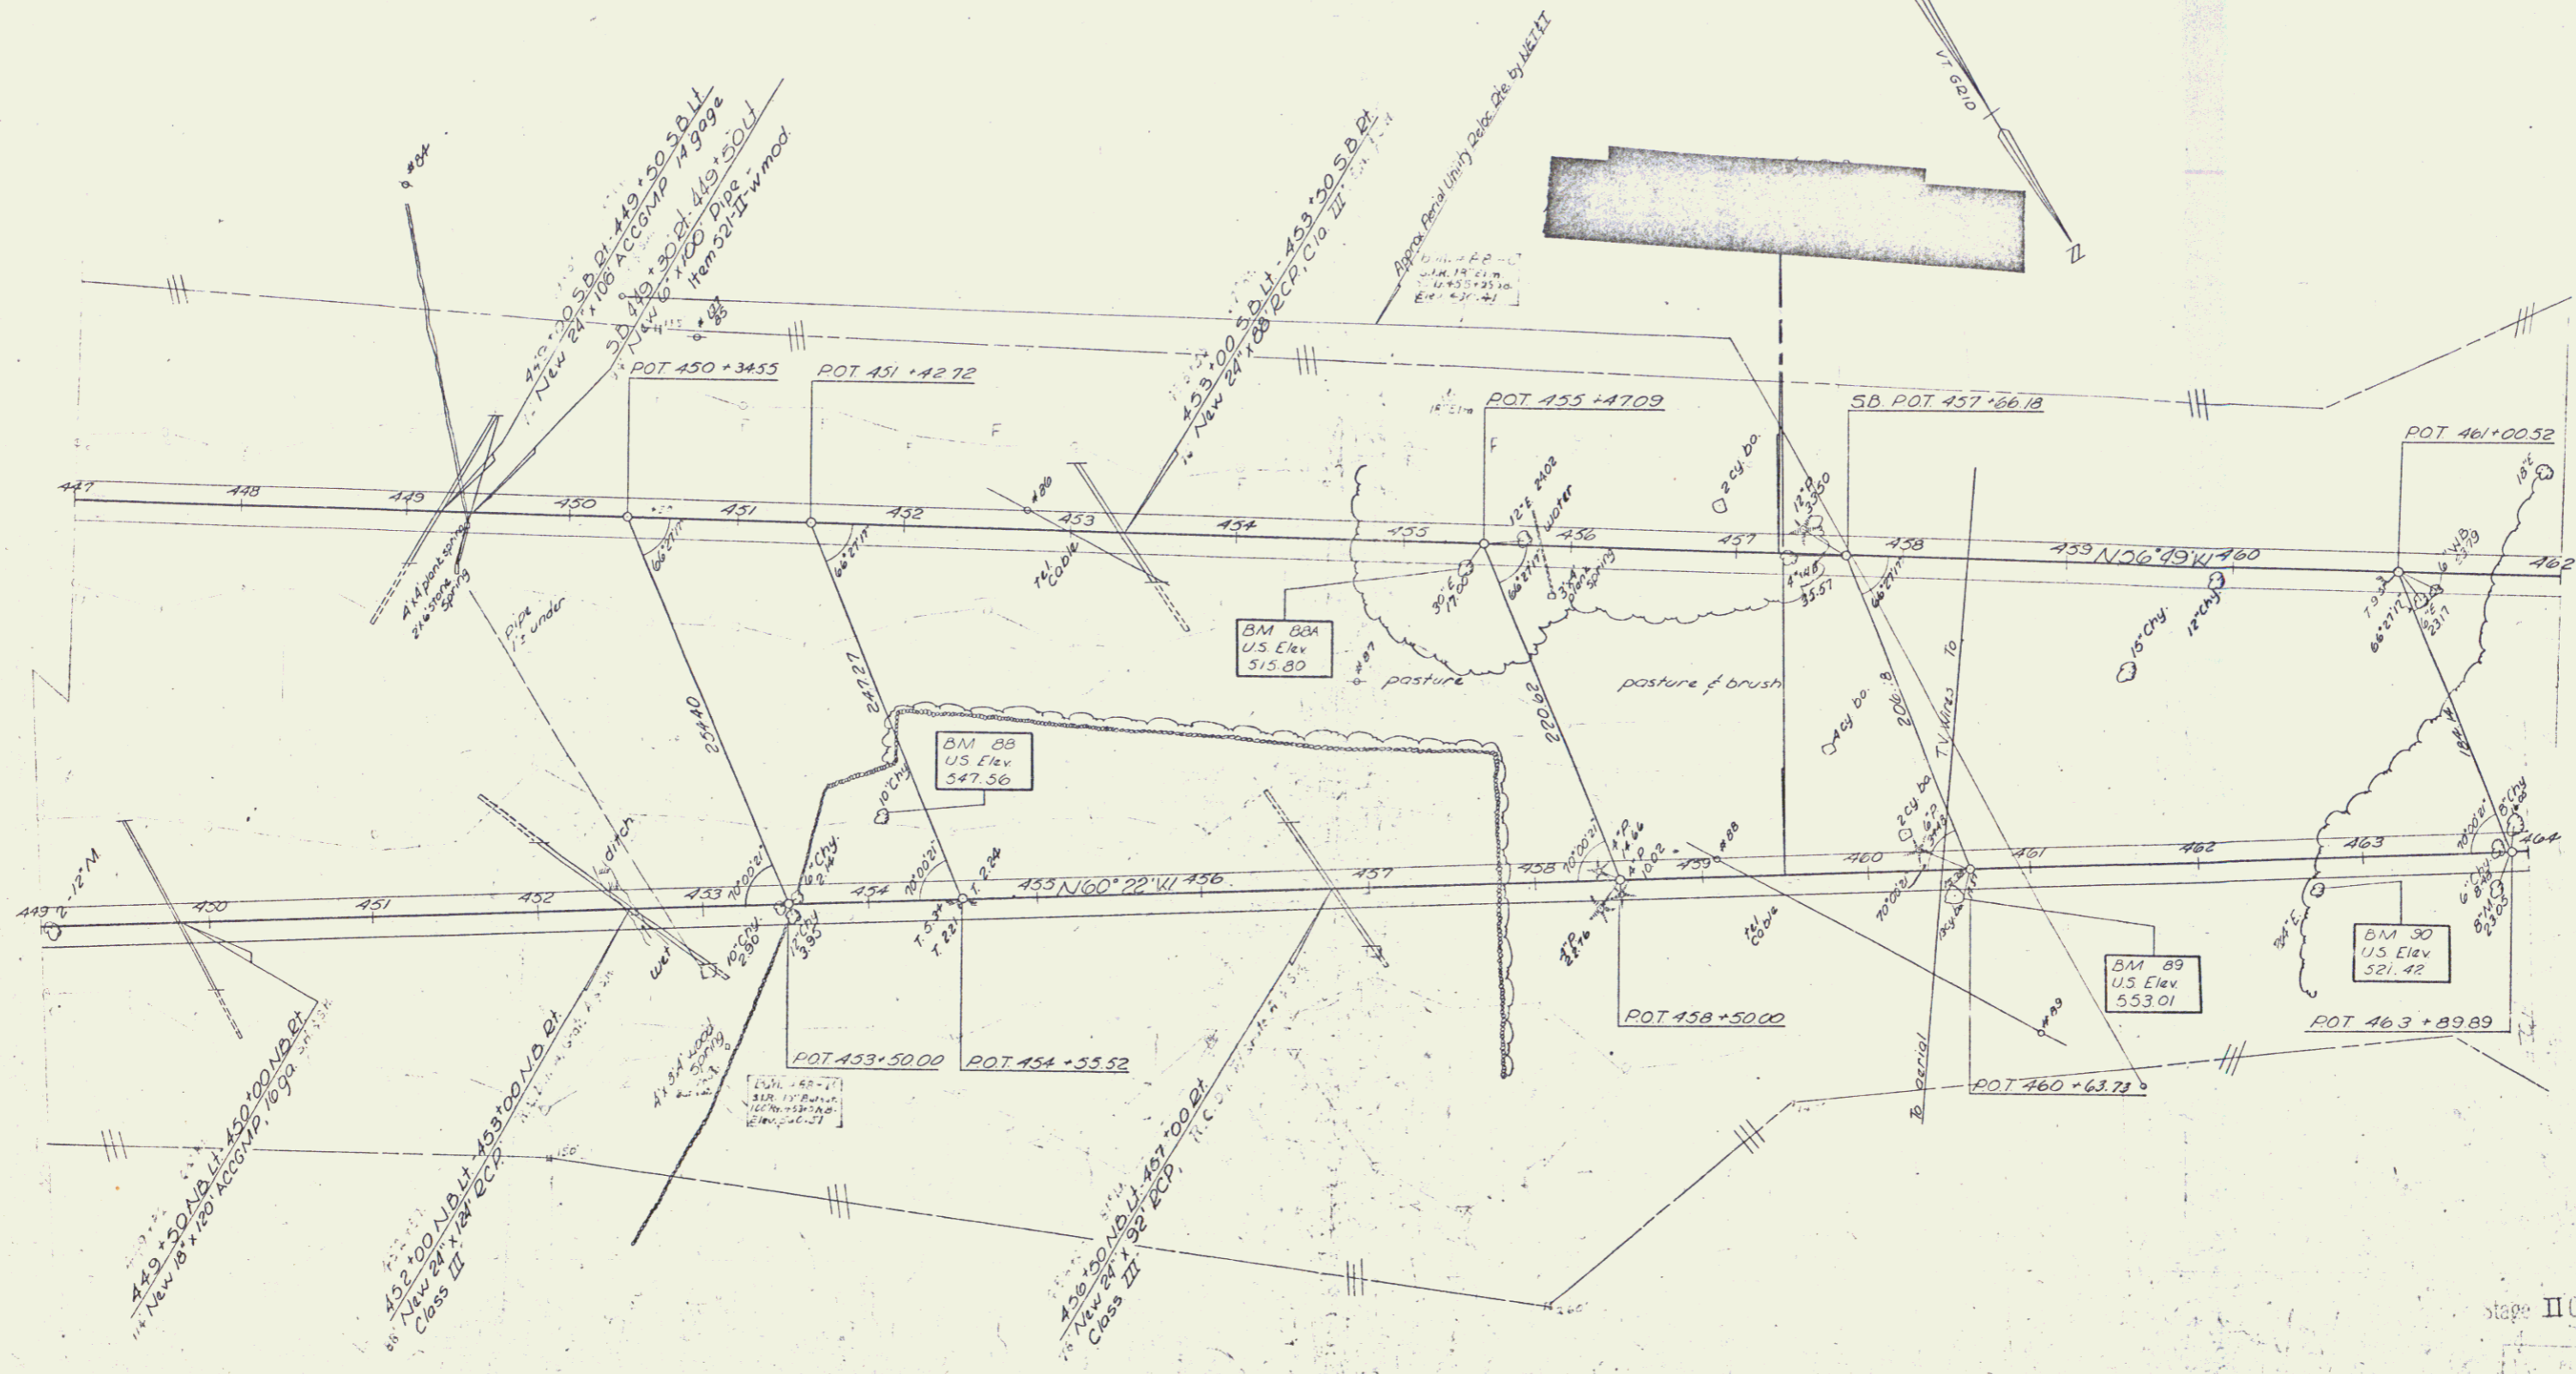

stage II Construction  
 DEC 20 1973

CONTROL OF ACCESS IS  
 COMPLETE ON THIS SHEET

HARTFORD-SHARON  
 I-89-100  
 Sheet 5