

PROPERTY LINE FENCE ITEM 663 IM 0' THREE CABLE GUARD RAIL / LIGHT STEEL POSTS ITEM 538
 SB 541+00 - 557+00 Lt.
 NB 543+00 - 559+00 Rt.
 TREATED TIMBER PILE ITEM 551
 SB 541+00 - 557+00 Lt.
 * DENOTES STAGE 2 ITEMS


DRILLING & BLASTING OF SOLID ROCK SUBGRADE ITEM 115
 NB 546+75 - 558+00

JUTE MATTING ITEM 623
 SB 543+75 Rt - 549+75 Rt.

STATION	LOCATION	OFFSET	DESCRIPTION
553+50 NB	LT.	60'	Stage Box

RIPRAP (LIGHT TYPE) ITEM 513-D
 NB 550+50 - 556+60 Rt.
 SB 548+45 - 548+75 Rt.

37015 PILE PILE CLOVE & NOTE, TYPED
 (SEE AT 714 E)
 N.B. RT. 550+00 - 557+00 Lt.

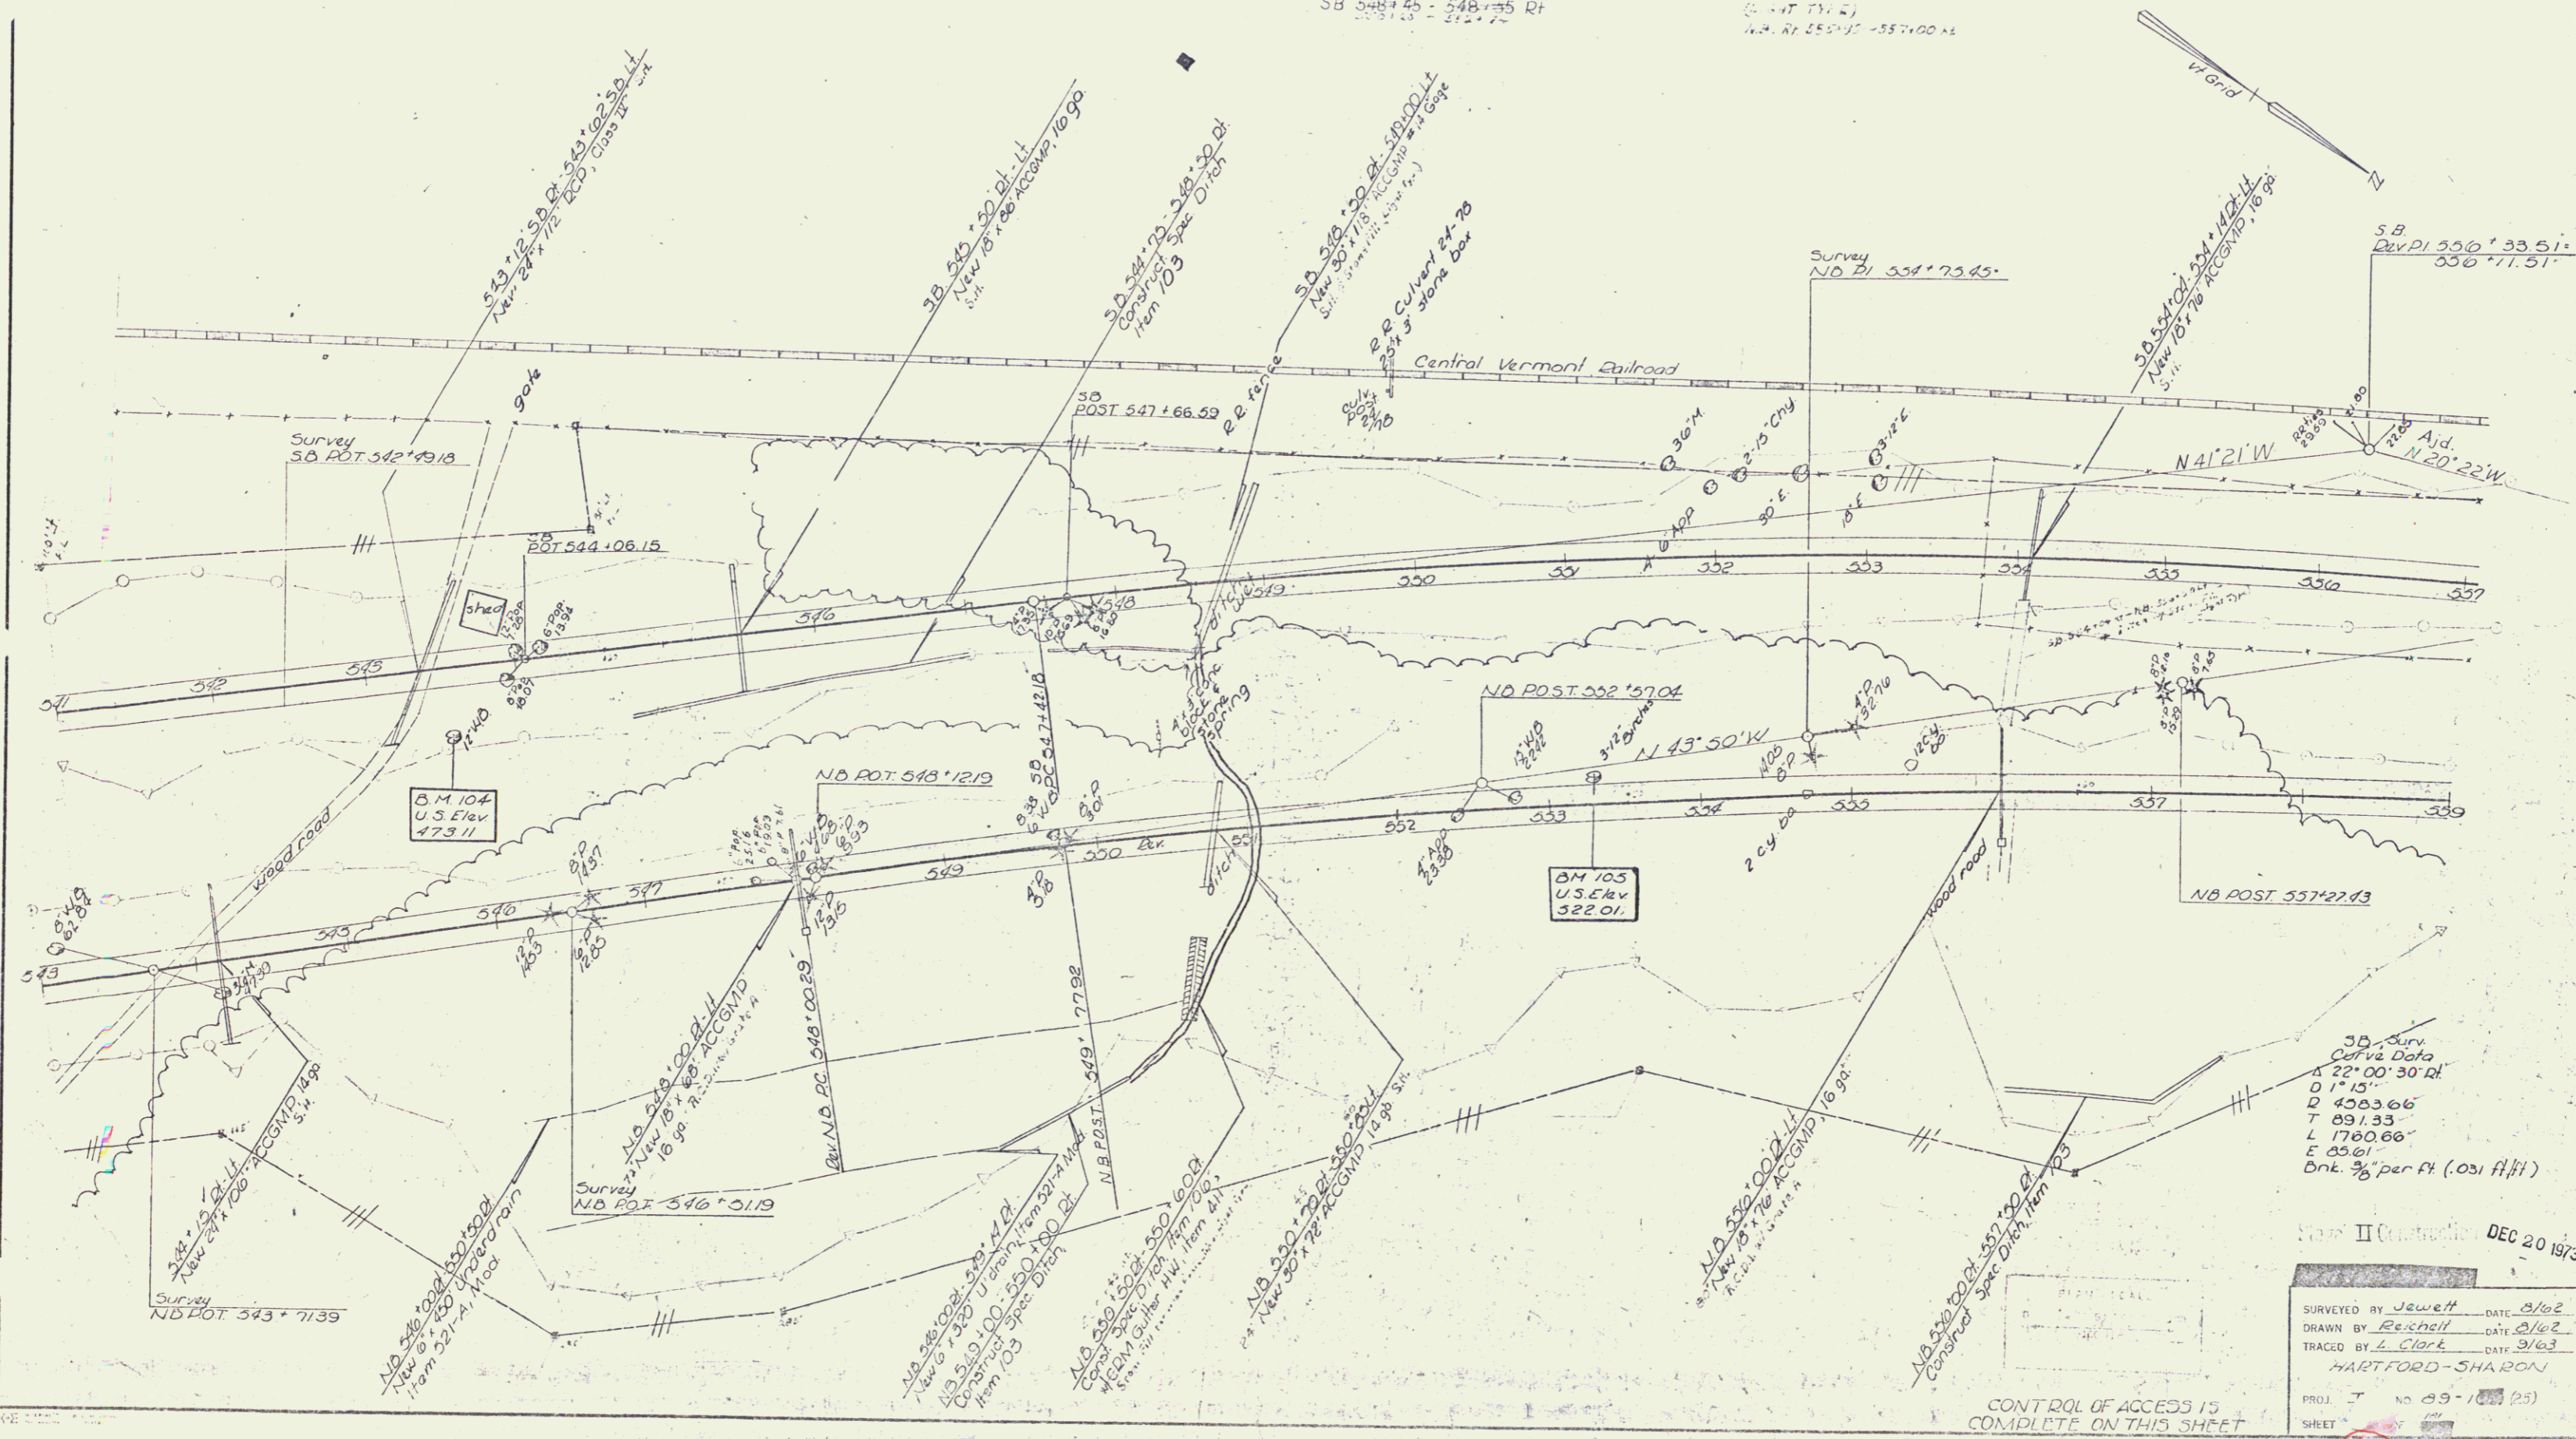

SB Surv Curve Data
 A 22° 00' 30" Rt
 D 11.15'
 T 40.0366'
 L 1760.66'
 E 55.61'
 Dkt. 3/8" per ft. (0.031 ft/ft)

DEC 20 1973
 SURVEYED BY Jewett DATE 8/62
 DRAWN BY Reschell DATE 8/62
 TRACED BY L. Clark DATE 9/63
 HARTFORD-SHARON
 PROJ. T. NO. 89-12 (25)
 SHEET 60

CONTROL OF ACCESS IS COMPLETE ON THIS SHEET