

* THREE CABLE GUARD RAIL / LIGHT STEEL POSTS, ITEM 538
 NB 591+00-594+00 Lt.
 NB 599+25-607+00 Lt.
 NB 602+00-606+40 Lt.
 SB 591+00-607+00 Lt.

* BITUMINOUS CONCRETE CURB ITEM 555, TYPE II
 NB 602+50-606+02 Rt.
 SB 591+00-594+20 Lt.
 PROPERTY LINE FENCE, ITEM 583-II MOD
 SB 591+00-607+00 Lt.
 NB 591+00-592+00 Rt.
 NB 605+00-607+00 Rt.

DRILLING & PRESPLITTING OF SOLID ROCK, ITEM 125
 SB 593+75-598+75-
 NB 594+24-594+28
 SB 594+02-594+32

DRILLING & BLASTING OF SOLID ROCK SUBGRADE, ITEM 115
 NB 593+60-600+10
 SB 593+75-600+25
 SB 605+25-607+10


JUTE MATTING, ITEM 625
 Med 591+00-593+12
 Med 603+15-607+25

STONE FILL FOR SLOPE PROTECTION, ITEM 512
 SB 594+02 Lt.
 SB 603+50-604+50 Lt.
 NB 602+00-604+50 Rt.
 NB 604+50-606+50 Rt.

* SODDING - Item 612
 SB 593+50 Lt Rt
 NB 596+10 Rt
 SB 596+10 Rt
 NB 598+53 Rt
 SB 598+53 Rt
 NB 601+00 Lt Rt
 Med 603+40
 Med 606+40

* STAGE II CONSTRUCTION

STATION	LOCATION	OFFSET	DESCRIPTION
606+00	LT.	800'	Grilled wall

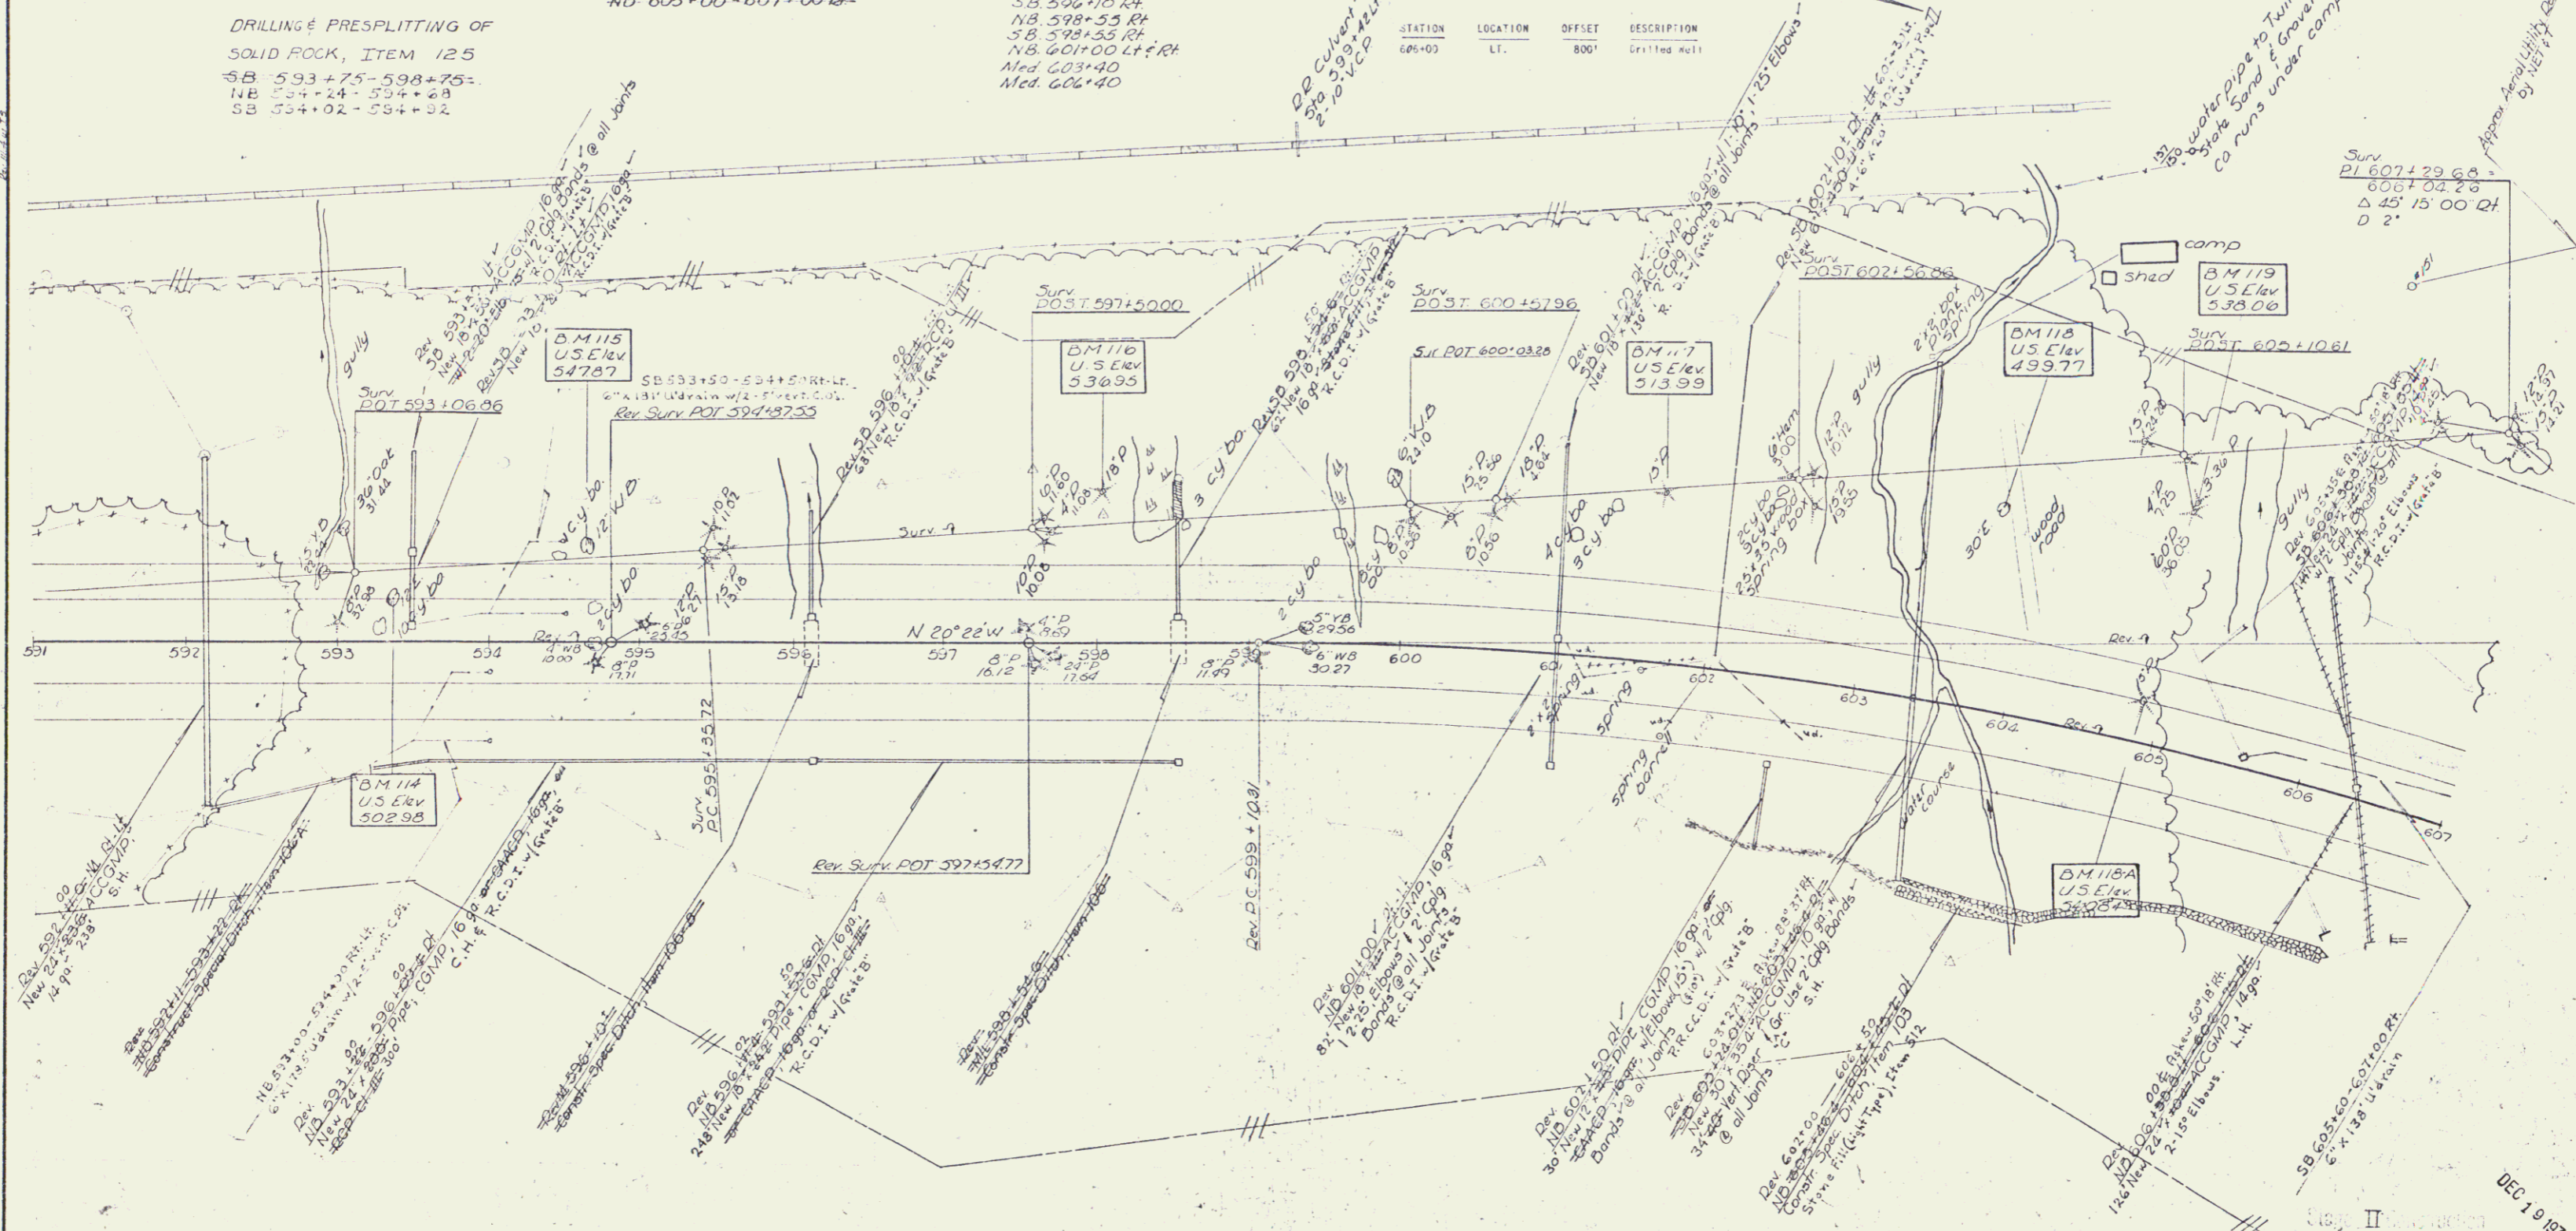

THESE DIMENSIONS SOLID ITEM 125
 SB 593+75-598+75
 NB 594+24-594+28
 SB 594+02-594+32

CONTROL OF ACCESS IS COMPLETE ON THIS SHEET

DEC 19 1973

SURVEYED BY *Jewell* DATE *8/62*
 DRAWN BY *Reichelt* DATE *8/62*
 TRACED BY *Clark* DATE *9/63*
 HARTFORD - SHARON

PROJ. NO. 89-1 (25)
 SHEET OF 25