


SODDING-ITEM 612
 NB 609+40RT
 SB 609+40RT
 NB 611+30 RT
 SB 611+30 RT
 NB 614+39 RFLT
 NB 617+00 RFLT
 NB 619+00 RFLT

* THREE CABLE GUARD RAIL/
 LIGHT STEEL POSTS ITEM 538
 NB 607+00-607+89 RT ±
 SB 607+00-623+00 LT
 DRILLING AND BLASTING
 OF SOLID ROCK SUBGRADE
 ITEM 115
 NB 607+23 TO 611+25 GO
 NB 619+25 TO 623+00-220-55
 SB 607+00-610+25 LT

* BITUMINOUS CONCRETE
 CURB ITEM 535 TYPE II
 SB 621+90-623+00 LT
 PROPERTY LINE FENCE, MOD ITEM 58316
 SB 607+00-623+00 RT
 NB 607+00-608+00 RT
 JUTE MATTING, ITEM 623
 NB 609+25-623+00 RT

STONE FILL FOR SLOPE
 PROTECTION, ITEM 512
 NB 613+00-614+35 RT
 NB 613+50-618+00 RT
 NB 617+00-618+00 RT
 NB 618+00-621+75 RT
 NB 620+50-621+75 RT
 NB 621+25-623+00 RT
 NB 621+75-622+75 RT
 NB 622+75-623+00 RT
 SB 613+50-614+35 RT
 SB 614+35-617+00 RT
 SB 617+00-618+00 RT
 SB 618+00-621+75 RT
 SB 621+75-622+75 RT
 SB 622+75-623+00 RT

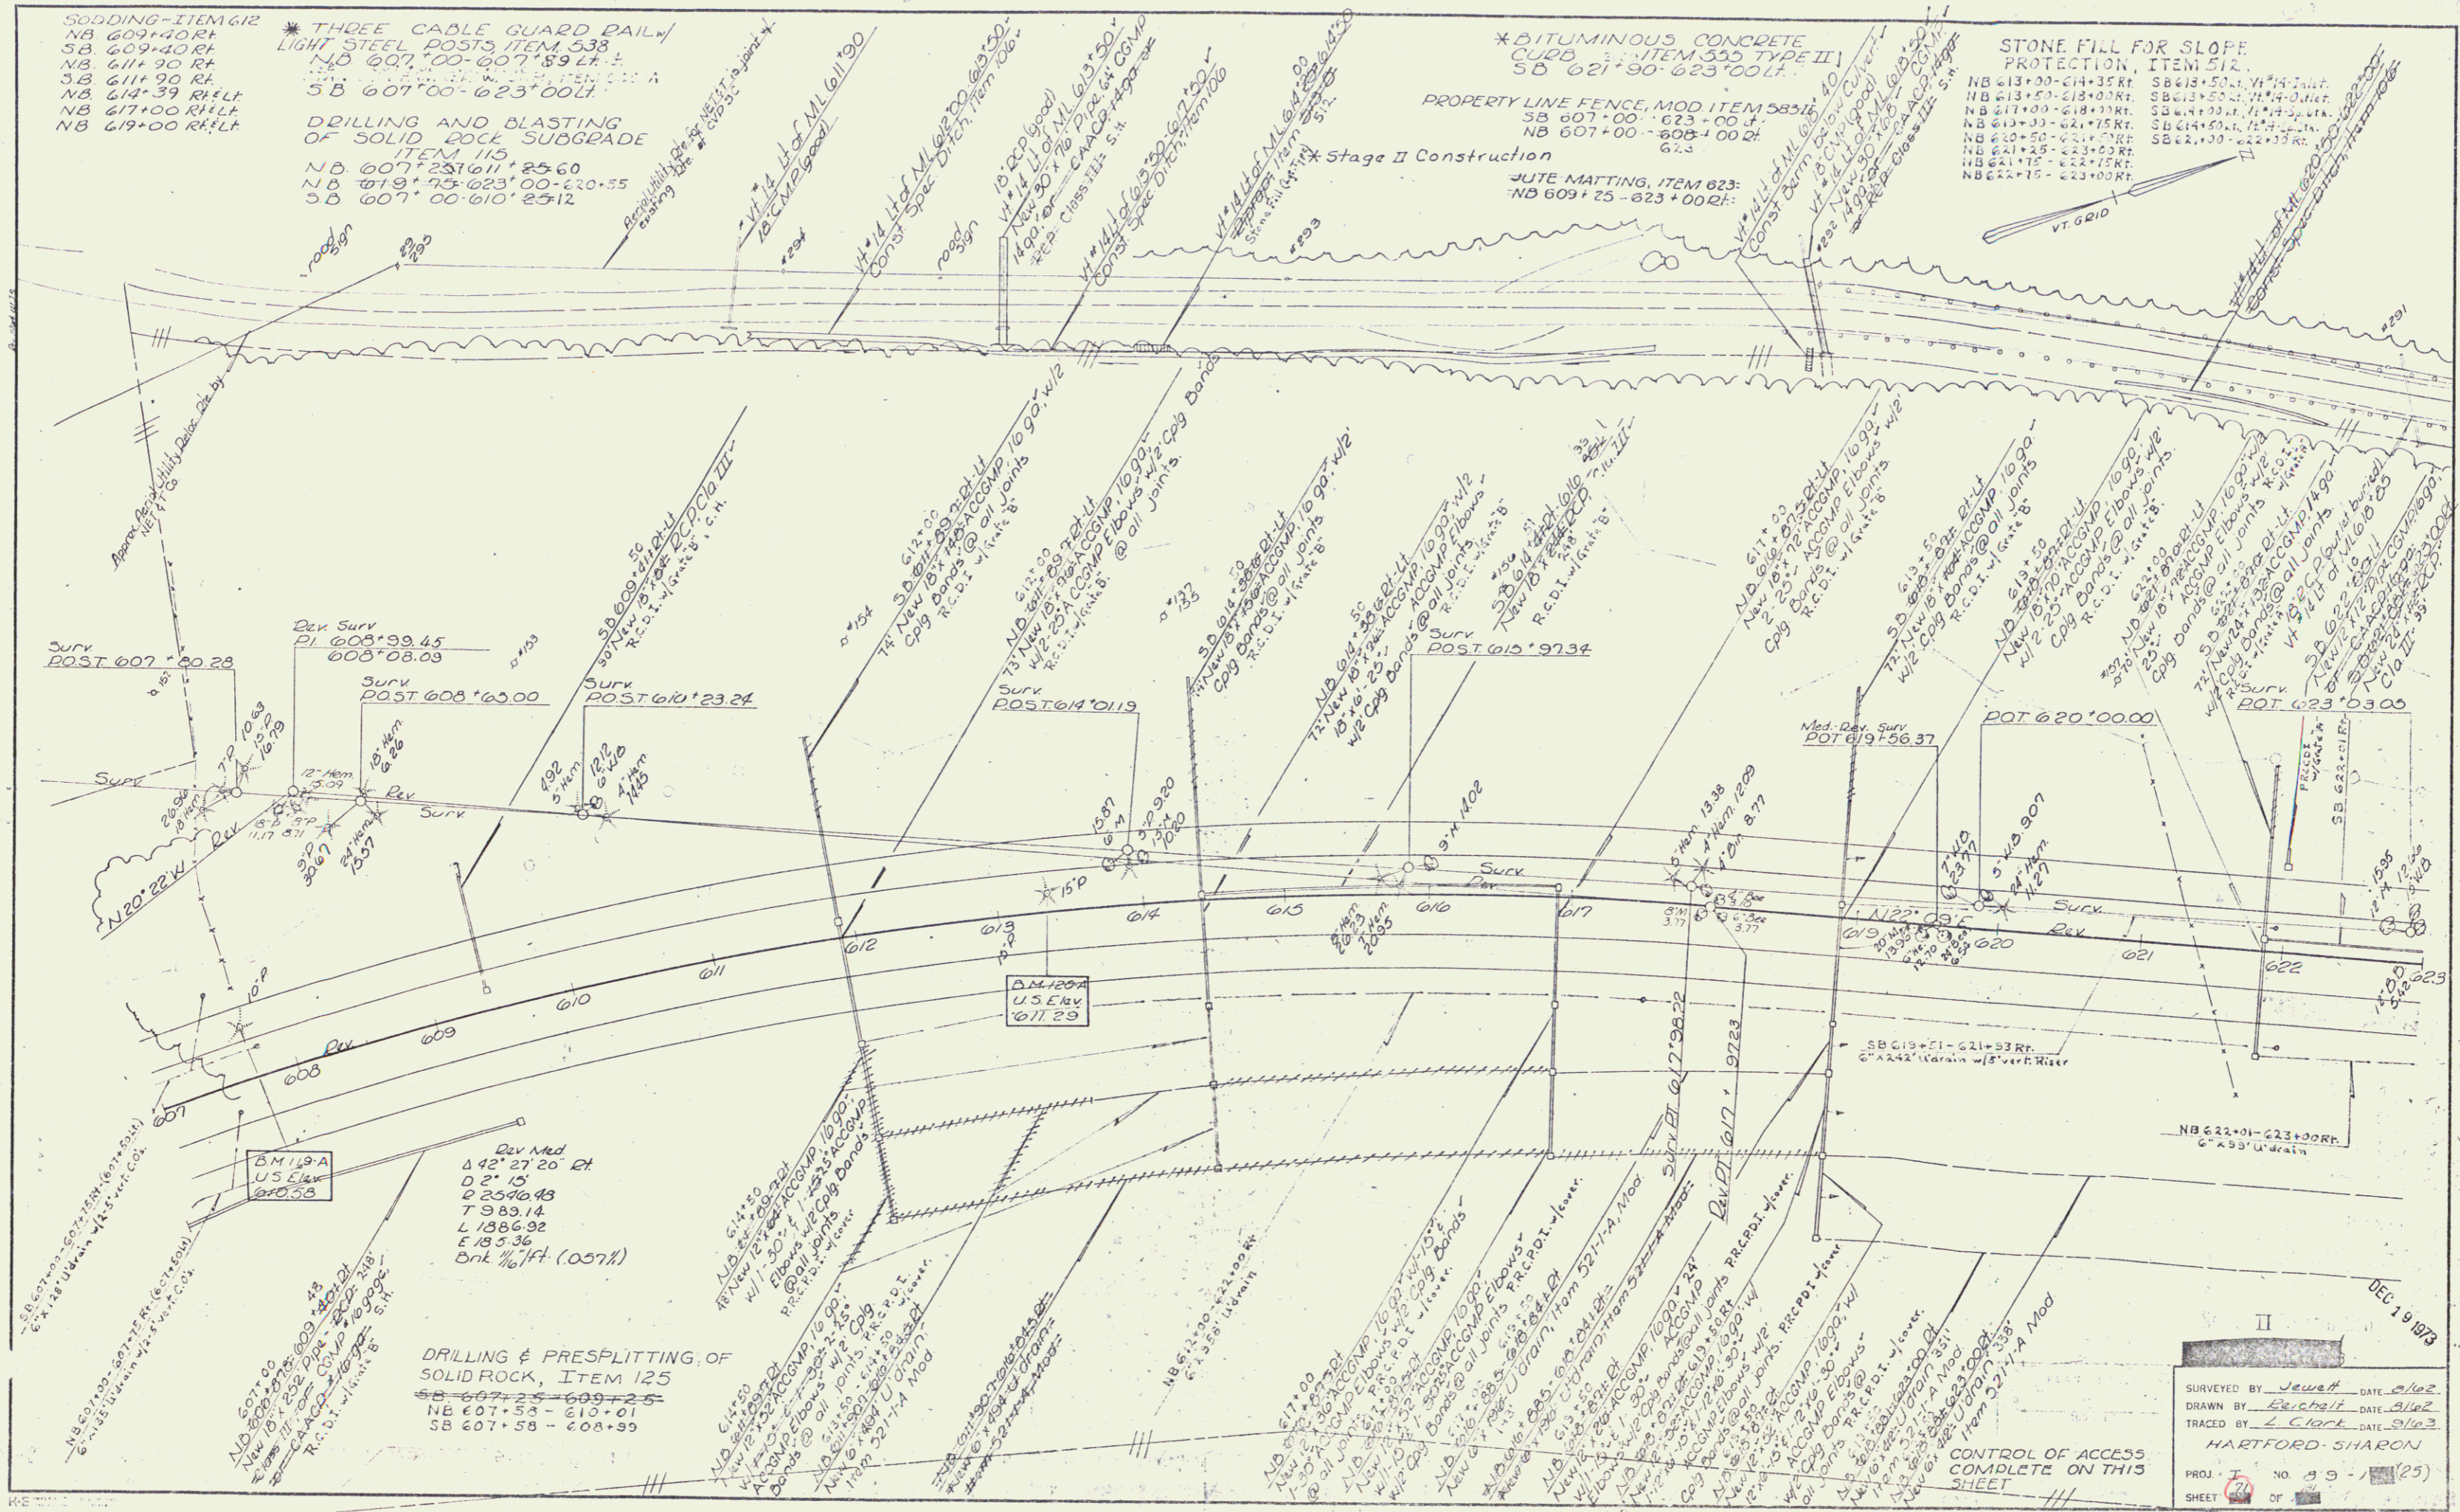

II
 SURVEYED BY Jewett DATE 8/10/2
 DRAWN BY Bechtel DATE 8/10/2
 TRACED BY L. Clark DATE 8/10/3
 HARTFORD-SHARON
 PROJ. T. NO. 99-25
 SHEET 25 OF 25
 DEC 19 1973