

THREE CABLE GUARD RAIL
ITEM 542
SB 783+00 - 783+31 Lt.
SB 783+03 - 783+91 Rt.
NB 783+87 - 784+43 Rt.
NB 787+48 - 789+00 Rt.

STANDARD STEEL BEAM GUARD RAIL
w/STEEL POSTS, ITEM 545-A
SB 783+00 Rt. - N.B. 783+54 Lt.


PROPERTY LINE FENCE w/STEEL POSTS
ITEM 583-II
SB 783+00 - 789+00 Lt.
NB 783+80 - 789+00 Rt.

12 SUB. BASE OF SAND
ITEM 202
SB 787+00 - 786+00
NB 787+00 - 786+00

BITUMINOUS CONCRETE CURB
ITEM 555
NB 787+45 - 789+00 Rt.

GRAVEL BACKFILL, ITEM 222-A
SB 786+00 - 793+25 Lt.
NB 787+25 - 792+50 Rt.

CONSTRUCT U-TURN
788+50

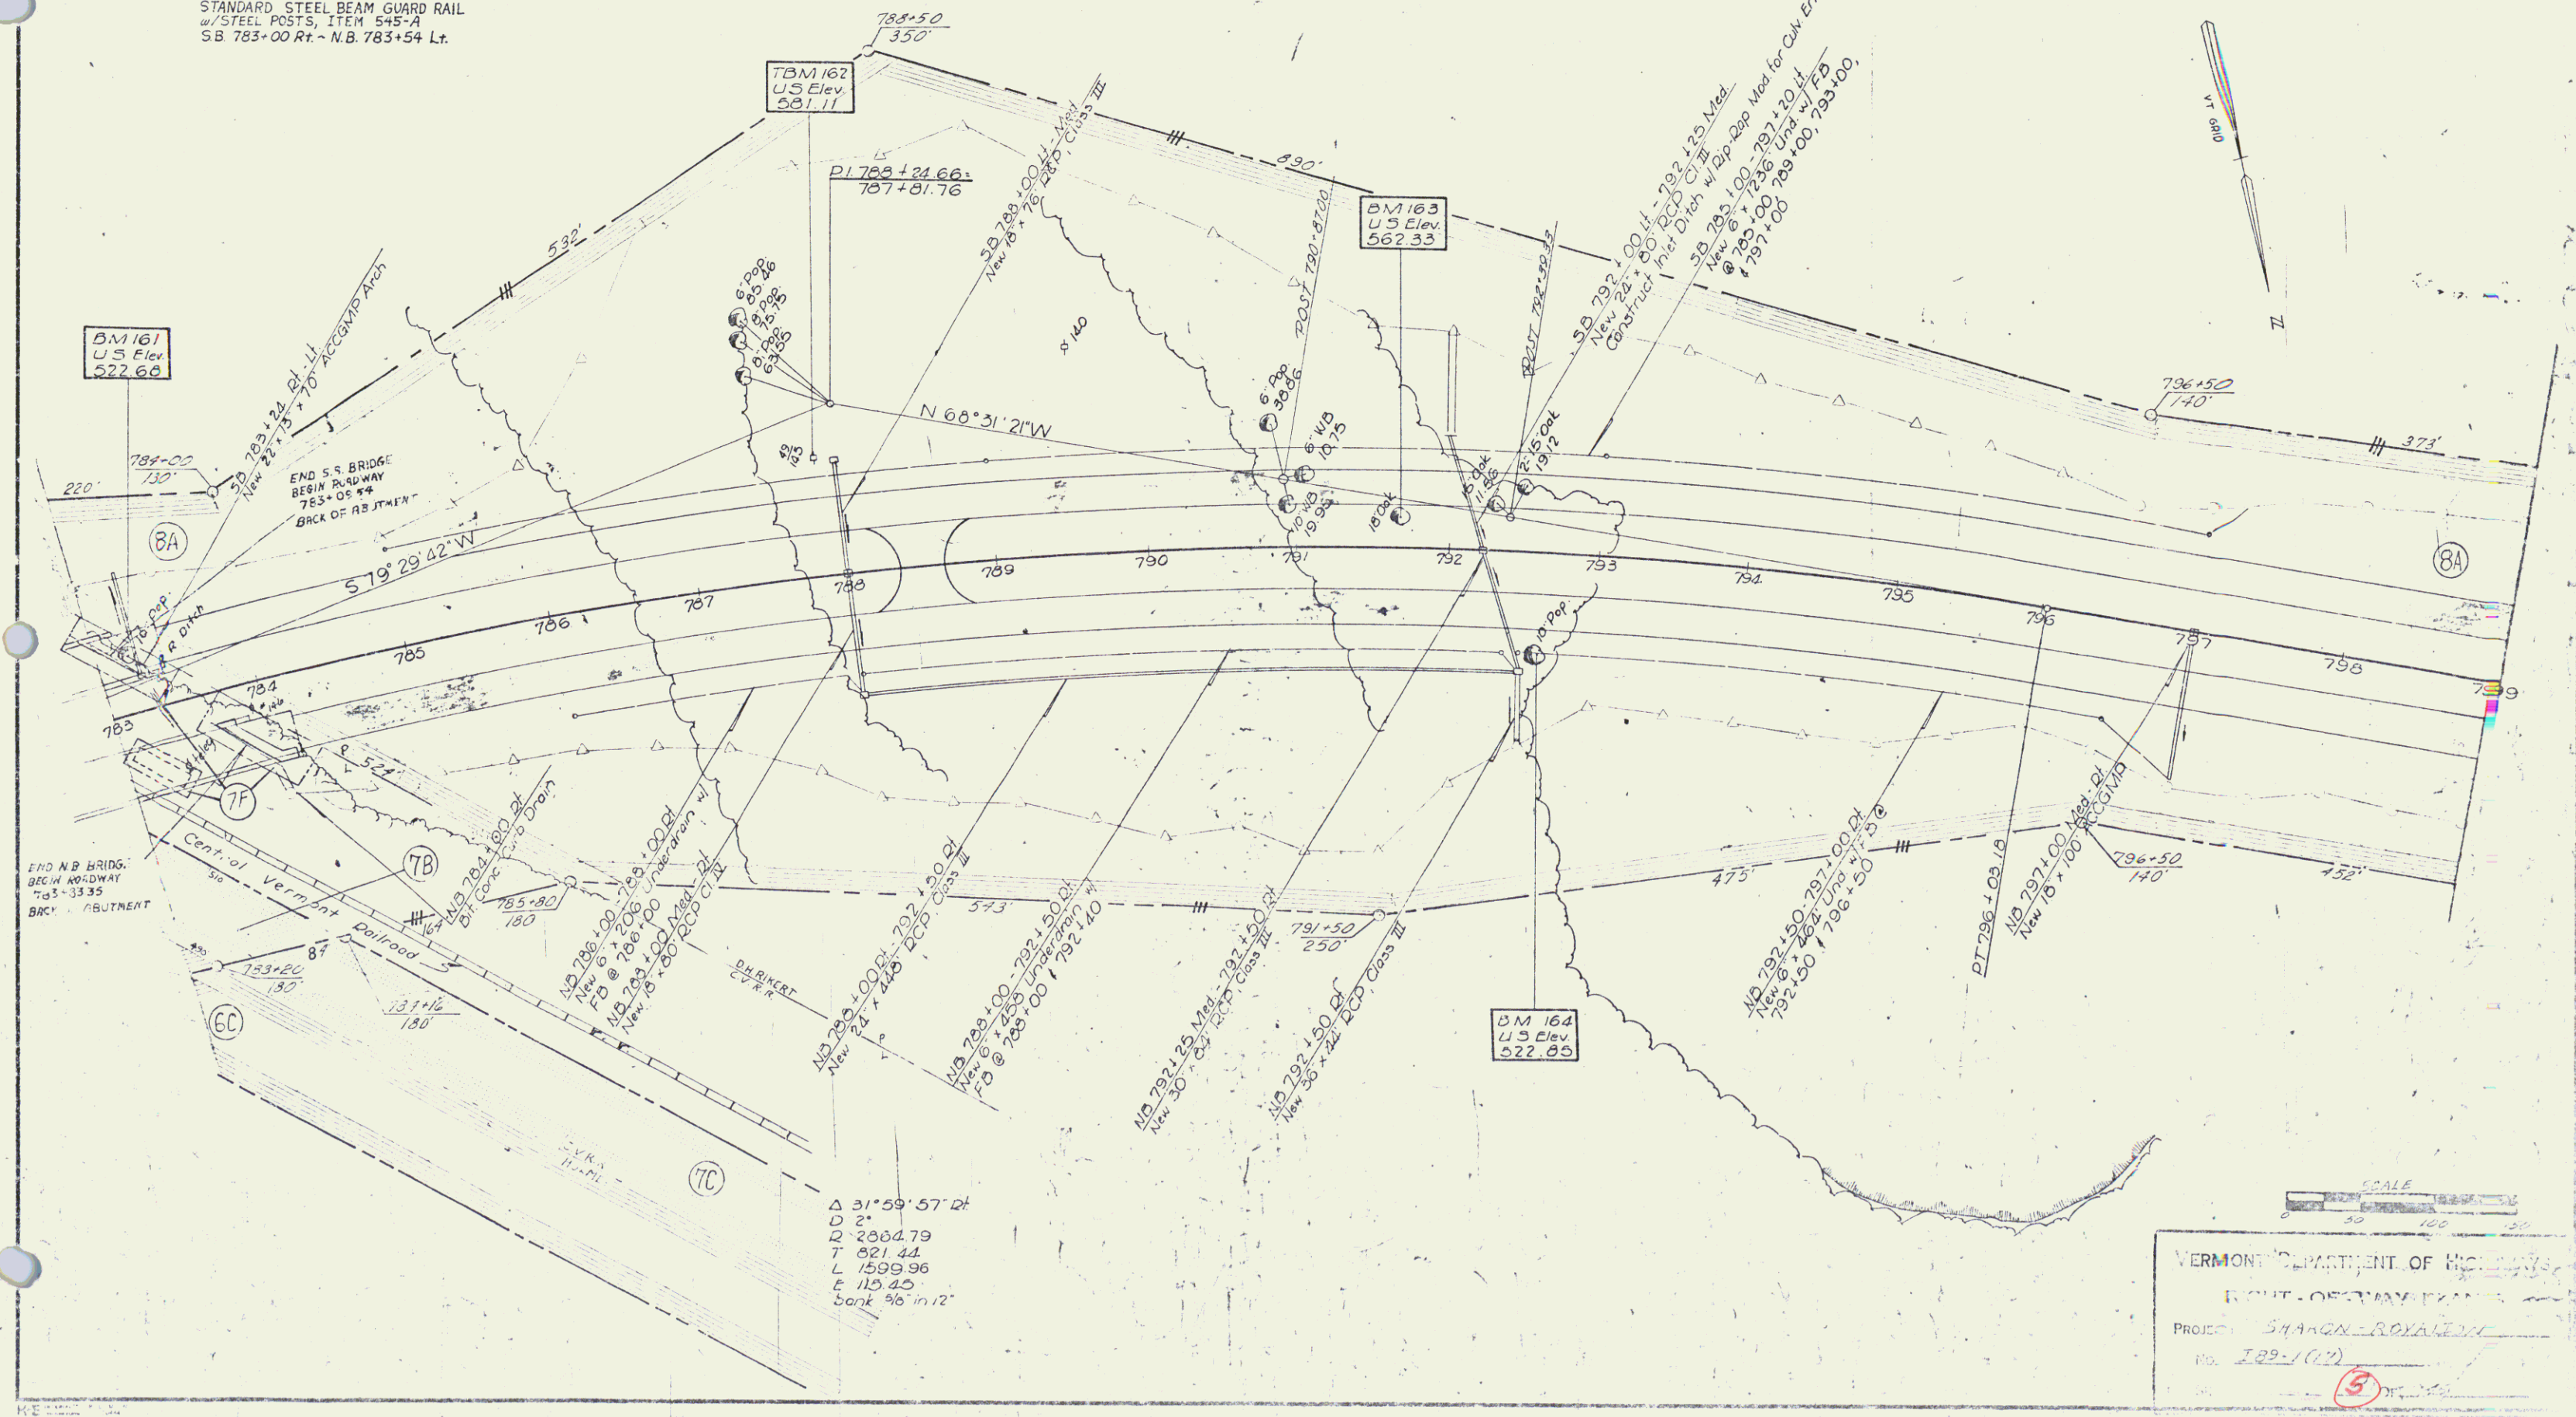

VERMONT DEPARTMENT OF HIGHWAYS
 ROUTE OF WAY PLAN
 PROJECT SHANNON-ROYALTON
 No. 129-1(12)
 SCALE
 1" = 40'