


THREE CABLE SHARD RAIL
ITEM 202
SB 911+00 - 919+02.41
NB 911+04 - 918+08.01

BITUMINOUS CONCRETE CURB
ITEM 205
SB 911+00 - 919+02.41
NB 911+04 - 918+08.01

DRILLING & BLASTING OF SOLID
ROCK SUBGRADE, ITEM 115
NB 925+30 - 927+00

PROPERTY LINE FENCE WITH STEEL POSTS
ITEM 505 II
NB 912+00 - 920+00 RI

12" SUBBASE OF SAND
ITEM 202
SB 924+50 - 927+00

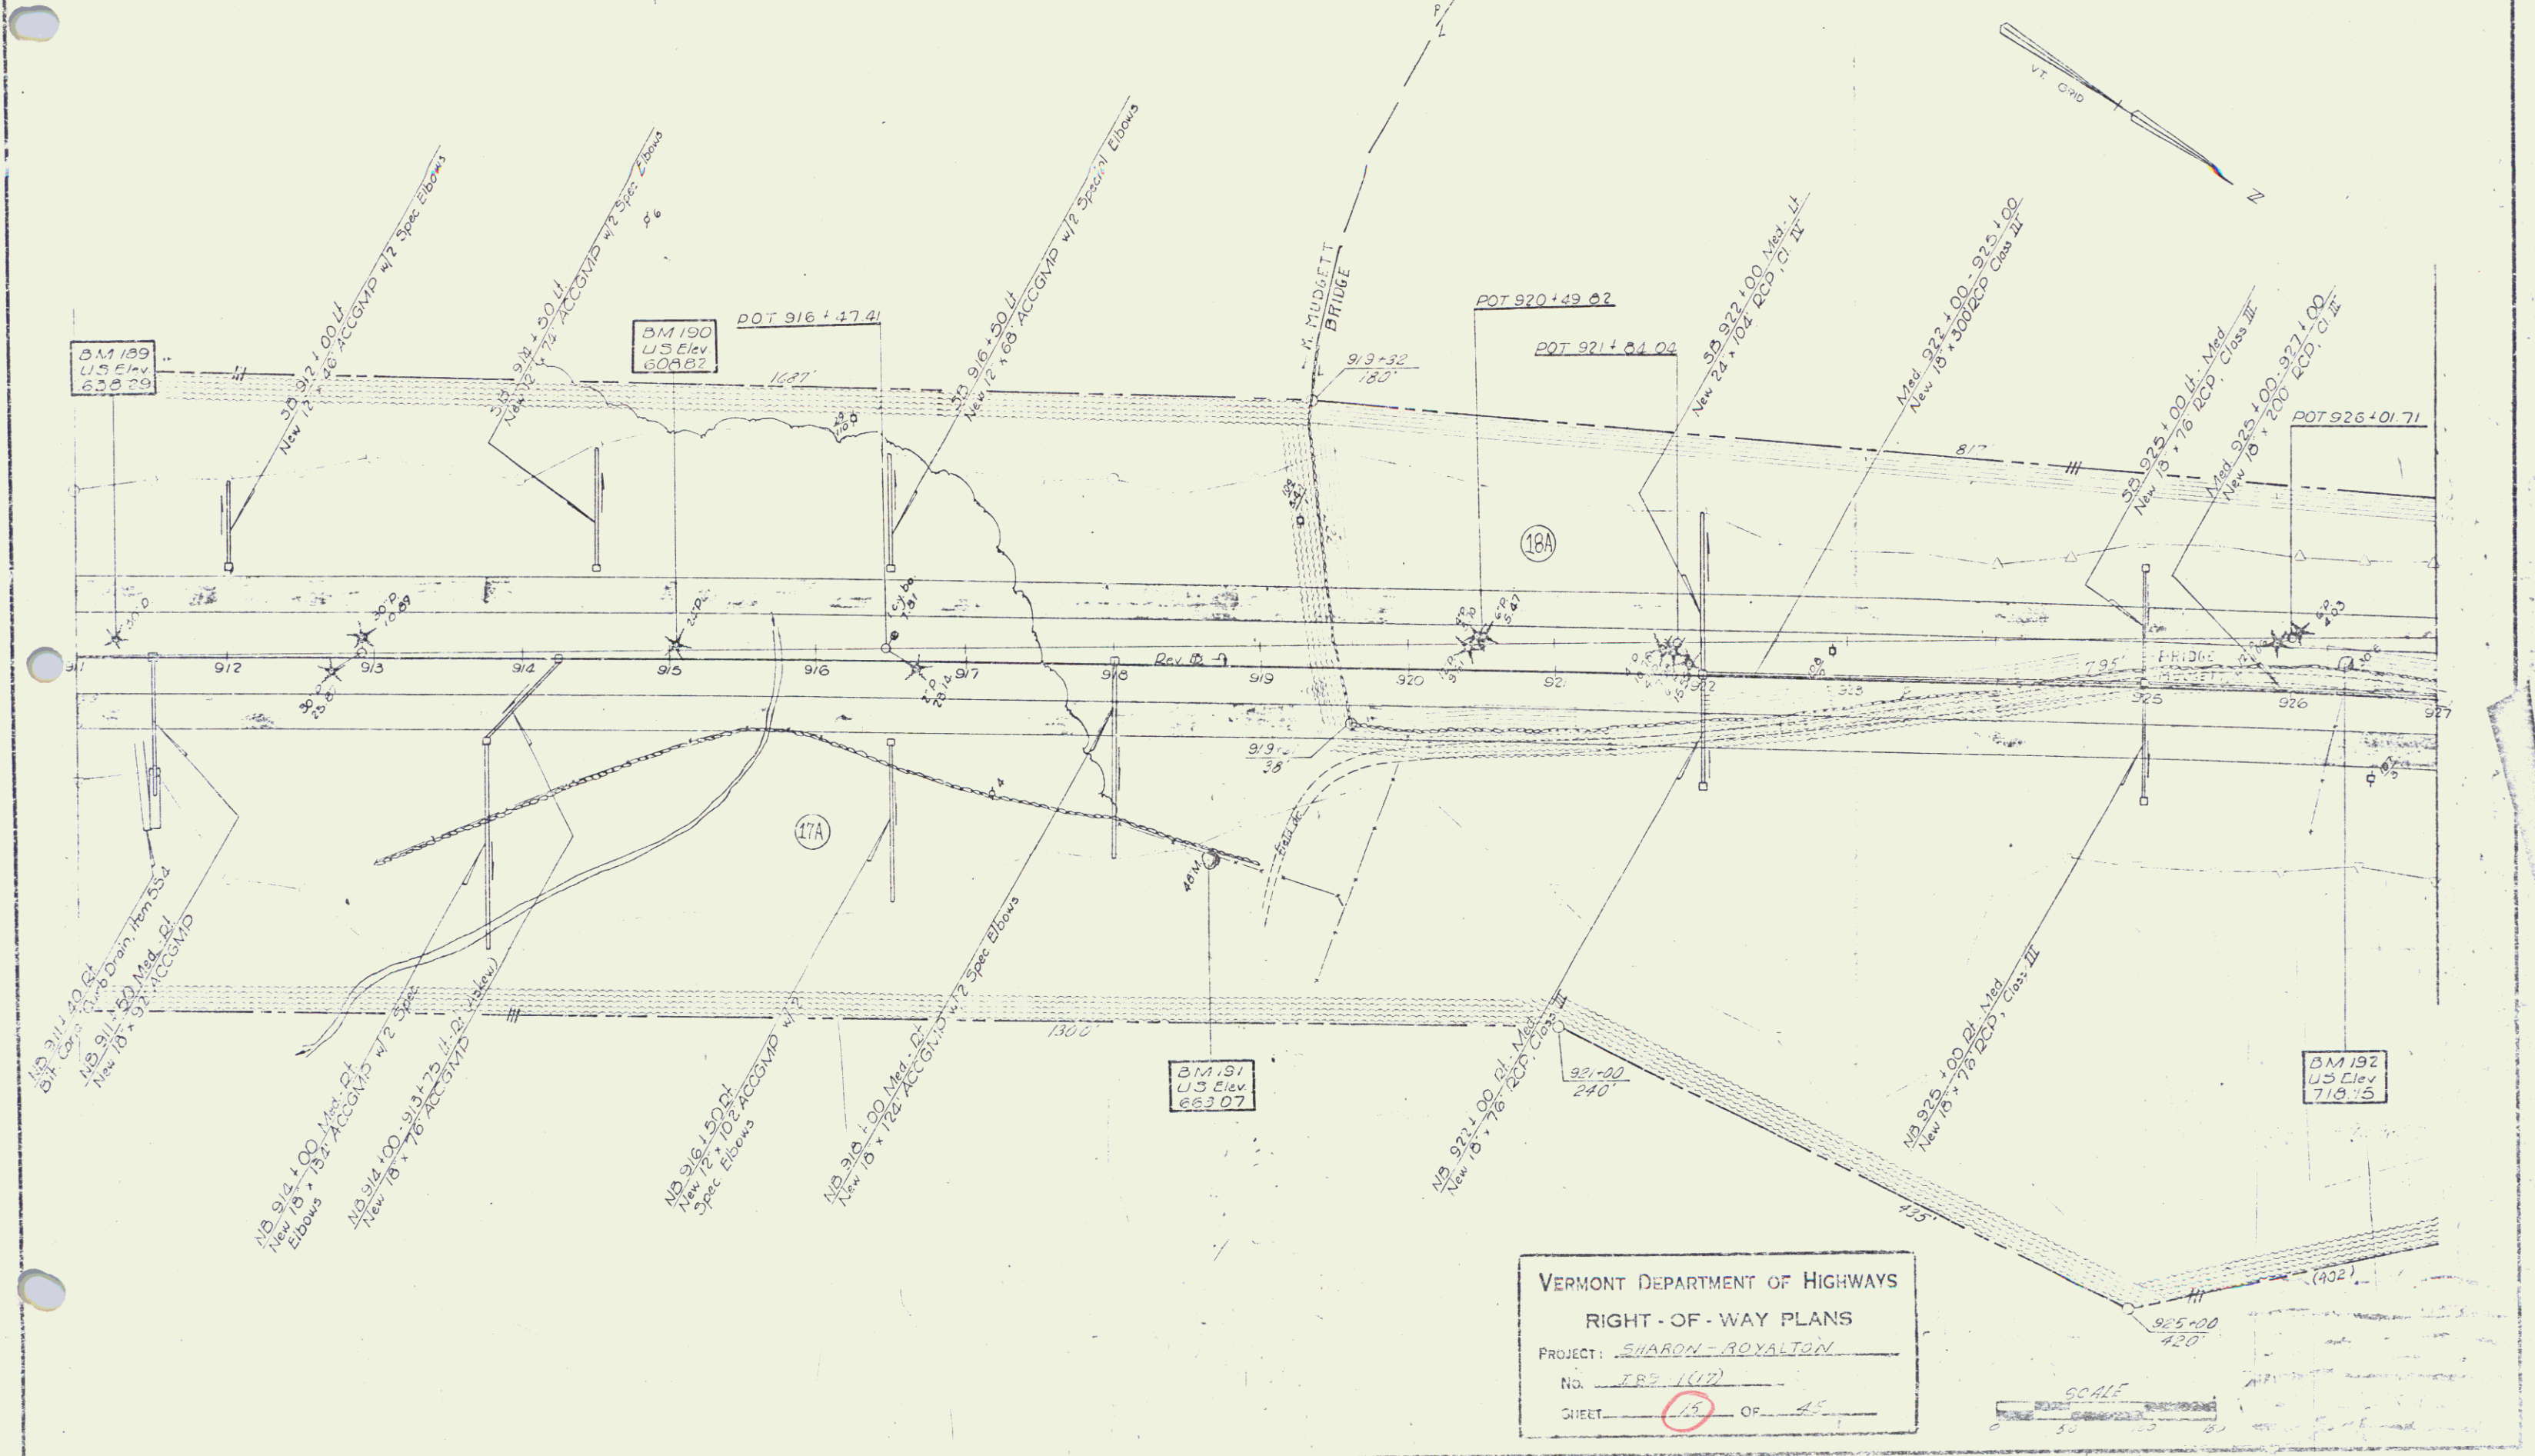

VERMONT DEPARTMENT OF HIGHWAYS
RIGHT-OF-WAY PLANS
PROJECT: SHARON-ROYALTON
NO. 185-1(17)
SHEET 17 OF 45

