


PROPERTY LINE FENCE W/ STEEL POSTS
ITEM 583 B
NB 1033+00 - 1033+00 DI

DRILLING & BLASTING OF SOLID ROCK
SUBGRADE, ITEM 533 B
1033+00 - 1051+25
1053+25 - 1055+00

STANDARD STEEL BEAM GUARD RAIL
W/ STEEL POSTS, ITEM 545-A
NB 1055+92 - 1063+90 DI

2" TURNING CONTRACTS CURB
ITEM 565
NB 1063+00 - 1064+00 DI

THREE CABLE GUARD RAIL
STEEL POSTS, ITEM 542
NB 1063+00 - 1064+00 DI
SB 1063+00 - 1055+00 DI

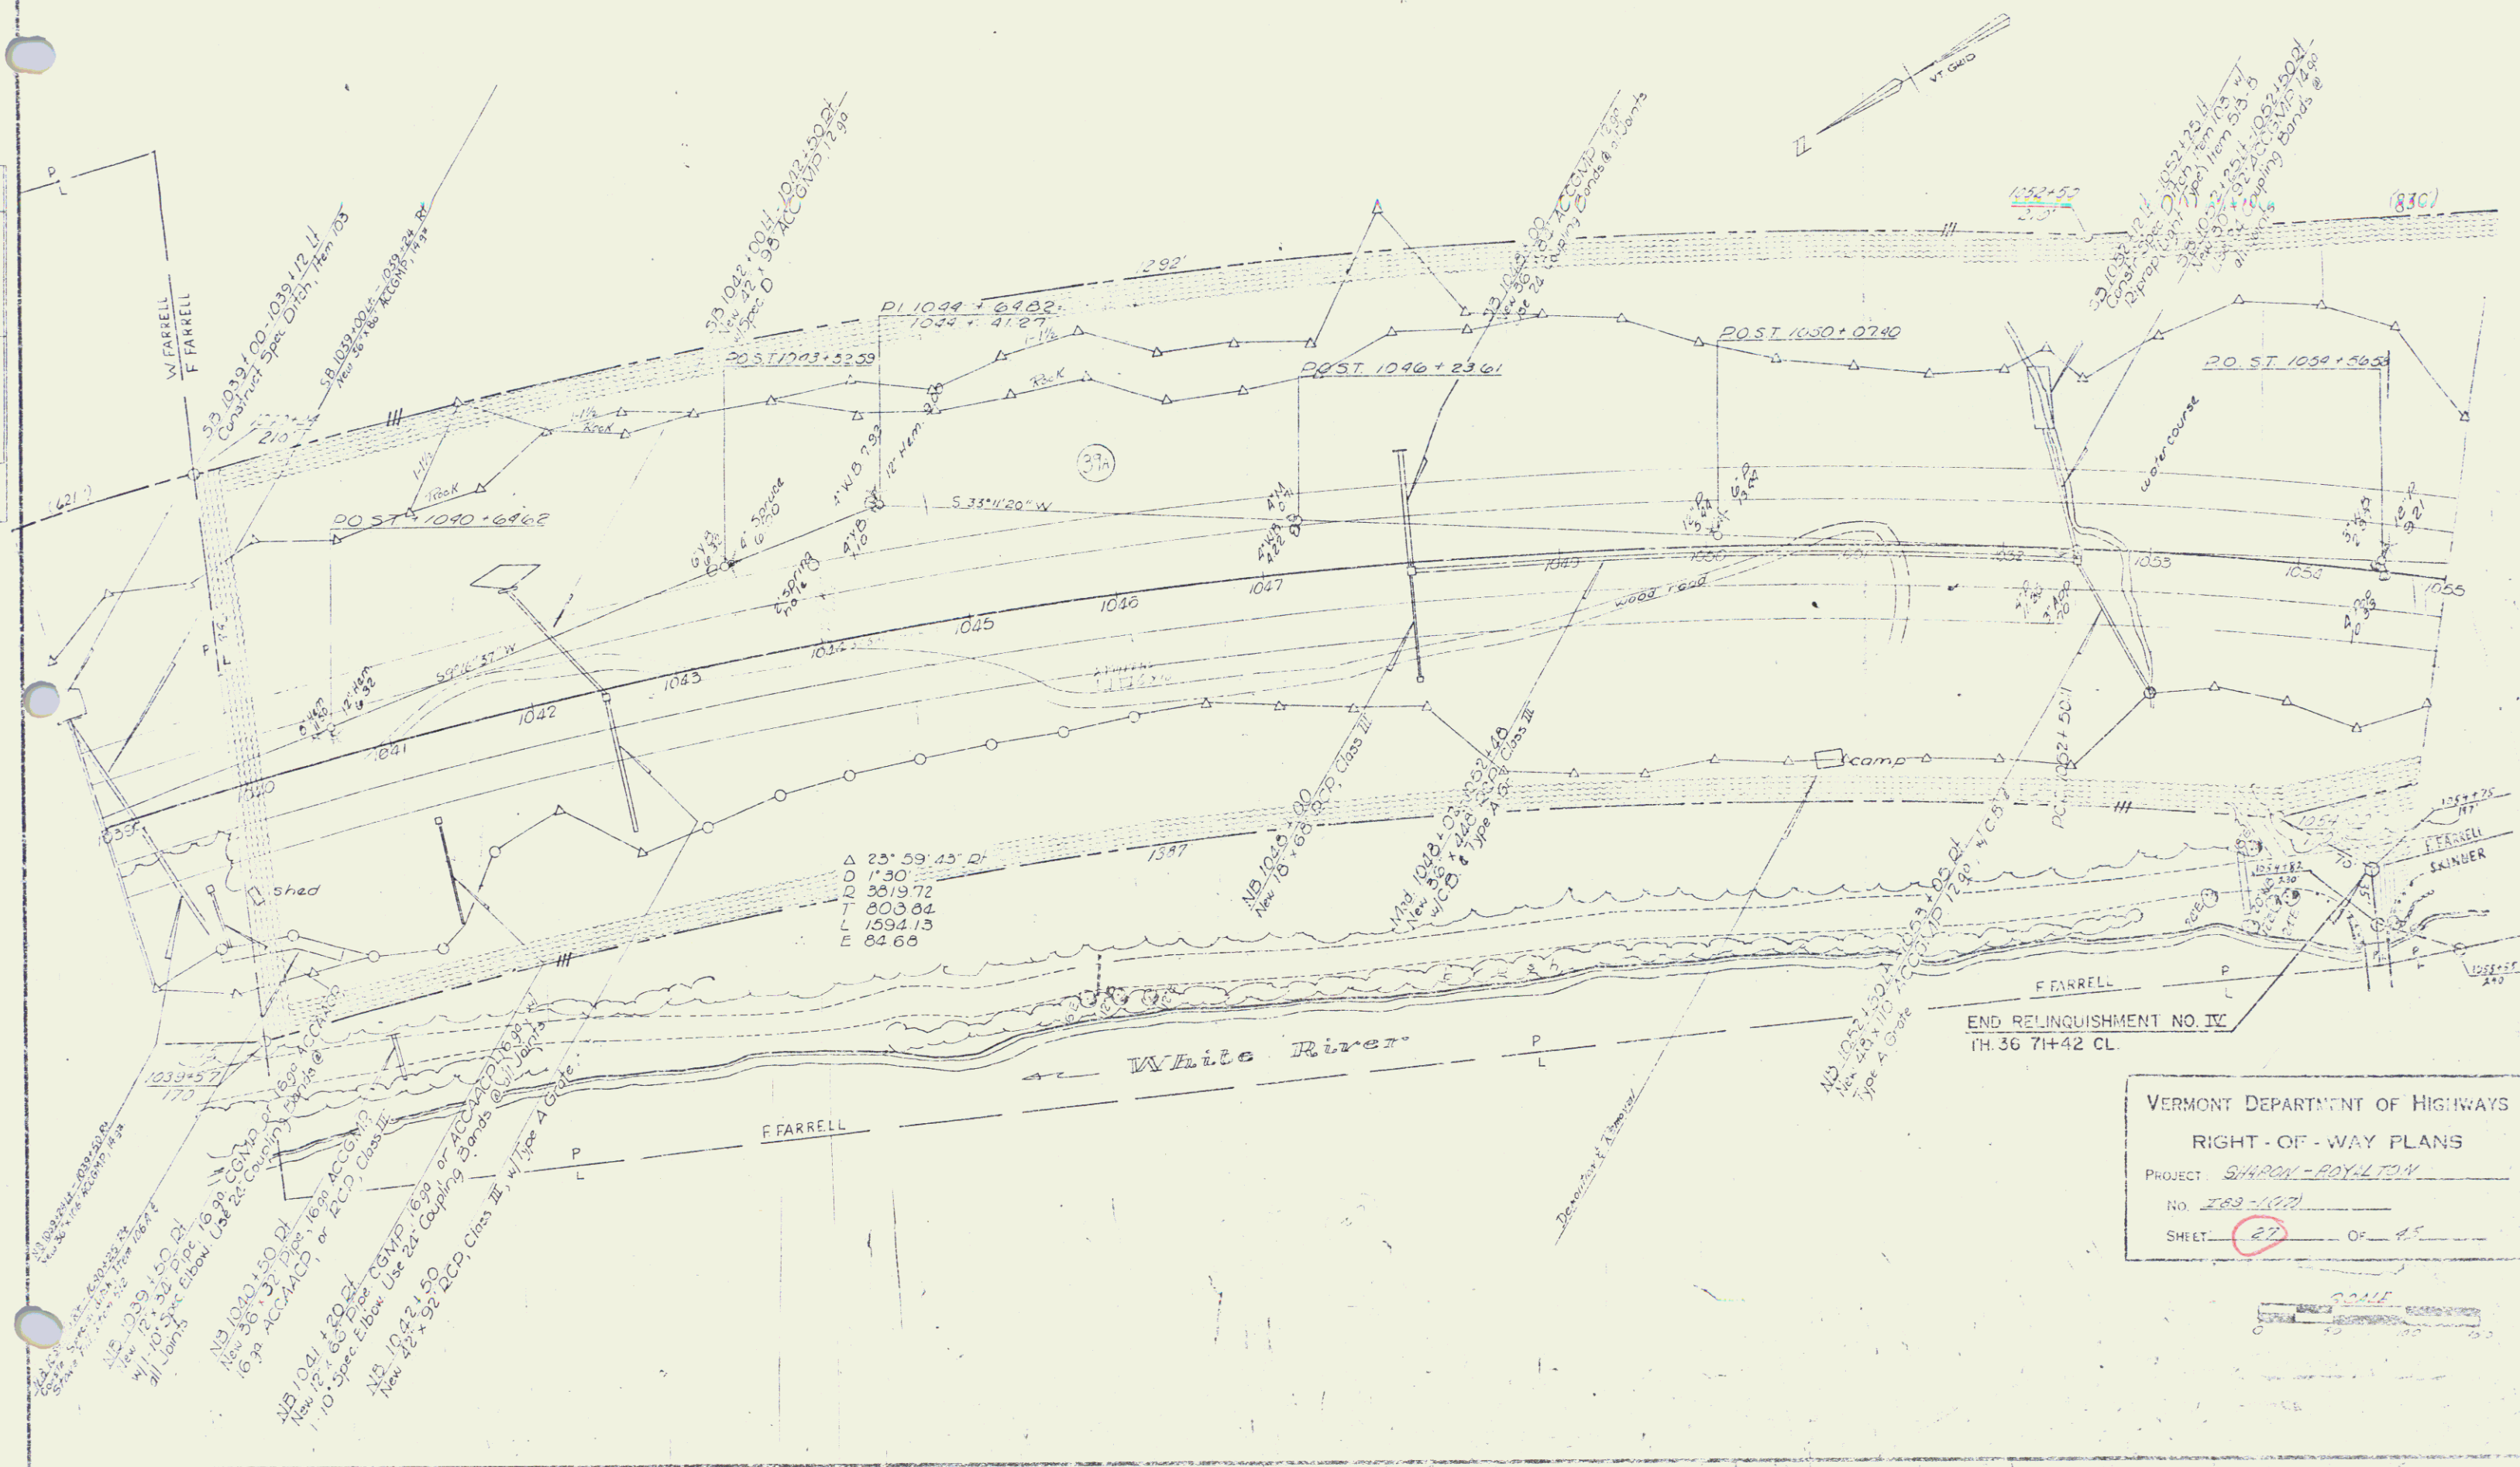

VERMONT DEPARTMENT OF HIGHWAYS
RIGHT-OF-WAY PLANS
PROJECT: SHARON-ROYLTON
NO. 183-1107
SHEET: 27 OF 45

