

DRILLING & BLASTING OF SOLID ROCK
SUBGRADE, ITEM 115
NB 1106+75 - 1107+25


PROPERTY LINE FENCE W/STEEL POSTS
ITEM 563.11
SB 1103+00 - 1113+00 Lt
NB 1103+00 - 1111+00 Rt.

BITUMINOUS CONCRETE SURFACE FOR
GUTTER, ITEM 554
NB 1112+60 Rt.

JUTE MATTING, ITEM 623
NB 1110+25 - 1112+25 Lt

BITUMINOUS CONCRETE CURBS, ITEM 555
NB 1110+00 - 1112+60 Rt
SB 1112+25 - 1115+75 Lt

THREE CABLE GUARD RAIL WITH
STEEL POSTS, ITEM 542
NB 1110+00 - 1112+72 Rt
SB 1112+50 - 1115+36 Lt

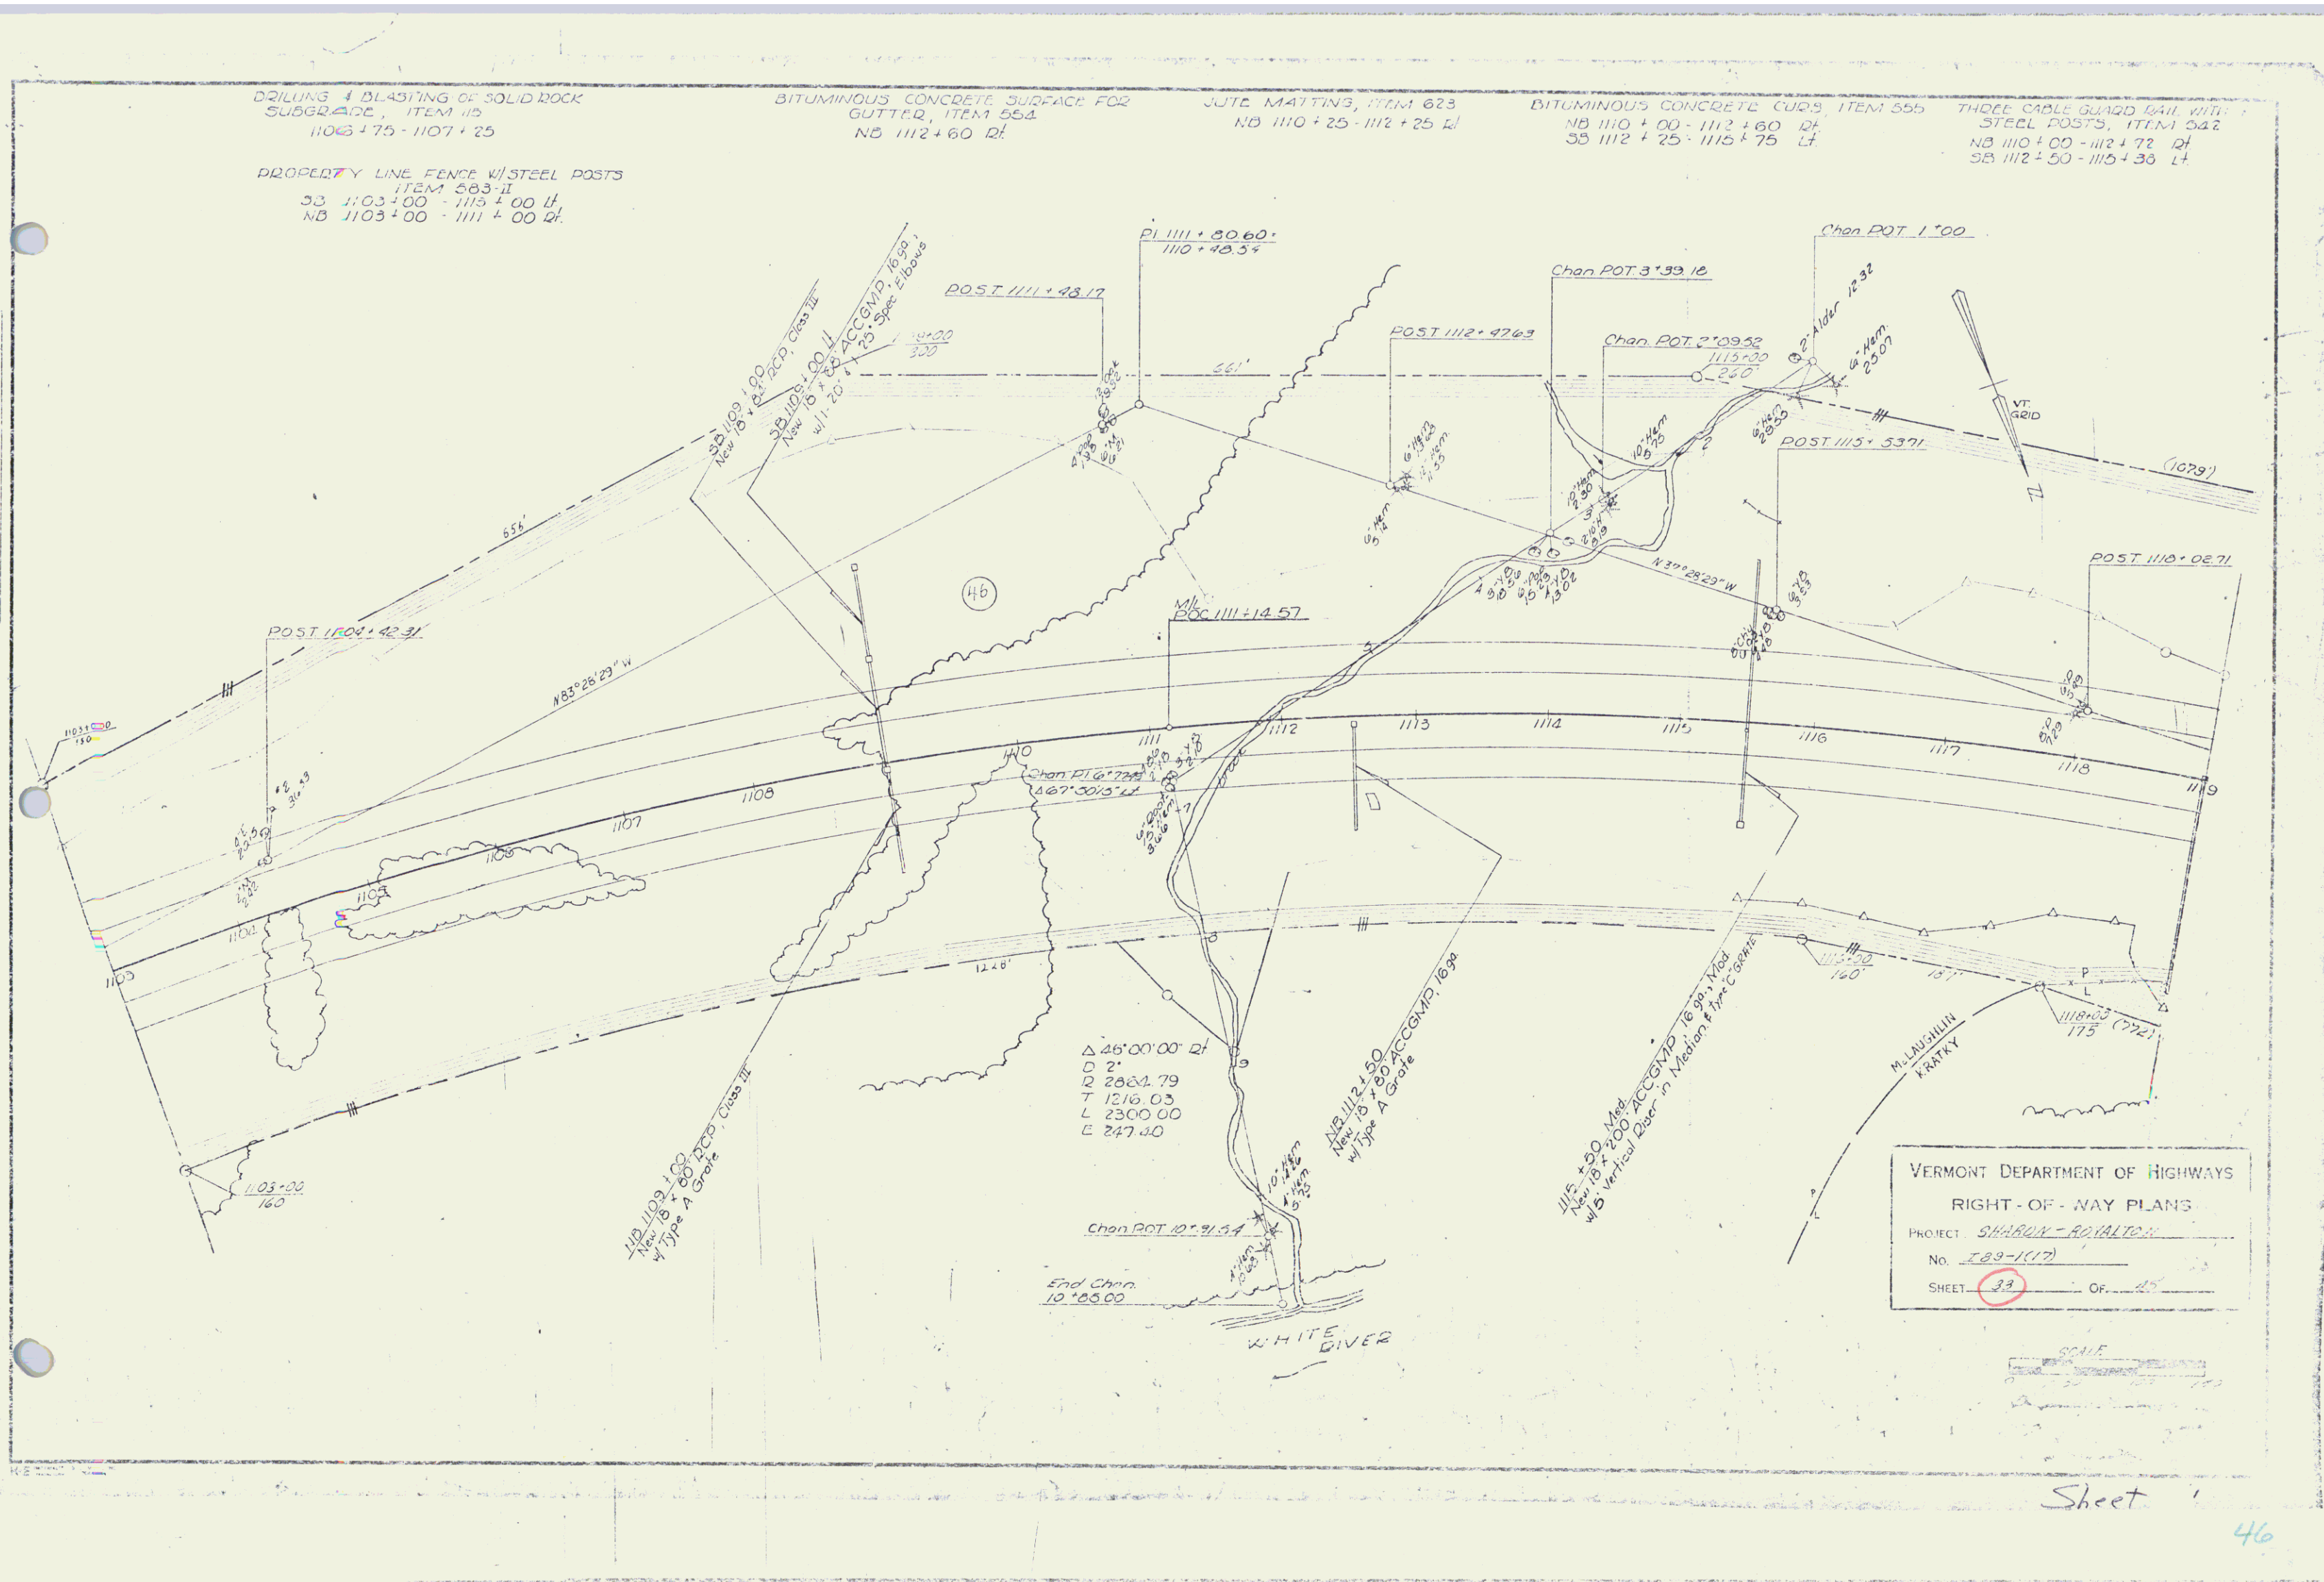

Sheet 33
46